

CORRECTION(S) TO WATER WELL RECORD (WWC-5)

(to rectify lacking or incorrect information)

County: Wyandotte

Location listed as:

Location changed to:

Section-Township-Range: 22-50N-33W

35-10S-25E

Fraction (1/4 1/4 1/4): NW NW SW

W2 E2 W2 SW

Other changes: Initial statements: _____

Changed to: _____

Comments: _____

verification method: Map of well locations from owner, and
North Kansas City 1:24,000 topo. map.

initials: ORL date: 9/15/2005

submitted by: Kansas Geological Survey, Data Resources Library, 1930 Constant Ave., Lawrence, KS 66047-3726
to: Kansas Dept of Health & Environment, Bureau of Water, 1000 SW Jackson, Suite 420, Topeka, KS 66612-1367.




PROJECT NUMBER 321564.SI.01	BORING NUMBER MW-302S	SHEET 1 OF 1
SOIL BORING LOG		

PROJECT : Conoco Phillips - Supplemental SI	NORTHING: 308980.13 EASTING: 2276401.93
ELEVATION : 747.54 ft b.t.o.c.	DRILLING CONTRACTOR : Max's Enterprises Inc.
DRILLING METHOD AND EQUIPMENT USED : CME 750 ATV, HSA	LOGGER : C. Morris
WATER LEVELS :	START : 10/27/04 1340 END : 10/27/04 1405

DEPTH BELOW SURFACE (FT)	INTERVAL (FT)	RECOVERY (FT)	#/TYPE	STANDARD	SOIL DESCRIPTION	COMMENTS
				PENETRATION		
				TEST RESULTS		
				6"-6"-6" (N)	SOIL NAME, USCS GROUP SYMBOL, COLOR, MOISTURE CONTENT, RELATIVE DENSITY, OR CONSISTENCY, SOIL STRUCTURE, MINERALOGY.	DEPTH OF CASING, DRILLING RATE, DRILLING FLUID LOSS, TESTS, AND INSTRUMENTATION. Notes
	No Soil Sampling				0.0': Fill- silt, sand and gravel, dark gray, moist	
5					2.0': Silty clay (CL), dark gray, moist, soft, medium plasticity, HC odor	
10					8.0': Sandy silt (ML) gray, fine, slight odor	
15					10.0': Sandy silty clay (CL), brown to gray, moist, medium plasticity, soft, slight HC odor	
20					15.0': Silty sand (SM), gray, moist, fine, slight odor	
25					19.0': Sand (SP), light gray, moist, fine, slight odor	
35					28.0': Sand (SP), dark gray, fine to medium, grading coarser, no odor	
					31.0': Grading more moist	
					35.0': End of boring	

R25E

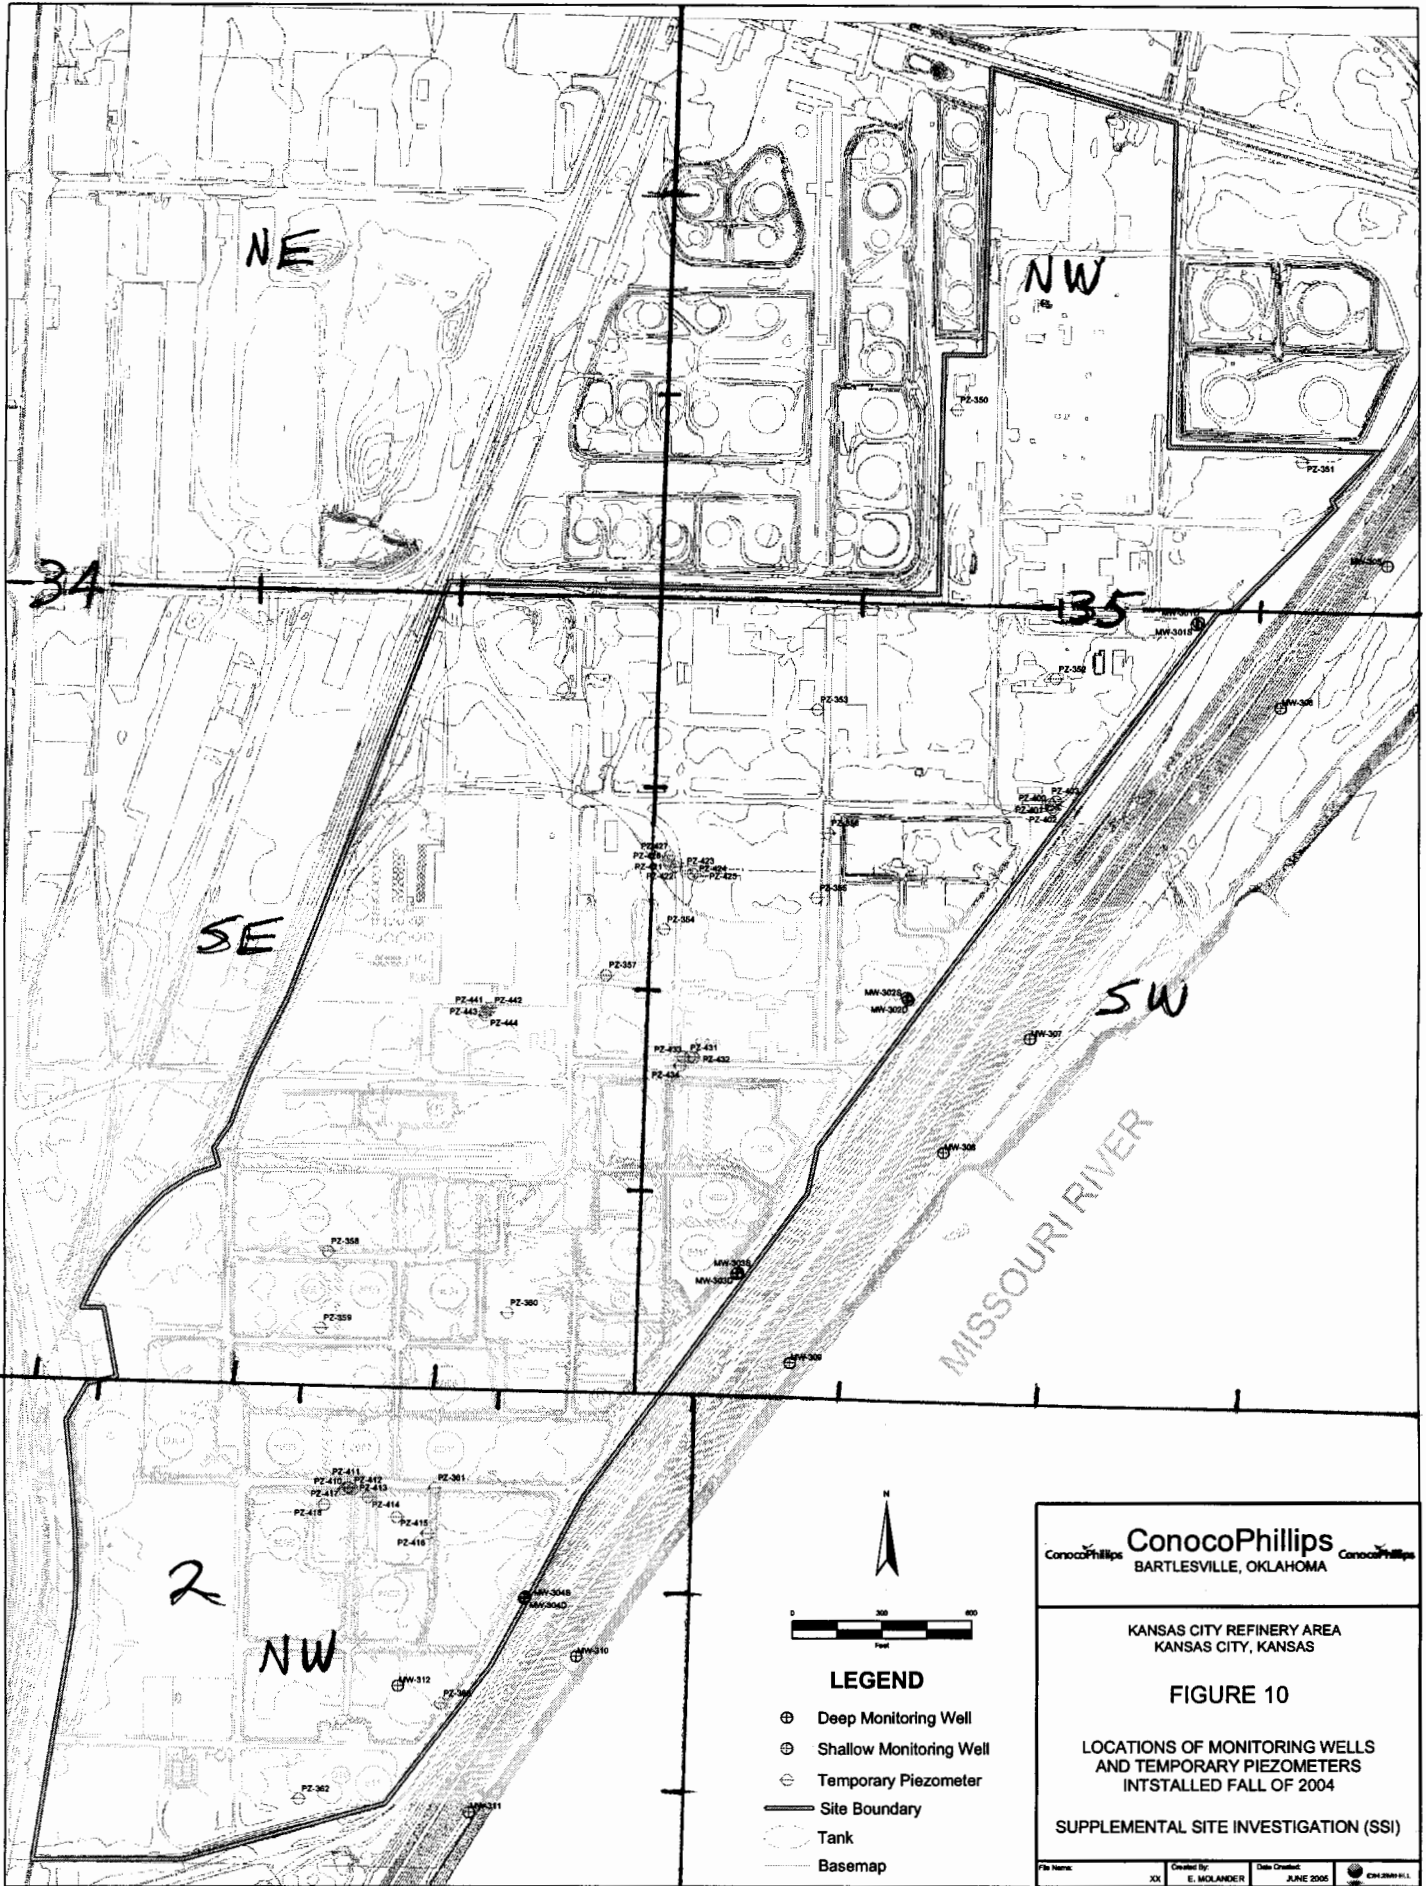

T10S
T11S
N. KC
- KC

2

R26E

ConocoPhillips
BARTLESVILLE, OKLAHOMA

KANSAS CITY REFINERY AREA
KANSAS CITY, KANSAS

FIGURE 10

LOCATIONS OF MONITORING WELLS
AND TEMPORARY PIEZOMETERS
INSTALLED FALL OF 2004

SUPPLEMENTAL SITE INVESTIGATION (SSI)

File Name: XX Date Created: E. MOLANDER JUNE 2005