

CORRECTION(S) TO WATER WELL RECORD (WWC-5)

(to rectify lacking or incorrect information)

County: Wyandotte

Location listed as:

Section-Township-Range: 22-50N-33W

Fraction (  $\frac{1}{4}$   $\frac{1}{4}$   $\frac{1}{4}$ ): NW SW C

Location changed to:

35-10S-25E

C N2 SW

Other changes: Initial statements: \_\_\_\_\_

Changed to: \_\_\_\_\_

Comments: \_\_\_\_\_

verification method: Map of well locations from owner, and

North Kansas City 1:24,000 topo. map.

initials: DR date: 9/8/2005

submitted by: Kansas Geological Survey, Data Resources Library, 1930 Constant Ave., Lawrence, KS 66047-3726  
to: Kansas Dept of Health & Environment, Bureau of Water, 1000 SW Jackson, Suite 420, Topeka, KS 66612-1367.






PROJECT NUMBER 321564.SI.01	BORING NUMBER PZ-400	SHEET 1 OF 1
<b>SOIL BORING LOG</b>		

PROJECT : Conoco Phillips - Supplemental SI	NORTHING: 309653.78	EASTING: 2276844.53
ELEVATION : 748.14 ft b.t.o.c.	DRILLING CONTRACTOR : Max's Enterprises Inc.	
DRILLING METHOD AND EQUIPMENT USED : Mobile B57, HSA	LOGGER : E. Molander	
WATER LEVELS : 19.5' bgs	START : 10/28/04 1330	END : 10/28/04 1355

DEPTH BELOW SURFACE (FT)	INTERVAL (FT)		STANDARD PENETRATION TEST RESULTS 6"-6"-6" (N)	SOIL DESCRIPTION SOIL NAME, USCS GROUP SYMBOL, COLOR, MOISTURE CONTENT, RELATIVE DENSITY, OR CONSISTENCY, SOIL STRUCTURE, MINERALOGY.	COMMENTS DEPTH OF CASING, DRILLING RATE, DRILLING FLUID LOSS, TESTS, AND INSTRUMENTATION.  Notes
	RECOVERY (FT)	#/TYPE			
0				0.0': Clayey silt with gravel (MH), brown, moist, concrete and sand present	
3				3.0': Poorly graded sand with clay (SP-SC), brown, moist	
5				5.0': Silty sand (SM), brown, moist, trace gravel, fill	
7				7.0': Poorly graded sand (SP), brown, moist, fine to medium	
8.5				8.5': Silty clay (CL), dark gray, moist, slight odor, plastic	
9.0-9.5				9.0'-9.5': Clayey silt (MH), moist, plastic, no odor	
10					
12.5				12.5': Silty sand (SM), gray, moist	
14.0				14.0': Poorly graded sand (SP), gray, moist, fine to medium, HC odor	
15.0				15.0': Poorly graded sand (SP), dark gray, moist, fine to medium, strong HC odor	
17.0				17.0': Silty sand (SM), dark gray, moist, strong odor	
19.0				19.0': Sand with clay and silt (SM-SC), moist, fine	
20.0				20.0': Gray, wet, odor, sheen	
22.0				22.0': Silty sand (SM), gray, wet, fine, odor, sheen	
24.0				24.0': Poorly graded sand (SP), very wet, fine, (muddy) sheen	
25					
29.0				29.0': Poorly graded sand (SP-SM), dark gray, wet (sticky), slight odor	
34.0				34.0': Poorly graded sand (SP), dark gray, wet slurry, slight odor; End of boring	
35					

R 25 E

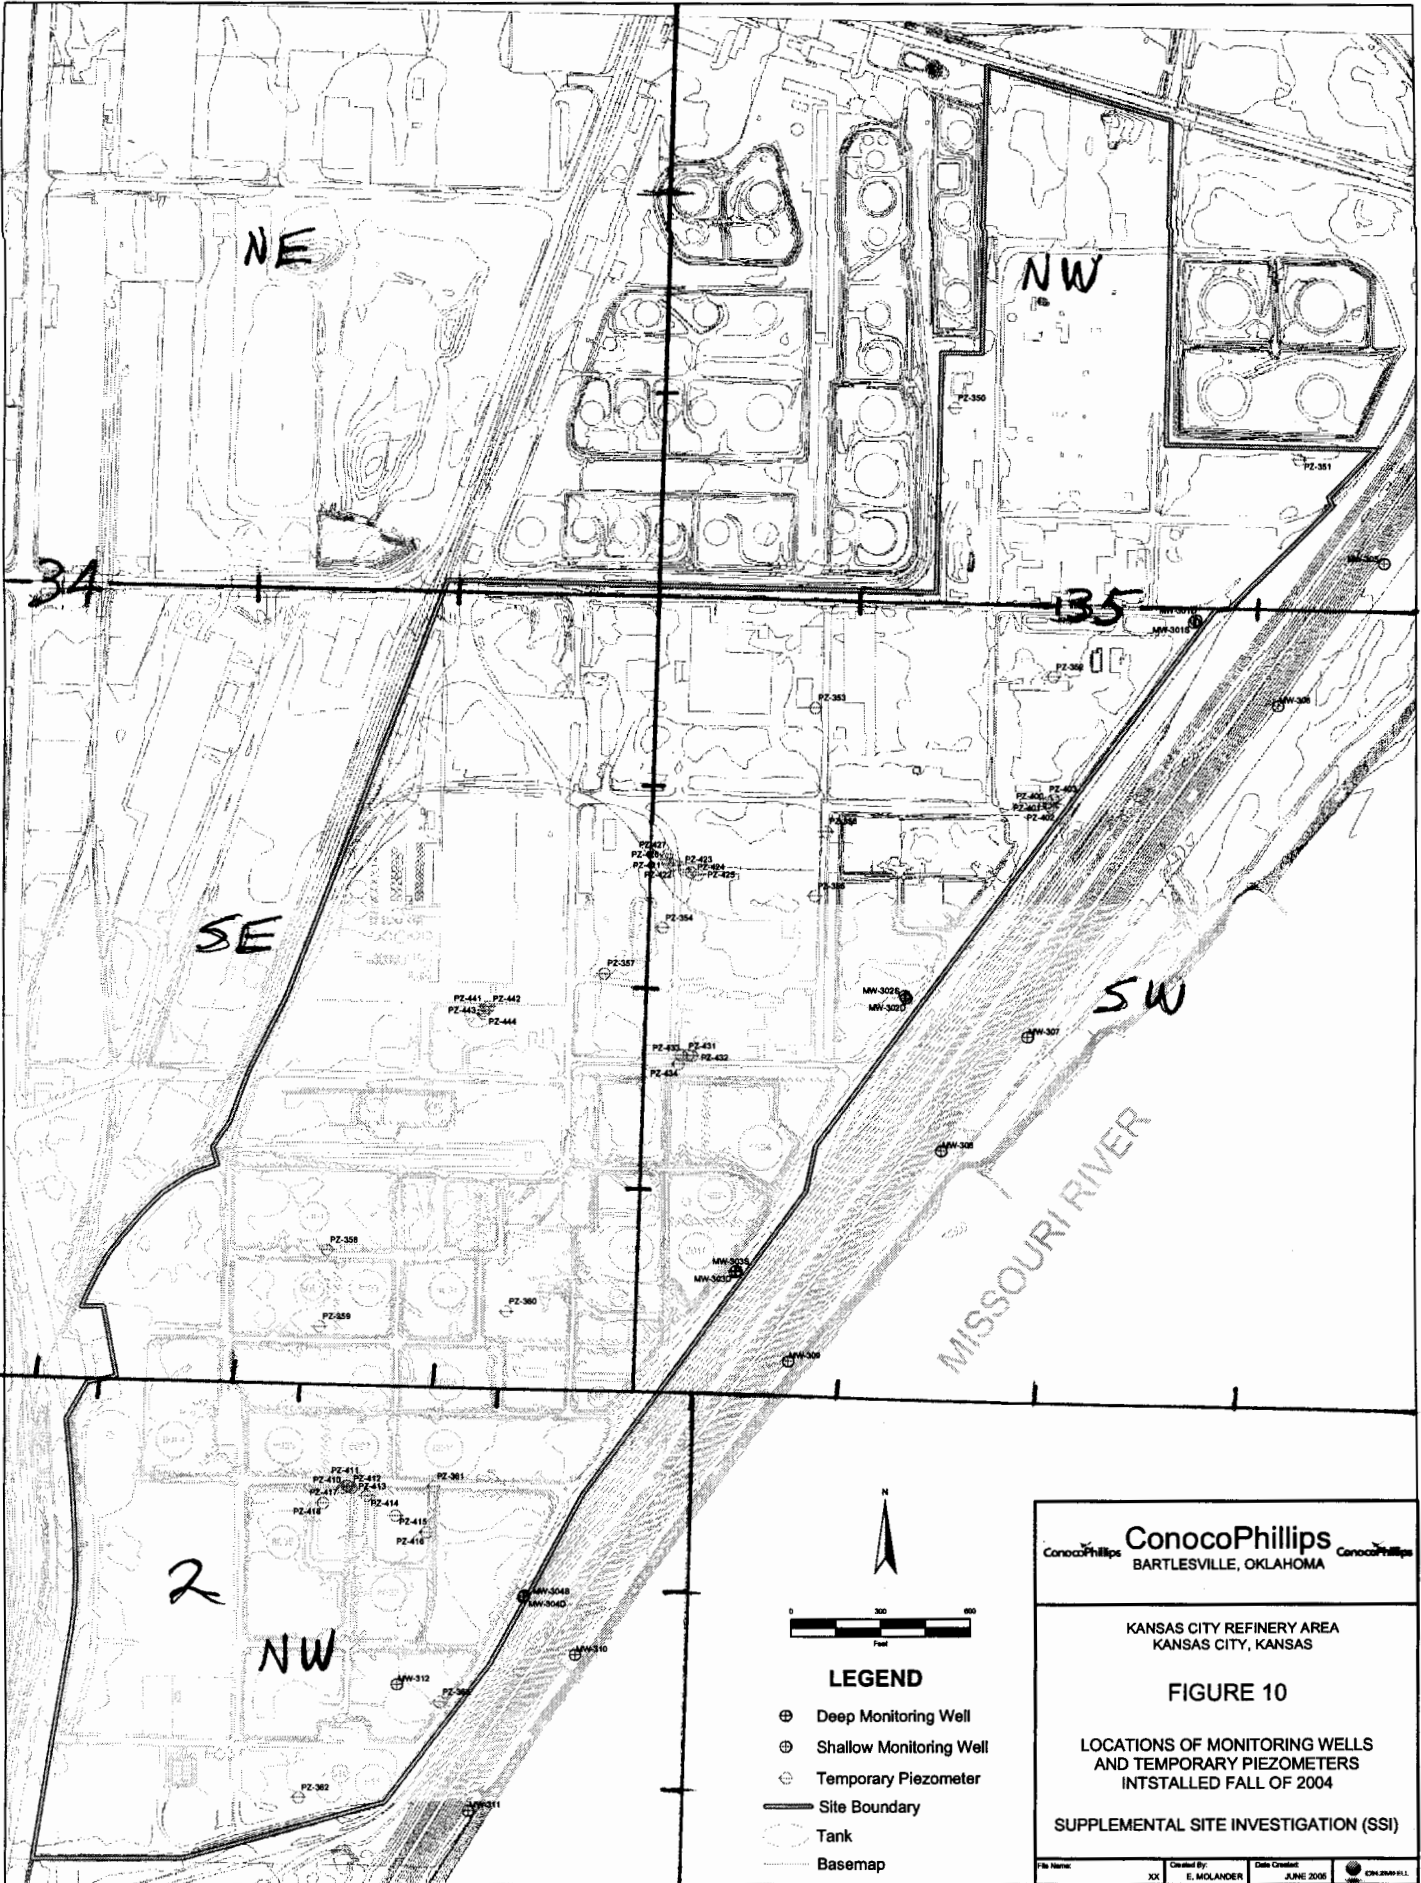

N.KC  
-KC

ConocoPhillips BARTLESVILLE, OKLAHOMA

---

KANSAS CITY REFINERY AREA  
 KANSAS CITY, KANSAS

**FIGURE 10**  
 LOCATIONS OF MONITORING WELLS  
 AND TEMPORARY PIEZOMETERS  
 INSTALLED FALL OF 2004

SUPPLEMENTAL SITE INVESTIGATION (SSI)

---

File Name: XX Created By: E. MOLANDER Date Created: JUNE 2005

R 25 E