

CORRECTION(S) TO WATER WELL RECORD (WWC-5)

(to rectify lacking or incorrect information)

County: Wyandotte

Location listed as:

Section-Township-Range: 22-50N-33W

Fraction ($\frac{1}{4}$ $\frac{1}{4}$ $\frac{1}{4}$): NW SW C

Location changed to:

35-10S-25E

C N2 SW

Other changes: Initial statements: _____

Changed to: _____

Comments: _____

verification method: Map of well locations from owner, and

North Kansas City 1:24,000 topo. map.

initials: DRD date: 9/8/2005



PROJECT NUMBER 321564.SI.01	BORING NUMBER PZ-403	SHEET 1 OF 1
SOIL BORING LOG		

PROJECT : Conoco Phillips - Supplemental SI	NORTHING: 309663.42	EASTING: 2276862.30
ELEVATION : 748.19 ft b.t.o.c.	DRILLING CONTRACTOR : Max's Enterprises Inc.	
DRILLING METHOD AND EQUIPMENT USED : CME 750 Rig, HSA	LOGGER : E. Molander	
WATER LEVELS : 19.0' bgs	START : 11/04/04 1230	END : 11/04/04 1305

DEPTH BELOW SURFACE (FT)		STANDARD PENETRATION TEST RESULTS 6"-6"-6" (N)	SOIL DESCRIPTION SOIL NAME, USCS GROUP SYMBOL, COLOR, MOISTURE CONTENT, RELATIVE DENSITY, OR CONSISTENCY, SOIL STRUCTURE, MINERALOGY.	COMMENTS DEPTH OF CASING, DRILLING RATE, DRILLING FLUID LOSS, TESTS, AND INSTRUMENTATION. Notes
INTERVAL (FT)	RECOVERY (FT) #/TYPE			
No Soil Sampling				
5			0.0': Gravel fill, brown, moist, no odor, poorly sorted	
			2.0': Poorly graded sand and gravel (GP-SP), brown, moist, intermittent woody debris	
			7.0': Clay (SL), dark gray, firm, highly plastic, odor	
			8.0': Clayey silt with trace fine sand (MH), dark gray, plastic, odor	
10			11.0': Poorly graded sand, light gray, moist, fine to medium, slight odor	
			13.0': Silty sand with clay (SM), dark gray, very moist, medium plasticity, odor	
15			16.0': Poorly graded sand (SP), gray, moist, fine to medium	
			19.0': Encounter water; Silty sand (SM), gray to dark gray, wet, slight sheen, odor	
20				
			27.0': Poorly graded sand (SP), gray, wet, slight odor and sheen	
25				
			35.0': End of boring	
35				

R25E

NE

NW

34

35

SE

SW

T10S


T11S

2

NW

N. KC
KC

MISSOURI RIVER

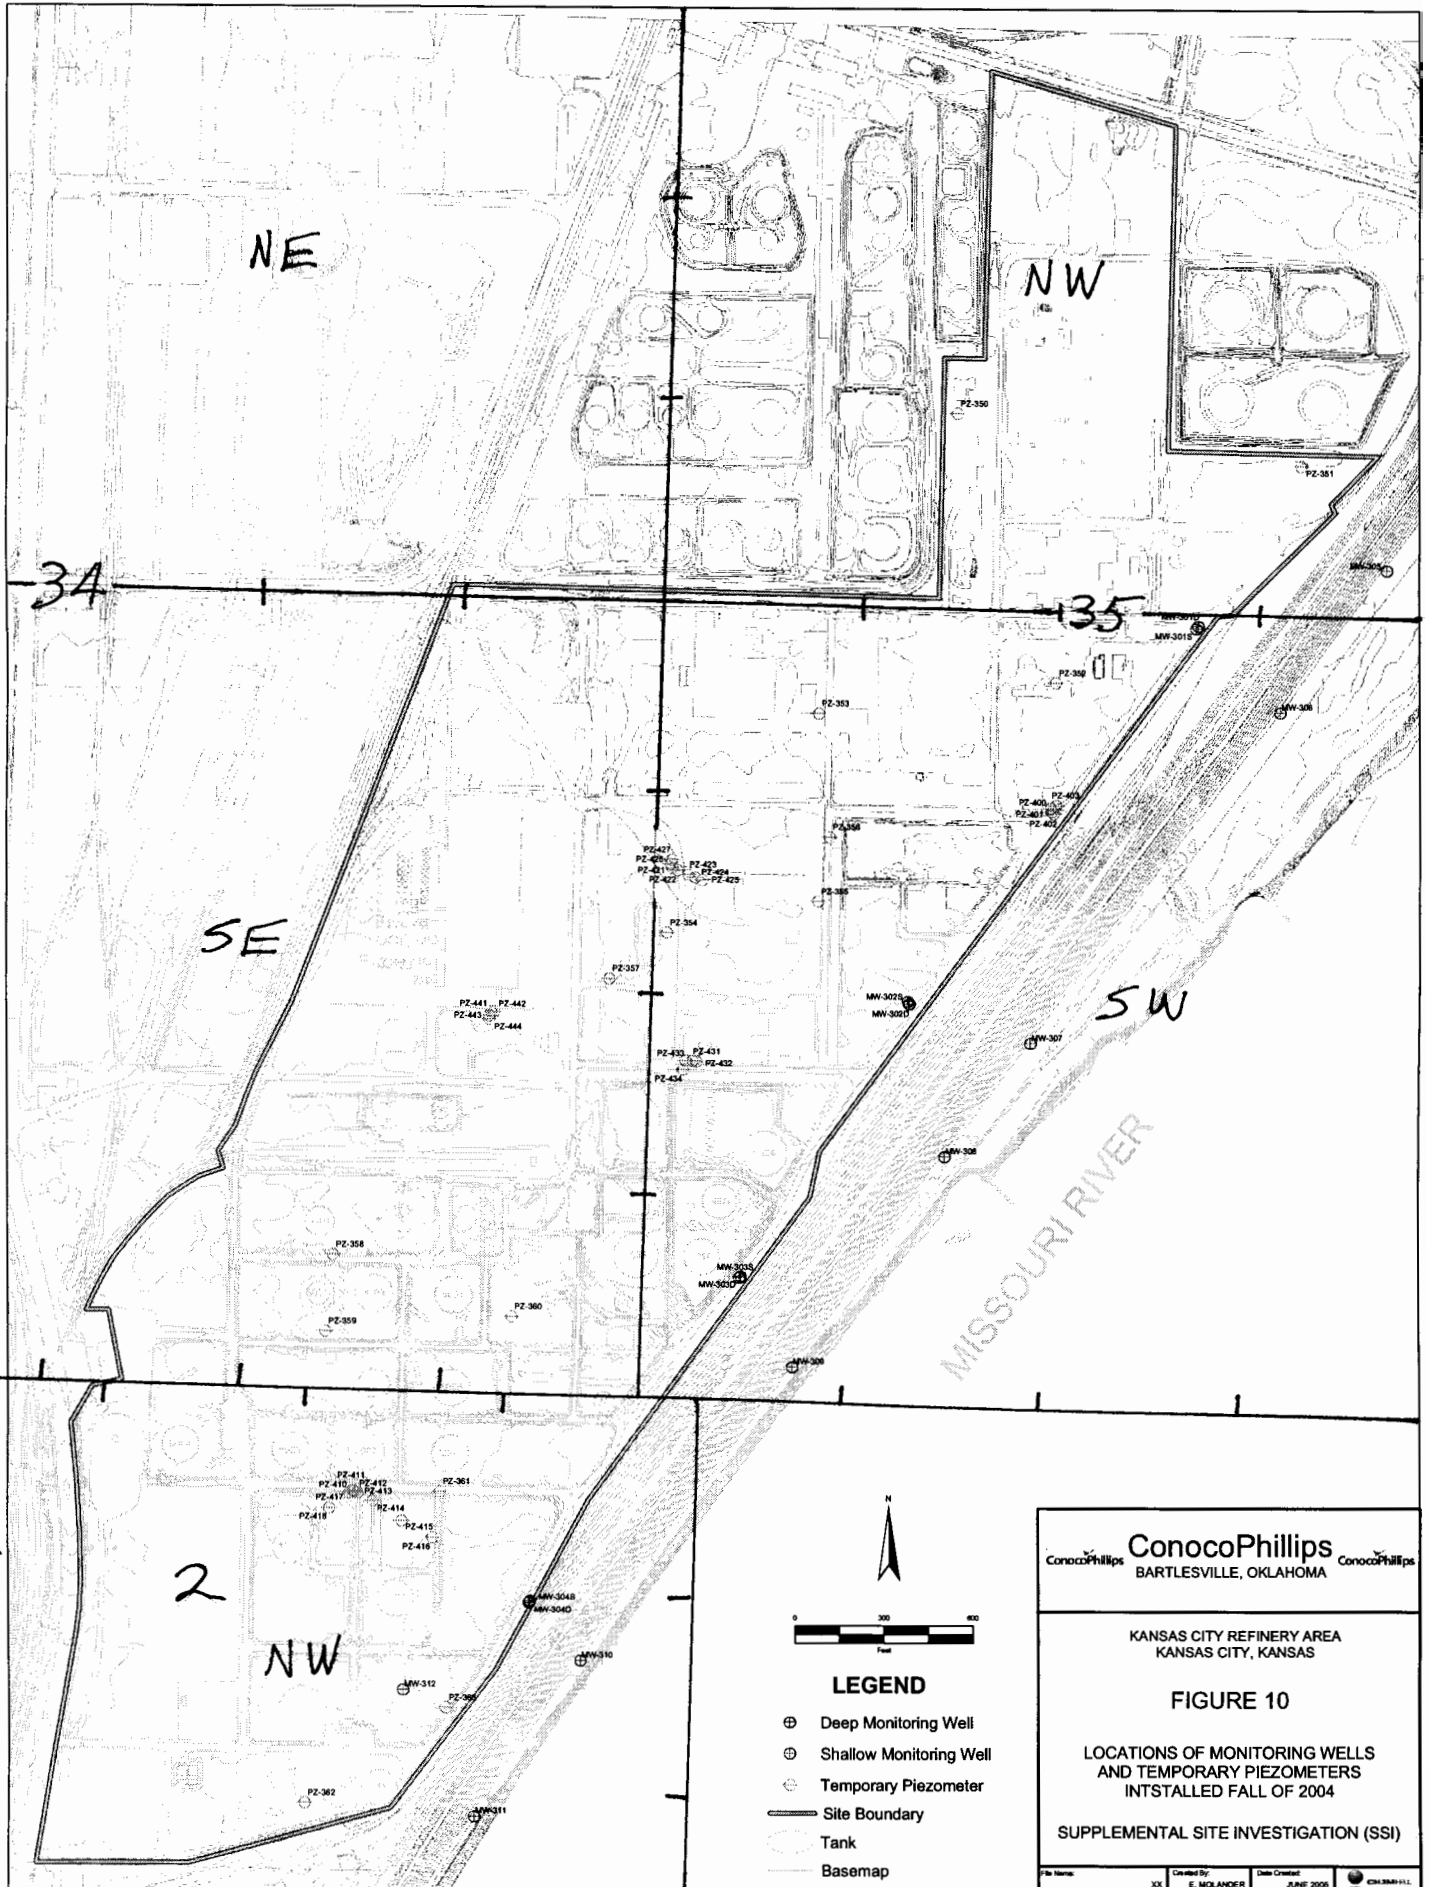

LEGEND

- ⊕ Deep Monitoring Well
- ⊕ Shallow Monitoring Well
- ⊕ Temporary Piezometer
- Site Boundary
- - - Tank
- - - Basemap

ConocoPhillips **ConocoPhillips** ConocoPhillips
 BARTLESVILLE, OKLAHOMA

KANSAS CITY REFINERY AREA
 KANSAS CITY, KANSAS

FIGURE 10

LOCATIONS OF MONITORING WELLS
 AND TEMPORARY PIEZOMETERS
 INSTALLED FALL OF 2004

SUPPLEMENTAL SITE INVESTIGATION (SSI)