

CORRECTION(S) TO WATER WELL RECORD (WWC-5)

(to rectify lacking or incorrect information)

County: Wyandotte

Location listed as:

Location changed to:

Section-Township-Range: 22-50N-33W

35-105-25E

Fraction ($\frac{1}{4}$ $\frac{1}{4}$ $\frac{1}{4}$): NW NW C

NE NW NE SW

Other changes: Initial statements: _____

Changed to: _____

Comments: _____

verification method: Map of well locations from owner, and
North Kansas City 1:24,000 topo. map

initials: ARL date: 9/8/2005


MW 301A

1 LOCATION OF WATER WELL: County: Wyandotte Fraction: NW 1/4 NW 1/4 C 1/4 Section Number: 22 Township Number: T 50Ns Range Number: R 33 E/W

Distance and direction from nearest town or city street address of well if located within city?

2029 Fairfax RCRS 66115

2 WATER WELL OWNER: Conoco Phillips company
 RR#, St. Address, Box #: 1218 Phillips Bldg 420 S Keeler AVE
 City, State, ZIP Code: Bartlesville OK 74004
 Board of Agriculture, Division of Water Resources
 Application Number:

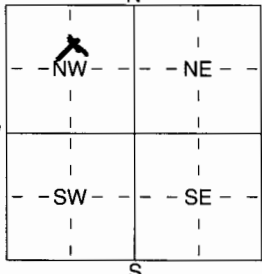3 LOCATE WELL'S LOCATION WITH AN "X" IN SECTION BOX: 

4 DEPTH OF COMPLETED WELL: 65 ft. ELEVATION: _____ ft.

Depth(s) Groundwater Encountered 1 _____ ft. 2 _____ ft. 3 _____ ft.

WELL'S STATIC WATER LEVEL _____ ft. below land surface measured on mo/day/yr _____

Pump test data: Well water was _____ ft. after _____ hours pumping _____ gpm

Est. Yield _____ gpm: Well water was _____ ft. after _____ hours pumping _____ gpm

WELL WATER TO BE USED AS:

| | | |
|-----------------------|--------------------|----------------------------|
| 5 Public water supply | 8 Air conditioning | 11 Injection well |
| 1 Domestic | 3 Feedlot | 6 Oil field water supply |
| 2 Irrigation | 4 Industrial | 7 Domestic (lawn & garden) |
| | | 9 Dewatering |
| | | 12 Other (Specify below) |

Monitoring well MW 301A

Was a chemical/bacteriological sample submitted to Department? Yes _____ No ; If yes, mo/day/yr sample was submitted _____

Water Well Disinfected? Yes _____ No _____

5 TYPE OF BLANK CASING USED:

| | | | | |
|---|------------|-------------------|-------------------------|--|
| 1 Steel | 3 RMP (SR) | 5 Wrought iron | 8 Concrete tile | CASING JOINTS: Glued _____ Clamped _____ |
| <input checked="" type="checkbox"/> PVC | 4 ABS | 6 Asbestos-Cement | 9 Other (specify below) | Welded _____ |
| | | 7 Fiberglass | | Threaded _____ |

Blank casing diameter _____ in. to _____ in. Dia _____ ft. to _____ ft. Dia _____ in. to _____ in. Dia _____ ft. to _____ ft.

Casing height above land surface _____ in., weight _____ lbs./ft. Wall thickness or gauge No. _____

TYPE OF SCREEN OR PERFORATION MATERIAL:

| | | | | |
|---------|--------------------|-----------------|---|--------------------------|
| 1 Steel | 3 Stainless Steel | 5 Fiberglass | <input checked="" type="checkbox"/> PVC | 10 Asbestos-Cement |
| 2 Brass | 4 Galvanized Steel | 6 Concrete tile | 8 RMP (SR) | 11 Other (Specify) _____ |
| | | | 9 ABS | 12 None used (open hole) |

SCREEN OR PERFORATION OPENINGS ARE:

| | | | | |
|--------------------|---|------------------|--------------------------|---------------------|
| 1 Continuous slot | <input checked="" type="checkbox"/> Mill slot | 5 Gauzed wrapped | 8 Saw cut | 11 None (open hole) |
| 2 Louvered shutter | 4 Key punched | 6 Wire wrapped | 9 Drilled holes | |
| | | 7 Torch cut | 10 Other (specify) _____ | |

SCREEN-PERFORATED INTERVALS: From 6.5 ft. to 55 ft., From _____ ft. to _____ ft., From _____ ft. to _____ ft.

GRAVEL PACK INTERVALS: From 6.5 ft. to 53 ft., From _____ ft. to _____ ft., From _____ ft. to _____ ft.

80/70 From 53 ft. to 51 ft., From _____ ft. to _____ ft.

6 GROUT MATERIAL: 1 Neat cement 2 Cement grout 3 Bentonite 4 Other _____

Grout Intervals: From 51 ft. to 0 ft., From _____ ft. to _____ ft., From _____ ft. to _____ ft.

What is the nearest source of possible contamination:

| | | | | | |
|--------------------------|-----------------|-----------------|--|--------------------------|-------------------------|
| 1 Septic tank | 4 Lateral lines | 7 Pit privy | <input checked="" type="checkbox"/> Fuel storage | 10 Livestock pens | 14 Abandoned water well |
| 2 Sewer lines | 5 Cess pool | 8 Sewage lagoon | 12 Fertilizer storage | 15 Oil well/Gas well | |
| 3 Watertight sewer lines | 6 Seepage pit | 9 Feedyard | 13 Insecticide storage | 16 Other (specify below) | |

Direction from well? _____ How many feet? _____

| FROM | TO | LITHOLOGIC LOG | FROM | TO | PLUGGING INTERVALS |
|------|----|----------------|------|----|--------------------|
| 0 | 7 | Silty Clay | | | |
| 7 | 17 | Silty Sand | | | |
| 17 | 65 | Brn sand | | | |
| | | | | | |
| | | | | | |
| | | | | | |
| | | | | | |
| | | | | | |
| | | | | | |
| | | | | | |
| | | | | | |
| | | | | | |

7 CONTRACTOR'S OR LANDOWNER'S CERTIFICATION: This water well was (1) constructed, (2) reconstructed, or (3) plugged under my jurisdiction and was completed on (mo/day/year) 11-2-04 and this record is true to the best of my knowledge and belief. Kansas Water Well Contractor's Licence No 704 This Water Well Record was completed on (mo/day/yr) 11-2-04 under the business name of MAX S by (signature) David Dingle

INSTRUCTIONS: Use typewriter or ball point pen. PLEASE PRESS FIRMLY and PRINT clearly. Please fill in blanks, underline or circle the correct answers. Send top three copies to Kansas Department of Health and Environment, Bureau of Water, Geology Section, 1000 SW Jackson St., Suite 420, Topeka, Kansas 66612-1367. Telephone 785-296-5522. Send one to WATER WELL OWNER and retain one for your records. Fee of \$5.00 for each constructed well.



| | | |
|---------------------------------------|---------------------------------|--------------|
| PROJECT NUMBER 321564.SI.01 | BORING NUMBER MW-301D | SHEET 1 OF 2 |
|---------------------------------------|---------------------------------|--------------|

SOIL BORING LOG

| | | |
|---|--|---------------------|
| PROJECT : Conoco Phillips - Supplemental SI | NORTHING: 310287.37 | EASTING: 2277300.99 |
| ELEVATION : 748.46 ft b.t.o.c. | DRILLING CONTRACTOR : Max's Enterprises Inc. | |
| DRILLING METHOD AND EQUIPMENT USED CME 750 | LOGGER : C. Morris | |
| WATER LEVELS : 32.0' bgs saturated sand | START : 11/2/04 1145 | END : 11/2/04 1220 |

| DEPTH BELOW SURFACE (FT) | STANDARD PENETRATION TEST RESULTS | | SOIL DESCRIPTION | COMMENTS |
|--------------------------|-----------------------------------|-----------------|---|---|
| | INTERVAL (FT) | #/TYPE | | |
| | RECOVERY (FT) | #/TYPE | | |
| | | 6"-6"-6" (N) | SOIL NAME, USCS GROUP SYMBOL, COLOR, MOISTURE CONTENT, RELATIVE DENSITY, OR CONSISTENCY, SOIL STRUCTURE, MINERALOGY. | DEPTH OF CASING, DRILLING RATE, DRILLING FLUID LOSS, TESTS, AND INSTRUMENTATION. Notes |
| No Soil Sampling | | | <p>0.0': Silty clay and gravel fill with organic matter w/ sand, medium brown, moist, loose, soft, coarse gravel, slight odor</p> <p>4.0': Elastic silt (MH) and fine to coarse gravel fill, light to dark brown in strata of colors, one dark gray/black layer, moist, soft, some plasticity, slight odor, stained with possible product</p> <p>6.0': Silty clay with gravel (CL), grayish brown, very moist, soft, plastic, fine to coarse, some gravel 0.5-2" stained, black coating</p> <p>7.0': Sandy gravelly elastic silt (MH), dark olive gray, wet, soft, plastic, HC odor</p> <p>8.0': Sandy silt (ML), olive gray, moist to wet, soft, plastic, fine, HC odor</p> <p>9.0': Sandy silt (ML), dark gray, wet, fine, sheen and strong HC odor</p> <p>10.0': Sandy silt (ML), brownish gray, fine, sheen</p> <p>12.5': Sandy silt (ML), olive gray, wet to saturated, sheen, strong odor, product?</p> <p>16.0': Silty sand (SM), olive gray, moist, fine to medium</p> <p>19.0': Moist</p> <p>21.0': Silty sand (SM), tan to gray, moist, strong odor</p> <p>26.0': Poorly graded sand with silt (SP), grayish brown to tan</p> | |



| | | |
|---------------------------------------|---------------------------------|--------------|
| PROJECT NUMBER 321564.SI.01 | BORING NUMBER MW-301D | SHEET 2 OF 2 |
| SOIL BORING LOG | | |

| | | |
|---|--|---------------------|
| PROJECT : Conoco Phillips - Supplemental SI | NORTHING: 310287.37 | EASTING: 2277300.99 |
| ELEVATION : 748.46 ft b.t.o.c. | DRILLING CONTRACTOR : Max's Enterprises Inc. | |
| DRILLING METHOD AND EQUIPMENT USED CME 750 | LOGGER : C. Morris | |
| WATER LEVELS : 32.0' bgs saturated sand | START : 11/2/04 1145 | END : 11/2/04 1220 |

| DEPTH BELOW SURFACE (FT) | STANDARD PENETRATION TEST RESULTS | | SOIL DESCRIPTION SOIL NAME, USCS GROUP SYMBOL, COLOR, MOISTURE CONTENT, RELATIVE DENSITY, OR CONSISTENCY, SOIL STRUCTURE, MINERALOGY. | COMMENTS DEPTH OF CASING, DRILLING RATE, DRILLING FLUID LOSS, TESTS, AND INSTRUMENTATION. Notes |
|--------------------------|-----------------------------------|---------------|--|---|
| | INTERVAL (FT) | RECOVERY (FT) | | |
| | #/TYPE | 6"-6'-6" (N) | | |
| 32.0' | | | 32.0': Well graded sand (SW), wet to saturated (at water table), fine to medium, HC odor | |
| 38.0' | | | 38.0': Well graded sand with gravel (SW), dark olive gray, wet, HC odor | |
| 42.0' | | | 42.0': Well graded sand with gravel (SW), dark gray, fine, grading coarser | |
| 48.0' | | | 48.0': Well graded sand with gravel (SW), dark gray, wet, slight HC odor, trace fines | |
| 65.0' | | | 65': End of boring | |

R 25 E

NE

NW

34

35

SE

SW

T 10 S



T 11 S

2

NW

MISSOURI RIVER

N. KC
KC

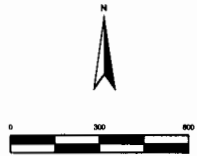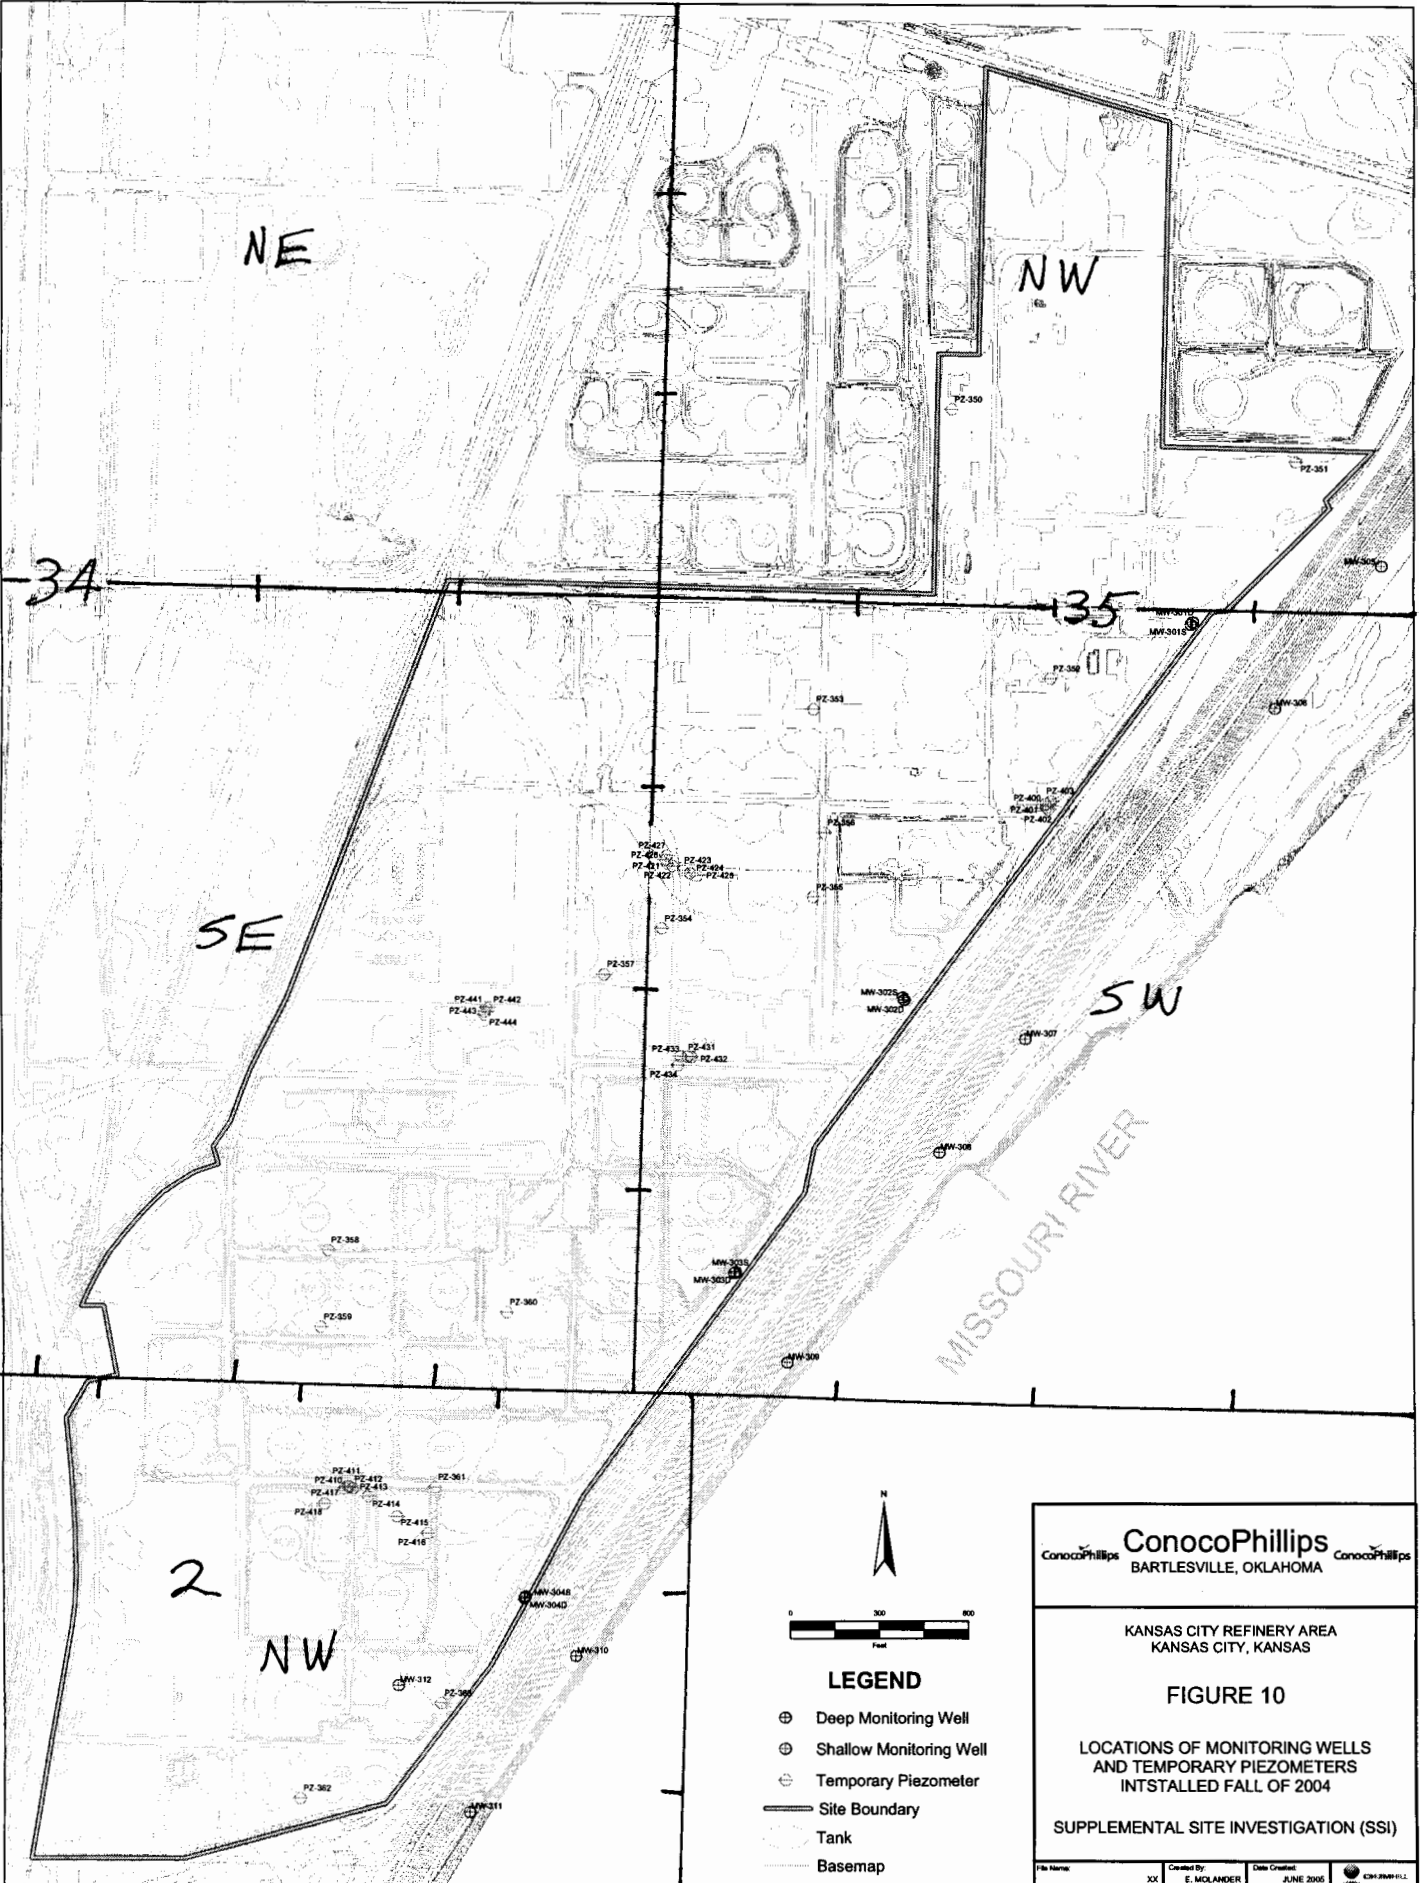

LEGEND

- ⊕ Deep Monitoring Well
- ⊙ Shallow Monitoring Well
- ⊖ Temporary Piezometer
- Site Boundary
- Tank
- Basemap

ConocoPhillips
 BARTLESVILLE, OKLAHOMA

KANSAS CITY REFINERY AREA
 KANSAS CITY, KANSAS

FIGURE 10
 LOCATIONS OF MONITORING WELLS
 AND TEMPORARY PIEZOMETERS
 INSTALLED FALL OF 2004
 SUPPLEMENTAL SITE INVESTIGATION (SSI)

| | | | |
|------------|----------------------------|----------------------------|--|
| File Name: | Created By: E. MCLANDER | Date Created: JUNE 2005 | |
|------------|----------------------------|----------------------------|--|