

**CORRECTION(S) TO WATER WELL RECORD (WWC-5)**

(to rectify lacking or incorrect information)

County: Wyandotte

**Location listed as:**

Section-Township-Range: 22-50N-33W

Fraction (  $\frac{1}{4}$   $\frac{1}{4}$   $\frac{1}{4}$ ): NW NW SE

**Location changed to:**

35-10S-25E

SW NE SW

**Other changes:** Initial statements: \_\_\_\_\_

Changed to: \_\_\_\_\_

Comments: \_\_\_\_\_

verification method: Map of well locations from owner, and  
North Kansas City 1:24,000 topo. map.

initials: DRG date: 9/9/2005

submitted by: Kansas Geological Survey, Data Resources Library, 1930 Constant Ave., Lawrence, KS 66047-3726  
to: Kansas Dept of Health & Environment, Bureau of Water, 1000 SW Jackson, Suite 420, Topeka, KS 66612-1367.

MW 201

1	LOCATION OF WATER WELL:	Fraction	Section Number	Township Number	Range Number
County:	Wyandotte	1/4 Sec 5 E 1/4	22	50N	33 EW

Distance and direction from nearest town or city street address of well if located within city?

2029 Fairfax KS KS 66115

2	WATER WELL OWNER:	Board of Agriculture, Division of Water Resources
	RR #, St. Address, Box #:	Application Number:
	City, State, ZIP Code:	

CONOCO Phillips Company, 1218 Phillips Bldg 420 S. Kecker Ave., Bartlesville OK 74004

3	MARK WELL'S LOCATION WITH AN "X" IN SECTION BOX:

4	DEPTH OF WELL	ft.
	WELL'S STATIC WATER LEVEL	ft.
WELL WAS USED AS:		
1 Domestic	5 Public Water Supply	9 Dewatering
2 Irrigation	6 Oil Field Water Supply	10 Monitoring Well
3 Feedlot	7 Domestic (Lawn & Garden)	11 Injection Well
4 Industrial	8 Air Conditioning	12 Other
Was a chemical / bacteriological sample submitted to Department? Yes ..... No <input checked="" type="checkbox"/>		
If yes, mo/day/yr sample was submitted .....		
Water Well Disinfected: Yes ..... No <input checked="" type="checkbox"/>		

5	TYPE OF BLANK CASING USED:
<input type="checkbox"/> Steel <input type="checkbox"/> RMP (SR) <input type="checkbox"/> Wrought <input type="checkbox"/> Fiberglass <input type="checkbox"/> Other (Specify below) <input checked="" type="checkbox"/> PVC <input type="checkbox"/> ABS <input type="checkbox"/> Asbestos-Cement <input type="checkbox"/> Concrete Tile	
Blank casing diameter ..... 2 in.    Was casing pulled? Yes <input checked="" type="checkbox"/> No .....    If yes, how much ..... All	
Casing height above or below land surface ..... 29 in.	

6	GROUT PLUG MATERIAL:	1 Neat cement	2 Cement grout	3 Bentonite	4 Other
Grout Plug Intervals: From 25.14 ft. to 0 ft., From ..... ft. to ..... ft., From ..... to ..... ft.					
What is the nearest source of possible contamination:					
1 Septic tank	6 Seepage pit	11 Fuel storage	16 Other (specify below)		
2 Sewer lines	7 Pit privy	12 Fertilizer storage			
3 Watertight sewer lines	8 Sewage lagoon	13 Insecticide storage			
4 Lateral lines	9 Feedyard	14 Abandoned water well			
5 Cess pool	10 Livestock pens	15 Oil well/Gas well			
Direction from well? .....    How many feet? .....					

FROM	TO	PLUGGING MATERIALS
25.14	0	Cement grout

7	CONTRACTOR'S OF LANDOWNER'S CERTIFICATION: This water well was plugged under my jurisdiction and was completed on (mo/day/year) 12-2-04 and this record is true to the best of my knowledge and belief. Kansas Water Well Contractor's License No. 709 This Water Well Record was completed on (mo/day/year) 2-11-05 under the business name of MAXS by (signature) David Dwyer
---	---

INSTRUCTIONS: Use typewriter or ball point pen. Please press firmly and print clearly. Please fill in blanks, underline or circle the correct answers. Send top three copies to Kansas Department of Health and Environment, Bureau of Water, Geology Section, 1000 SW Jackson St., Ste. 420, Topeka, Kansas 66612-1367. Telephone: 785/296-5522. Send one to Water Well Owner and retain one for your records.

R25E

NE

NW

34

35

SE

SW


T10S

T11S

2

NW

MISSOURI RIVER

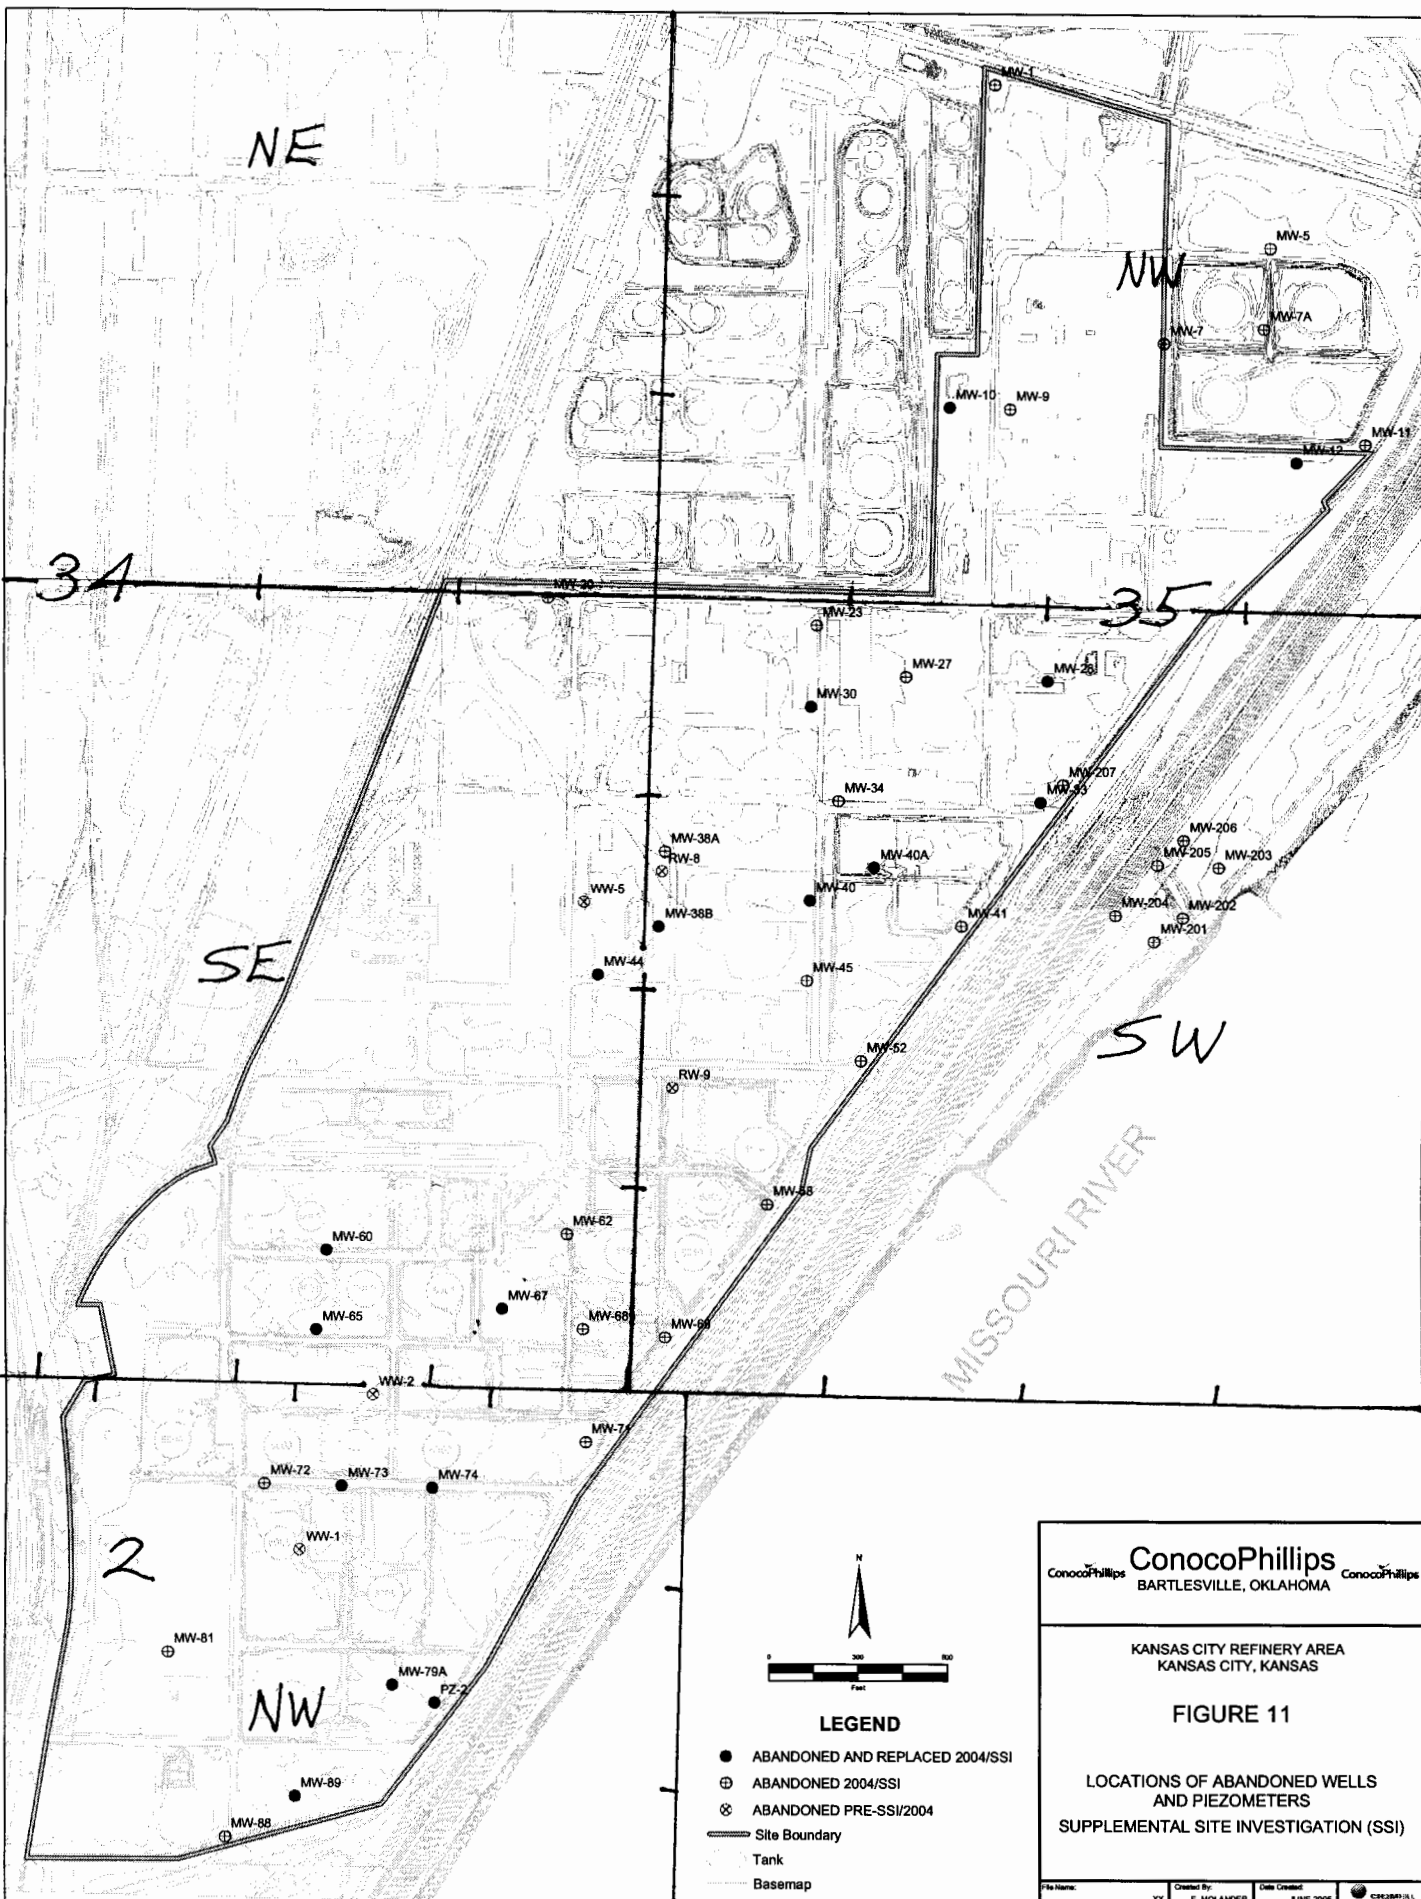

**LEGEND**

- ABANDONED AND REPLACED 2004/SSI
- ⊕ ABANDONED 2004/SSI
- ⊗ ABANDONED PRE-SSI/2004
- Site Boundary
- Tank
- Basemap

**ConocoPhillips**  
 ConocoPhillips BARTLESVILLE, OKLAHOMA ConocoPhillips

KANSAS CITY REFINERY AREA  
 KANSAS CITY, KANSAS

**FIGURE 11**

LOCATIONS OF ABANDONED WELLS  
 AND PIEZOMETERS  
 SUPPLEMENTAL SITE INVESTIGATION (SSI)