

CORRECTION(S) TO WATER WELL RECORD (WWC-5)

(to rectify lacking or incorrect information)

County: Wyandotte

Location listed as:

Location changed to:

Section-Township-Range: 22-50N-33W

35-10S-25E

Fraction ($\frac{1}{4}$ $\frac{1}{4}$ $\frac{1}{4}$): E $\frac{1}{2}$ SE NE

W2 SW NW SW

Other changes: Initial statements: _____

Changed to: _____

Comments: _____

verification method: Map of well locations from owner, and
North Kansas City 1:24,000 topo. map

initials: DRJ date: 9/8/2005



PROJECT NUMBER 321564.SI.01	BORING NUMBER PZ-421	SHEET 1 OF 1
SOIL BORING LOG		

PROJECT : Conoco Phillips - Supplemental SI	NORTHING: 309381.54	EASTING: 2275586.13
ELEVATION : 747.86 ft b.t.o.c.	DRILLING CONTRACTOR : Max's Enterprises Inc.	
DRILLING METHOD AND EQUIPMENT USED : CME 750 Rig, HSA	LOGGER : E. Molander	
WATER LEVELS : 26' bgs	START : 11/01/04 0820	END : 11/04/04 0910

DEPTH BELOW SURFACE (FT)	INTERVAL (FT)	RECOVERY (FT)	#/TYPE	STANDARD	SOIL DESCRIPTION	COMMENTS
				PENETRATION		DEPTH OF CASING, DRILLING RATE, DRILLING FLUID LOSS, TESTS, AND INSTRUMENTATION.
				TEST RESULTS		
				6"-6"-6" (N)	0.0': Well graded sand with clay and trace gravel fill (SW), brown, moist, fine to medium	
					3.5': Silty clay (CL), dark gray, moist	
					6.0': Silty clay (CL), dark gray to gray, wet, sheen, strong odor	
					9.0': Elastic silt (MH), gray to light gray, wet, sheen, strong odor	
					10.0': Grades less moisture, moist sheen	
					14.0': Silty clay with sand (CL), moist, fine sand	
					16.0': Poorly graded sand with clay (SP), brownish gray, moist, loose, fine, odor	
					19.0': Poorly graded sand (SP), brownish gray, fine, odor	
					22.5': Grades increasingly gray, fine to medium	
					25.0': Poorly graded sand with silt (SP-SM), gray, moist, fine, odor	
					26.0': Encounter water	
					29.0': Silty sand (SM), gray, wet, fine, strong odor, product	
					34.0': End of boring	
5						
10						
15						
20						
25						
35						

R25E

NE

NW

34

35

SE

SW

T10S


T11S

2

NW

MISSOURI RIVER

N.KC
KC

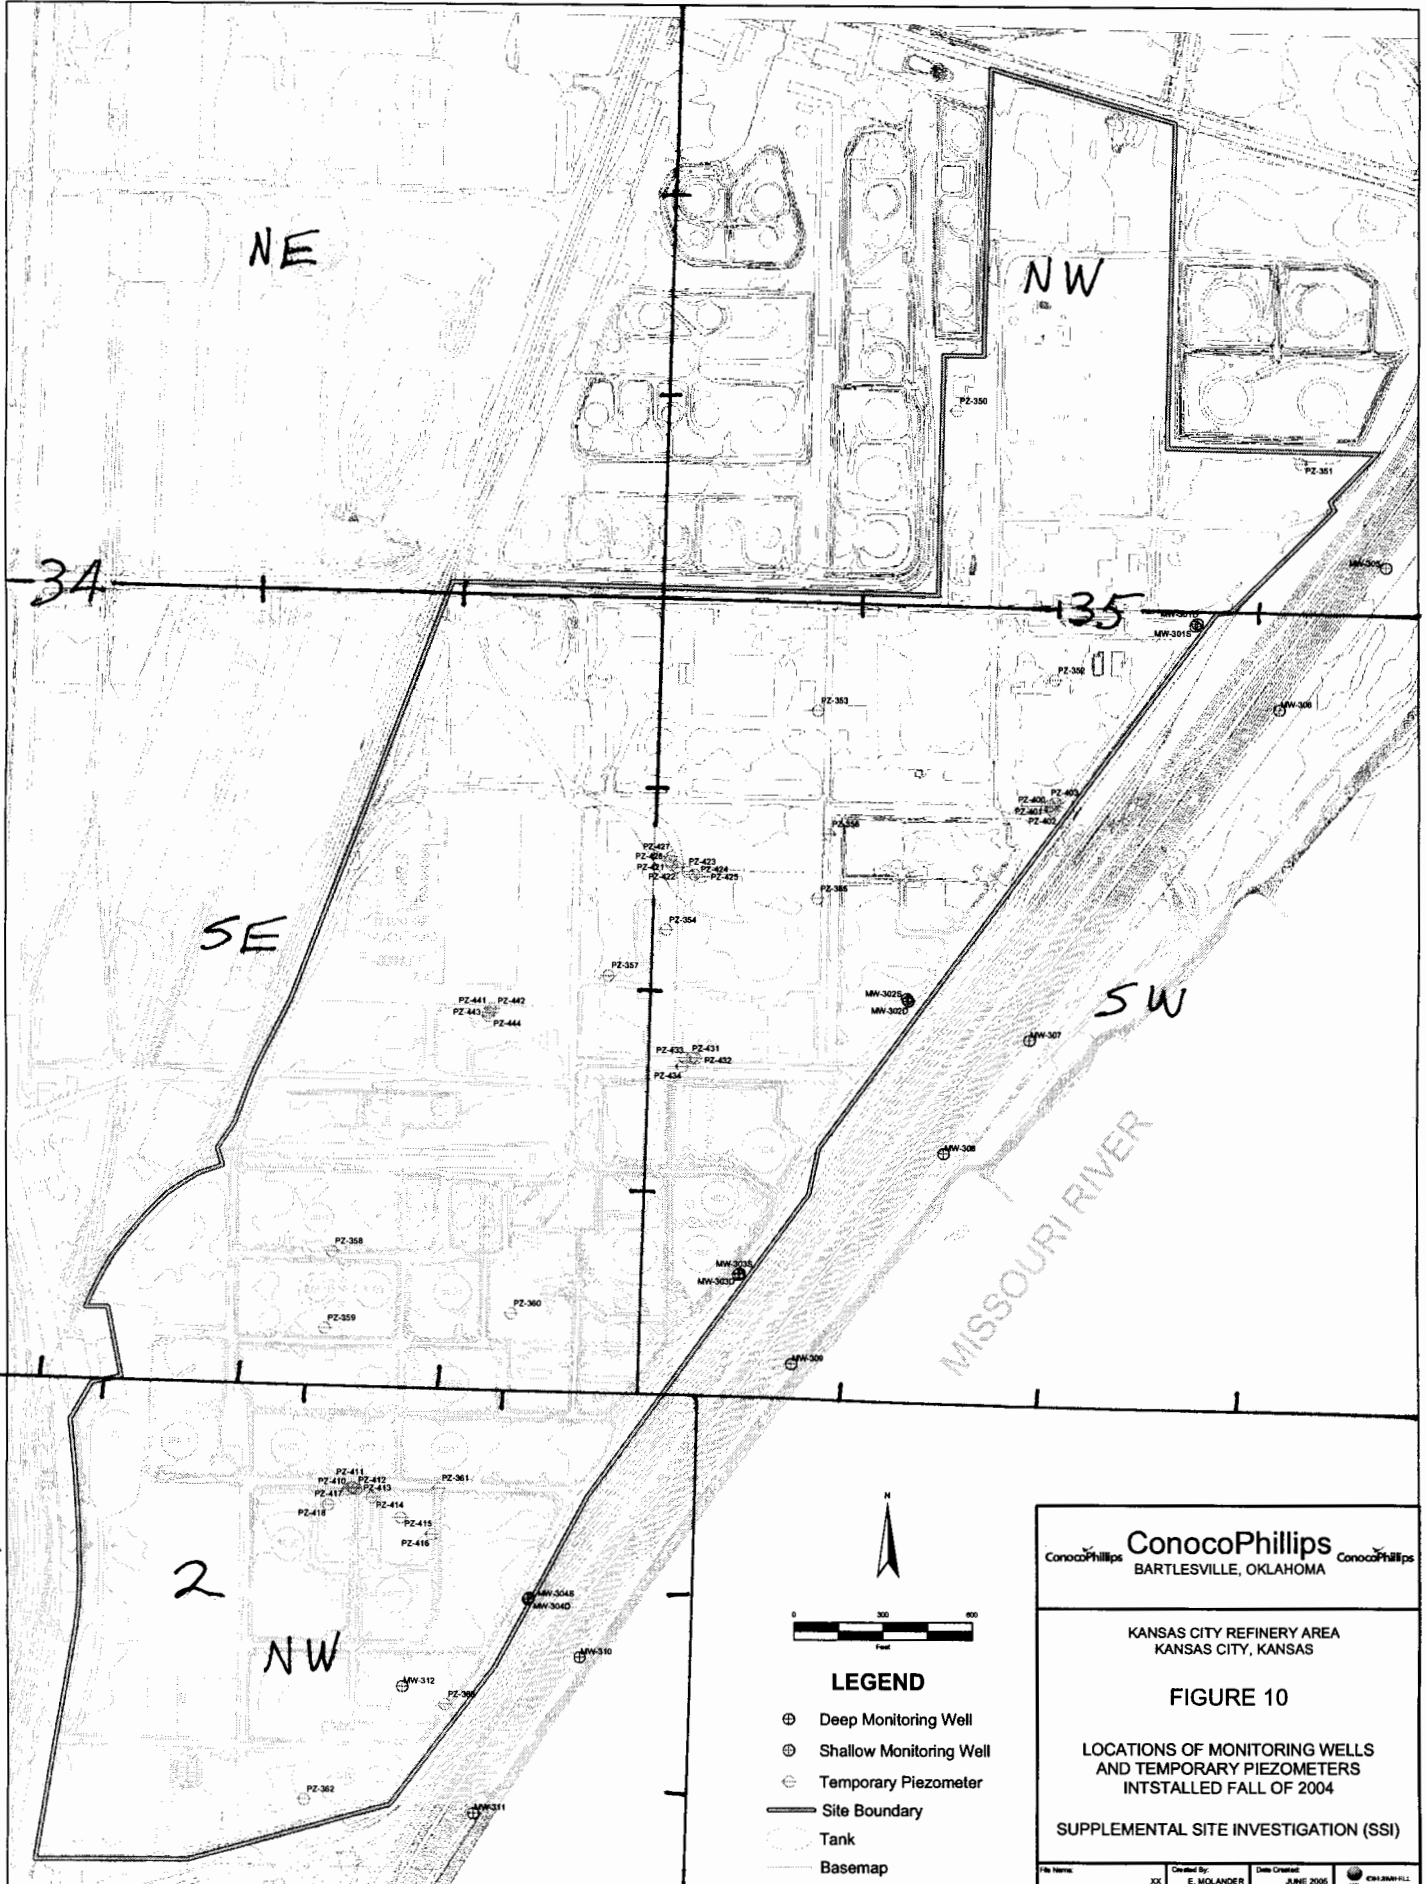


ConocoPhillips
 BARTLESVILLE, OKLAHOMA

KANSAS CITY REFINERY AREA
KANSAS CITY, KANSAS

FIGURE 10

LOCATIONS OF MONITORING WELLS
AND TEMPORARY PIEZOMETERS
INSTALLED FALL OF 2004

SUPPLEMENTAL SITE INVESTIGATION (SSI)