

CORRECTION(S) TO WATER WELL RECORD (WWC-5)

(to rectify lacking or incorrect information)

County: Wyandotte

Location listed as:

Location changed to:

Section-Township-Range: 22-50N-33W

35-10S-25E

Fraction ($\frac{1}{4}$ $\frac{1}{4}$ $\frac{1}{4}$): E $\frac{1}{2}$ SE NE

W2 SW NW SW

Other changes: Initial statements: _____

Changed to: _____

Comments: _____

verification method: Map of well locations from owner, and
North Kansas City 1:24,000 topo. map

initials: DR date: 9/8/2005

submitted by: Kansas Geological Survey, Data Resources Library, 1930 Constant Ave., Lawrence, KS 66047-3726
to: Kansas Dept of Health & Environment, Bureau of Water, 1000 SW Jackson, Suite 420, Topeka, KS 66612-1367.



PROJECT NUMBER 321564.SI.01	BORING NUMBER PZ-425	SHEET 1 OF 1
SOIL BORING LOG		

PROJECT : Conoco Phillips - Supplemental SI	NORTHING: 309346.69	EASTING: 2275687.71
ELEVATION : 749.58 ft b.t.o.c.	DRILLING CONTRACTOR : Max's Enterprises Inc.	
DRILLING METHOD AND EQUIPMENT USED : Mobile Rig B-57	LOGGER : E. Molander	
WATER LEVELS : 26' bgs	START : 11/02/04 1145	END : 11/02/04 1225

DEPTH BELOW SURFACE (FT)	INTERVAL (FT)		STANDARD PENETRATION TEST RESULTS 6"-6"-6" (N)	SOIL DESCRIPTION SOIL NAME, USCS GROUP SYMBOL, COLOR, MOISTURE CONTENT, RELATIVE DENSITY, OR CONSISTENCY, SOIL STRUCTURE, MINERALOGY.	COMMENTS DEPTH OF CASING, DRILLING RATE, DRILLING FLUID LOSS, TESTS, AND INSTRUMENTATION. Notes
	RECOVERY (FT)	#/TYPE			
0				0.0': Concrete	
0.33				Silty clay with sand (CL), brown, moist, fine to coarse sand	
1.0'				Gravel, silt and sand fill, brown, unconsolidated	
3.5'				Well graded sand (SW), silt (ML), and gravel (GP), brownish gray, loose	
5.0'				Poorly graded sand with trace clay (SP), dark gray	
6.0'				Silty clay (CL), dark gray, moist, firm	
7.0'				Elastic silt (MH), dark gray, moist	
8.0'				Increased moisture, grades soft, gray	
15.0'				Poorly graded sand (SP), gray, moist, medium	
16.0'				Poorly graded sand (SP), gray to dark gray, moist	
17.0'				Poorly graded sand (SP), light gray, moist, fine to medium	
22.0'				Grades to poorly graded sand with clay (SP-SC)	
25.0'				Increased moisture, color grades darker	
26.0'				Encounter water	
35.0'				End of boring	

R25E

NE

NW

34

35

SE

SW

T10S


T11S


2

NW

MISSOURI RIVER


N. KC
KC

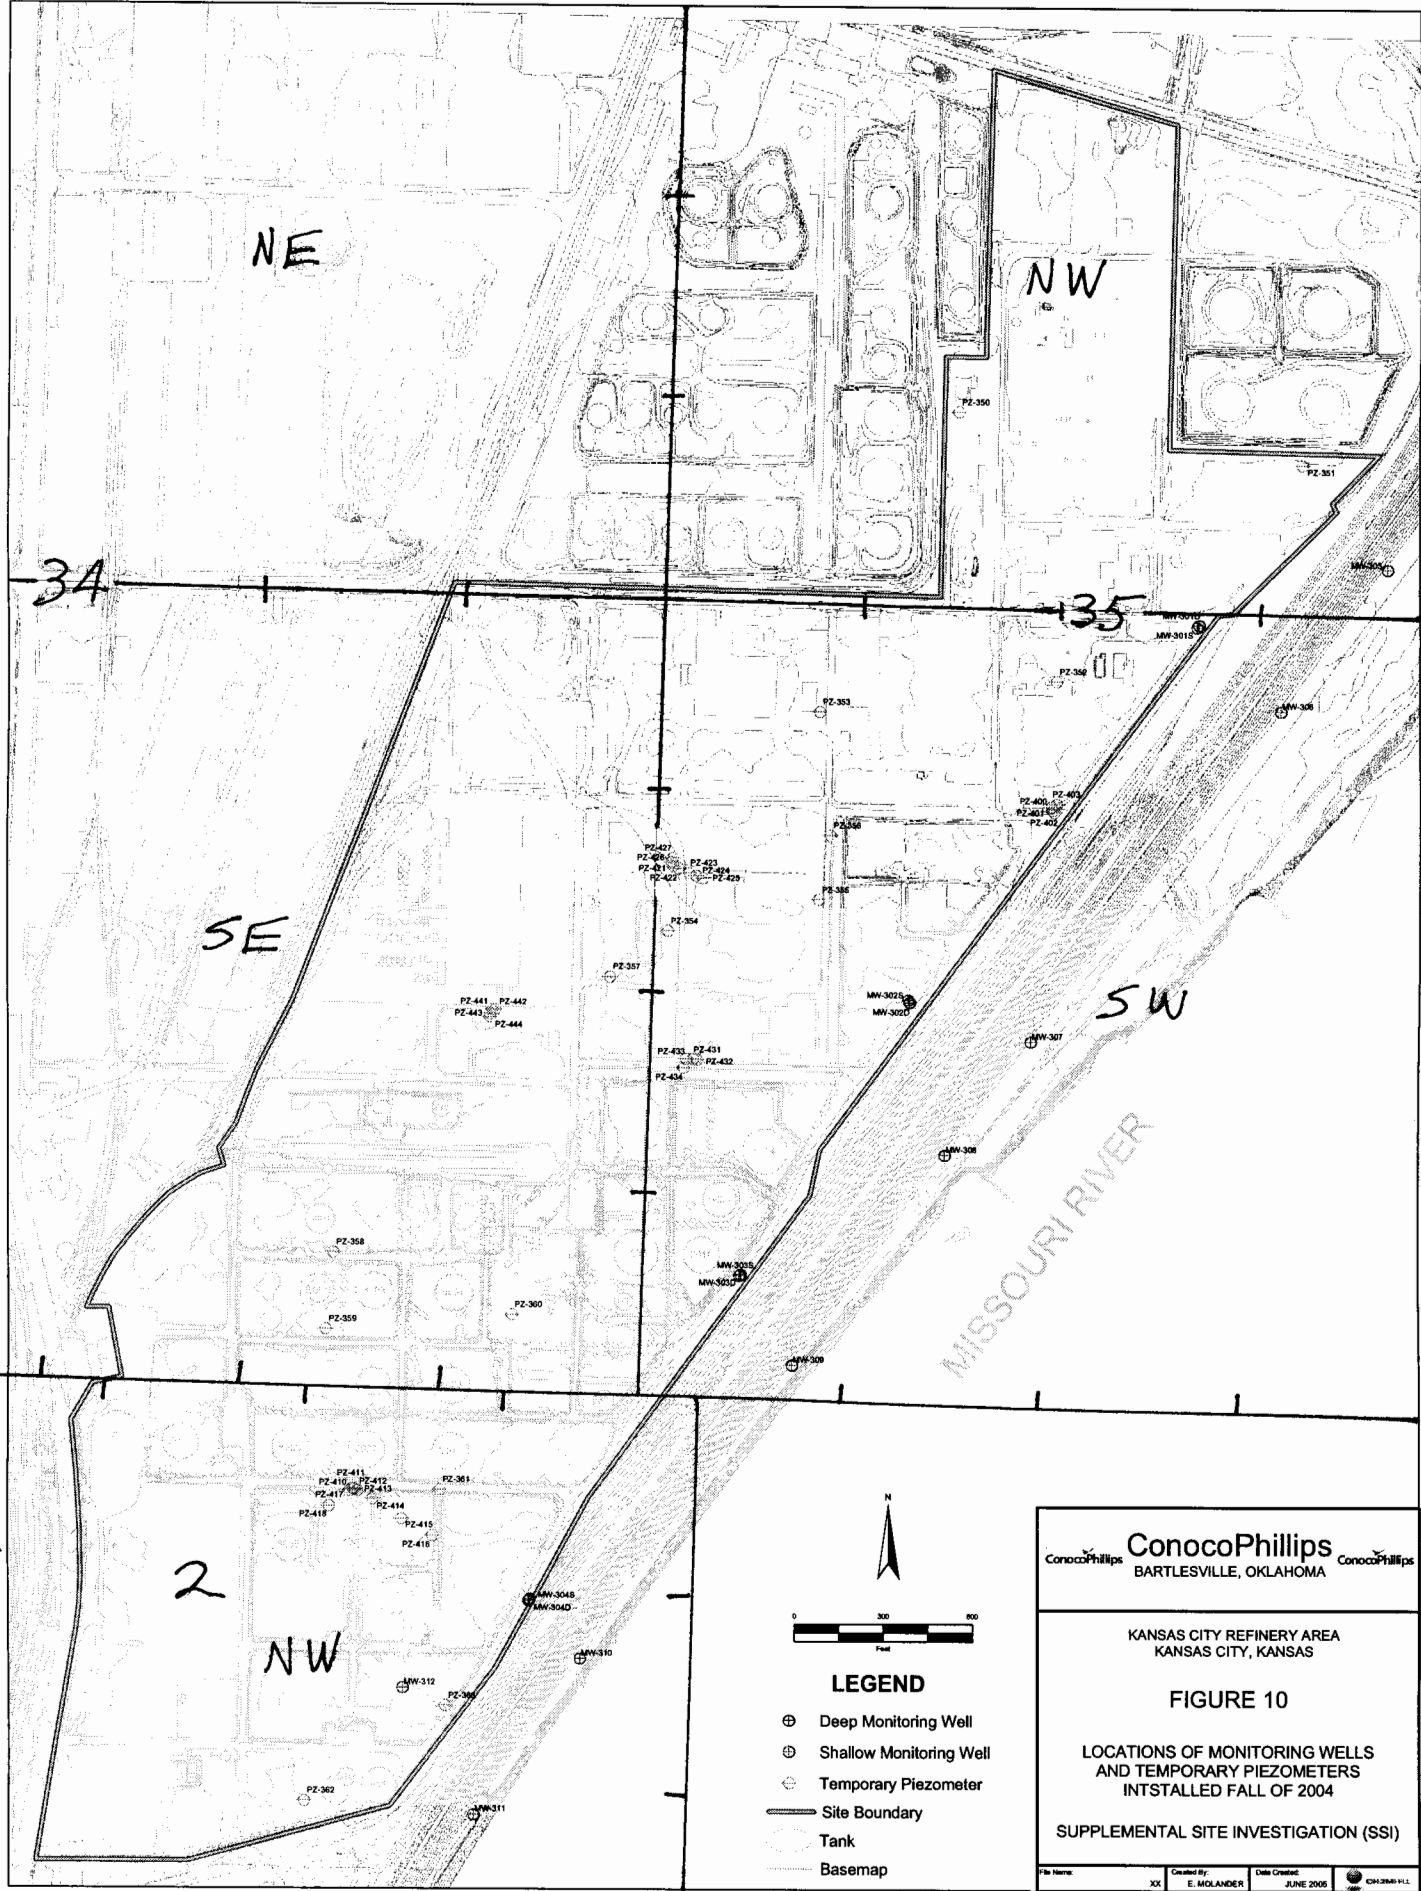


ConocoPhillips
 BARTLESVILLE, OKLAHOMA

KANSAS CITY REFINERY AREA
 KANSAS CITY, KANSAS

FIGURE 10
 LOCATIONS OF MONITORING WELLS
 AND TEMPORARY PIEZOMETERS
 INSTALLED FALL OF 2004
 SUPPLEMENTAL SITE INVESTIGATION (SSI)

File Name:	Created By:	Date Created:	
XX	E. MOLANDER	JUNE 2005	ESRI/2005 9-1