

CORRECTION(S) TO WATER WELL RECORD (WWC-5)

(to rectify lacking or incorrect information)

Location listed as:

Section-Township-Range: 34-105-25E

Fraction ($\frac{1}{4}$ $\frac{1}{4}$ $\frac{1}{4}$): E $\frac{1}{2}$ SW NE

County: Wyandotte

Location changed to:

35-105-25E

NW SW NW SW

Other changes: Initial statements: _____

Changed to: _____

Comments: _____

verification method: Map of well locations from owner, and

North Kansas City 1:24,000 topo. map.

initials: DRJ date: 9/9/2005

submitted by: Kansas Geological Survey, Data Resources Library, 1930 Constant Ave., Lawrence, KS 66047-3726


to: Kansas Dept of Health & Environment, Bureau of Water, 1000 SW Jackson, Suite 420, Topeka, KS 66612-1367.

MW 38A

1	LOCATION OF WATER WELL:	Fraction	Section Number	Township Number	Range Number
	County: <u>Wyandotte</u>	<u>E 1/4 SW 1/4</u>	<u>37</u>	<u>S</u>	<u>25</u> (BW)

Distance and direction from nearest town or city street address of well if located within city?
2024 Fairfax KCKS 66115

2	WATER WELL OWNER:	RR #, St. Address, Box #:	City, State, ZIP Code	Board of Agriculture, Division of Water Resources Application Number:
	<u>Conoco Phillips Company</u>	<u>1218 Phillips Bldg 420 S. Kecker Ave</u>	<u>Bartlesville OK 74004</u>	

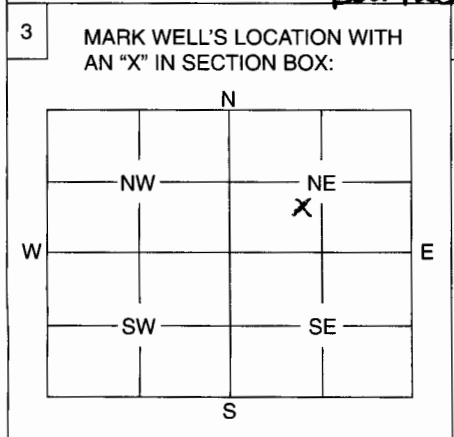

4	DEPTH OF WELL	ft.
	<u>25.37</u>	
	WELL'S STATIC WATER LEVEL	ft.
	WELL WAS USED AS:	
	1 Domestic	5 Public Water Supply
	2 Irrigation	6 Oil Field Water Supply
	3 Feedlot	7 Domestic (Lawn & Garden)
	4 Industrial	8 Air Conditioning
		9 Dewatering
		10 Monitoring Well
		11 Injection Well
		12 Other

Was a chemical / bacteriological sample submitted to Department? Yes No ✓
If yes, mo/day/yr sample was submitted

Water Well Disinfected: Yes No ✓

5	TYPE OF BLANK CASING USED:
	<input type="checkbox"/> 1 Steel <input type="checkbox"/> 3 RMP (SR) <input type="checkbox"/> 5 Wrought <input type="checkbox"/> 7 Fiberglass <input type="checkbox"/> 9 Other (Specify below) <input checked="" type="checkbox"/> 2 PVC <input type="checkbox"/> 4 ABS <input type="checkbox"/> 6 Asbestos-Cement <input type="checkbox"/> 8 Concrete Tile
	Blank casing diameter <u>2</u> in. Was casing pulled? Yes <u>✓</u> No If yes, how much <u>411</u>
	Casing height above or below land surface <u>29</u> in.

6	GROUT PLUG MATERIAL:	1 Neat cement	<input checked="" type="checkbox"/> Cement grout	3 Bentonite	4 Other
	Grout Plug Intervals:	From ft. to ft.,	From ft. to ft.,	From ft. to ft.	
	What is the nearest source of possible contamination:				
	1 Septic tank 6 Seepage pit 11 Fuel storage 16 Other (specify below) 2 Sewer lines 7 Pit privy 12 Fertilizer storage 3 Watertight sewer lines 8 Sewage lagoon 13 Insecticide storage 4 Lateral lines 9 Feedyard 14 Abandoned water well 5 Cess pool 10 Livestock pens 15 Oil well/Gas well				
	Direction from well?	How many feet?			

FROM	TO	PLUGGING MATERIALS
<u>25.37</u>	<u>0</u>	<u>Cement Grout</u>

7	CONTRACTOR'S OR LANDOWNERS CERTIFICATION: This water well was plugged under my jurisdiction and was completed on (mo/day/year) <u>11-12-04</u> and this record is true to the best of my knowledge and belief. Kansas Water Well Contractor's License No. <u>704</u> This Water Well Record was completed on (mo/day/year) <u>2-11-05</u> under the business name of <u>MAX'S</u> by (signature) <u>David Hunk</u>
---	--

INSTRUCTIONS: Use typewriter or ball point pen. Please press firmly and print clearly. Please fill in blanks, underline or circle the correct answers. Send top three copies to Kansas Department of Health and Environment, Bureau of Water, Geology Section, 1000 SW Jackson St., Ste. 420, Topeka, Kansas 66612-1367. Telephone: 785/296-5522. Send one to Water Well Owner and retain one for your records.

R25E

NE

NW

34

35

SE

SW

T10S

T11S

2

NW

MISSOURI RIVER


ConocoPhillips
BARTLESVILLE, OKLAHOMA

KANSAS CITY REFINERY AREA
KANSAS CITY, KANSAS

FIGURE 11

LOCATIONS OF ABANDONED WELLS
AND PIEZOMETERS
SUPPLEMENTAL SITE INVESTIGATION (SSI)

File Name: XX Created By: E. MOLANDER Date Created: JUNE 2005 ©2005 PHILLIPS

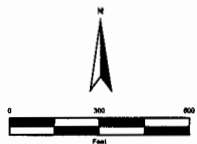

LEGEND

- ABANDONED AND REPLACED 2004/SSI
- ⊕ ABANDONED 2004/SSI
- ⊗ ABANDONED PRE-SSI/2004
- Site Boundary
- Tank
- Basemap

