

CORRECTION(S) TO WATER WELL RECORD (WWC-5)

(to rectify lacking or incorrect information)

County: Wyandotte

Location listed as:

Location changed to:

Section-Township-Range: 34-105-25E

35-105-25E

Fraction ($\frac{1}{4}$ $\frac{1}{4}$ $\frac{1}{4}$): E $\frac{1}{2}$ SW NE

SW SW NW SW

Other changes: Initial statements: _____

Changed to: _____

Comments: _____

verification method: Map of well locations from owner, and
North Kansas City 1:24,000 topo. map.

initials: ERL date: 9/9/2005


submitted by: Kansas Geological Survey, Data Resources Library, 1930 Constant Ave., Lawrence, KS 66047-3726
to: Kansas Dept of Health & Environment, Bureau of Water, 1000 SW Jackson, Suite 420, Topeka, KS 66612-1367.

MV 38B

| | | | | | |
|---|--------------------------|----------------------------|----------------|-----------------|---------------------|
| 1 | LOCATION OF WATER WELL: | Fraction | Section Number | Township Number | Range Number |
| | County: <u>Wyandotte</u> | <u>E 1/4 SW 1/4 NE 1/4</u> | <u>39</u> | <u>10 S</u> | <u>25</u> <u>EW</u> |

Distance and direction from nearest town or city street address of well if located within city?
2029 Fairfax KSKS 66115

2 WATER WELL OWNER: Conoco Phillips Company
 RR #, St. Address, Box #: 1218 Phillips Bldg 420 S. Kecker Ave
 City, State, ZIP Code: Bartlesville OK 74004
 Board of Agriculture, Division of Water Resources
 Application Number: _____

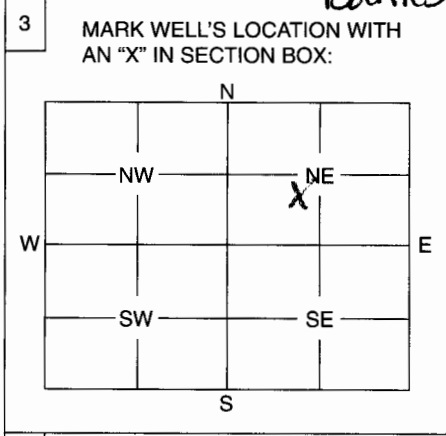

4 DEPTH OF WELL 24.34 ft.
 WELL'S STATIC WATER LEVEL ft.
 WELL WAS USED AS:

| | | |
|--------------|----------------------------|--------------------|
| 1 Domestic | 5 Public Water Supply | 9 Dewatering |
| 2 Irrigation | 6 Oil Field Water Supply | 10 Monitoring Well |
| 3 Feedlot | 7 Domestic (Lawn & Garden) | 11 Injection Well |
| 4 Industrial | 8 Air Conditioning | 12 Other |

Was a chemical / bacteriological sample submitted to Department? Yes No ✓
 If yes, mo/day/yr sample was submitted

Water Well Disinfected: Yes No ✓

5 TYPE OF BLANK CASING USED:

| | | | | |
|---------|------------|-------------------|-----------------|-------------------------|
| 1 Steel | 3 RMP (SR) | 5 Wrought | 7 Fiberglass | 9 Other (Specify below) |
| 2 PVC | 4 ABS | 6 Asbestos-Cement | 8 Concrete Tile | |

Blank casing diameter 2 in. Was casing pulled? Yes ✓ No If yes, how much 11
 Casing height above or below land surface 29 in.

6 GROUT PLUG MATERIAL: 1 Neat cement 2 Cement grout 3 Bentonite 4 Other

Grout Plug Intervals: From 24.34 ft. to 0 ft., From ft. to ft., From to ft.

What is the nearest source of possible contamination:

| | | | |
|--------------------------|-------------------|-------------------------|--------------------------|
| 1 Septic tank | 6 Seepage pit | 11 Fuel storage | 16 Other (specify below) |
| 2 Sewer lines | 7 Pit privy | 12 Fertilizer storage | |
| 3 Watertight sewer lines | 8 Sewage lagoon | 13 Insecticide storage | |
| 4 Lateral lines | 9 Feedyard | 14 Abandoned water well | |
| 5 Cess pool | 10 Livestock pens | 15 Oil well/Gas well | |

Direction from well? How many feet?

| FROM | TO | PLUGGING MATERIALS |
|--------------|----------|---------------------|
| <u>24.34</u> | <u>0</u> | <u>Cement Grout</u> |
| | | |
| | | |
| | | |
| | | |
| | | |

7 CONTRACTOR'S OR LANDOWNER'S CERTIFICATION: This water well was plugged under my jurisdiction and was completed on (mo/day/year) 11-04 and this record is true to the best of my knowledge and belief. Kansas Water Well Contractor's License No. 704 This Water Well Record was completed on (mo/day/year) 2-11-05 under the business name of MAX'S
 by (signature) David Hungih

INSTRUCTIONS: Use typewriter or ball point pen. Please press firmly and print clearly. Please fill in blanks, underline or circle the correct answers. Send top three copies to Kansas Department of Health and Environment, Bureau of Water, Geology Section, 1000 SW Jackson St., Ste. 420, Topeka, Kansas 66612-1367. Telephone: 785/296-5522. Send one to Water Well Owner and retain one for your records.

R 25 E

NE

NW

34

35

SE

SW


T105

T115

2

NW

MISSOURI RIVER

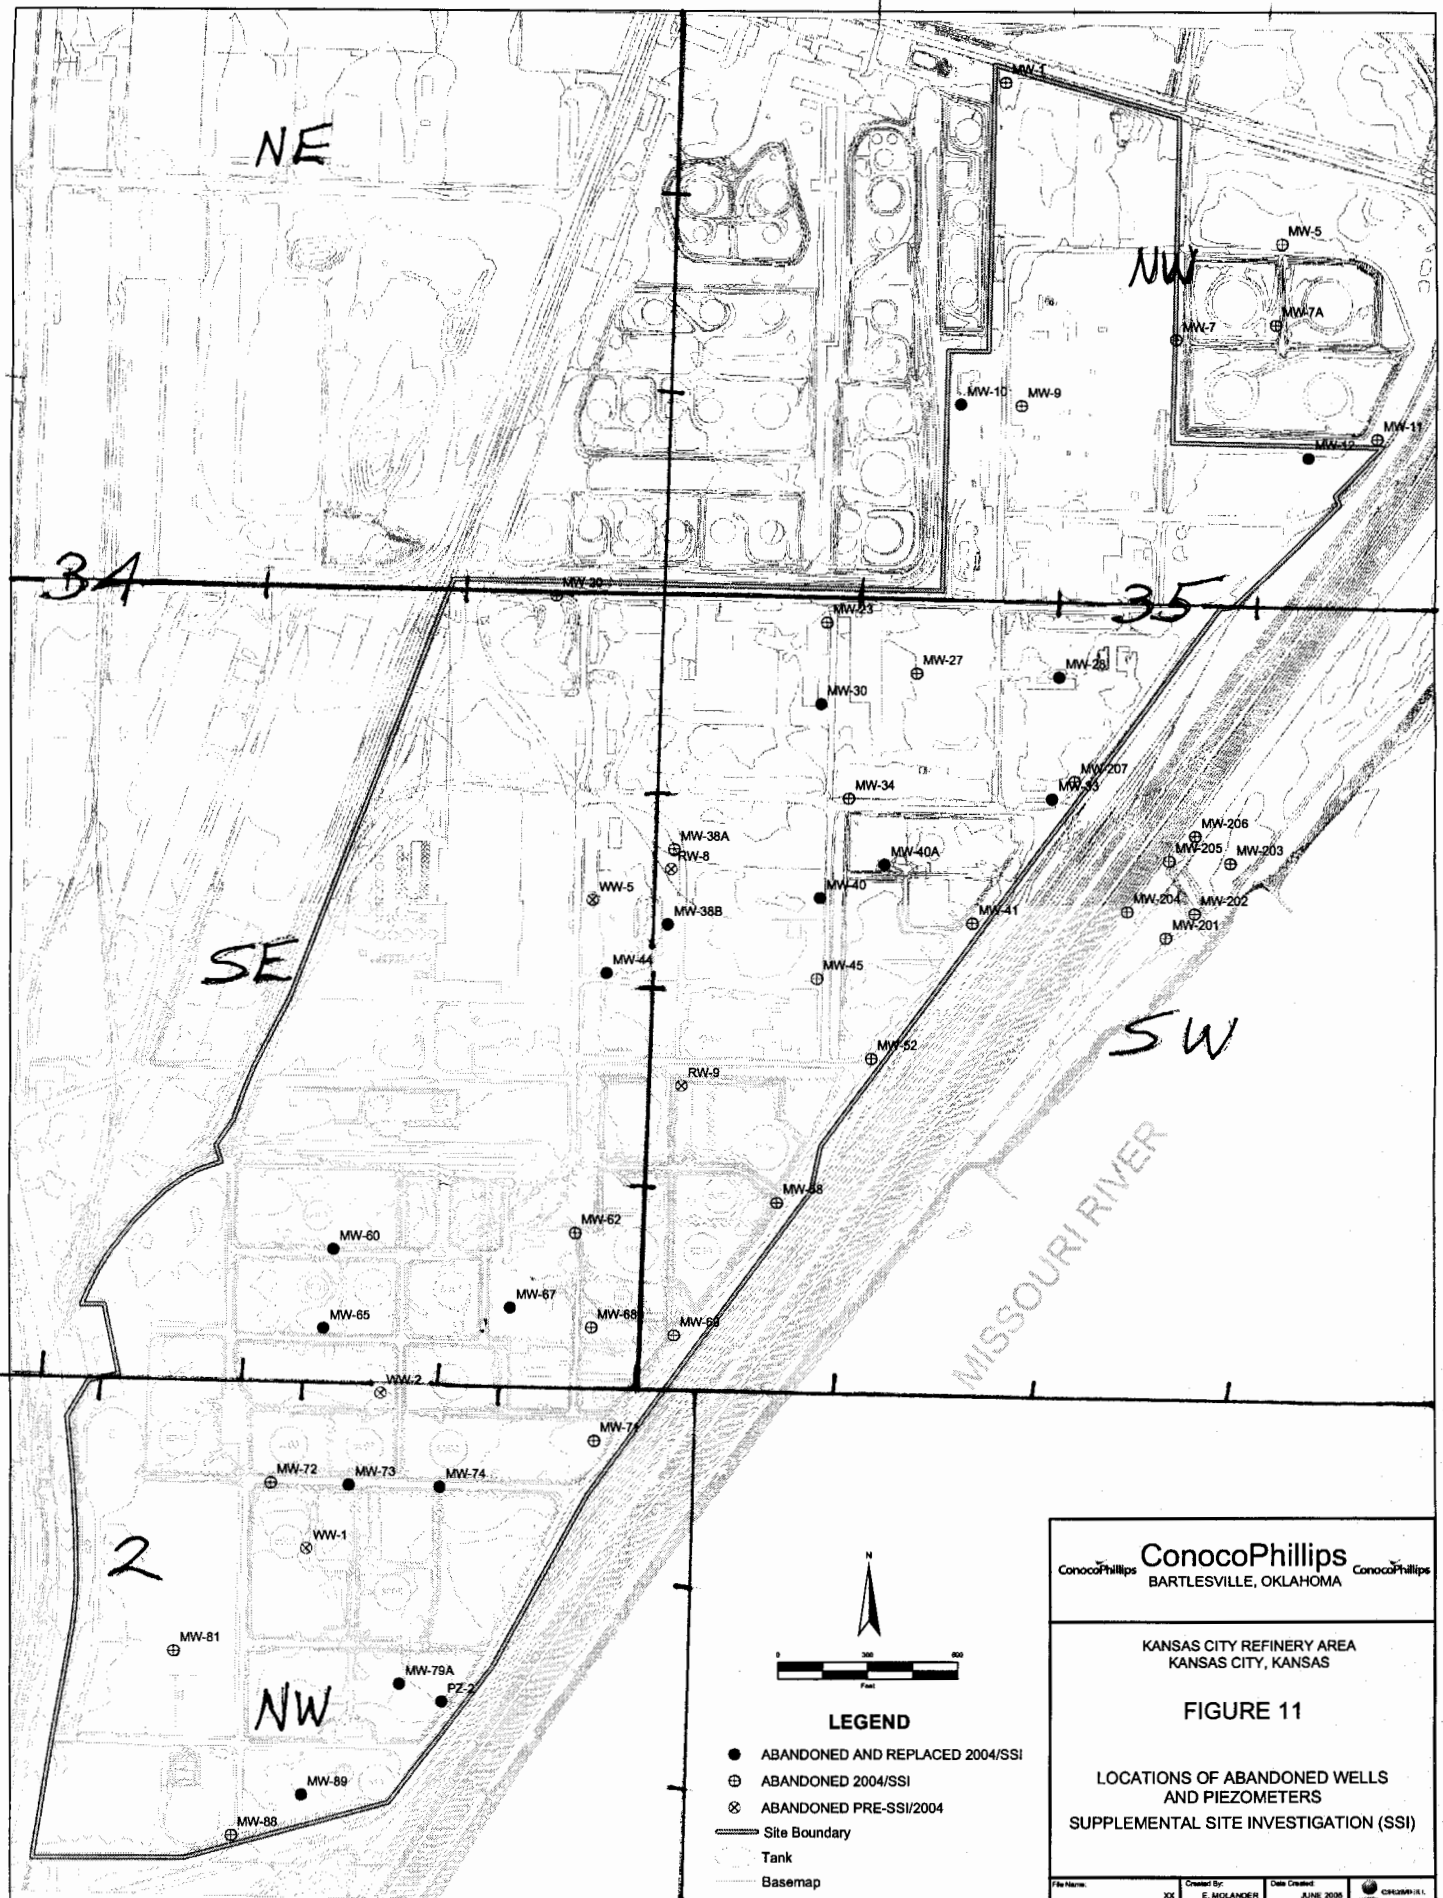

LEGEND

- ABANDONED AND REPLACED 2004/SSI
- ⊕ ABANDONED 2004/SSI
- ⊗ ABANDONED PRE-SSI/2004
- Site Boundary
- Tank
- - - Basemap



ConocoPhillips **ConocoPhillips** ConocoPhillips
 BARTLESVILLE, OKLAHOMA

KANSAS CITY REFINERY AREA
 KANSAS CITY, KANSAS

FIGURE 11

LOCATIONS OF ABANDONED WELLS
 AND PIEZOMETERS
 SUPPLEMENTAL SITE INVESTIGATION (SSI)