

CORRECTION(S) TO WATER WELL RECORD (WWC-5)

(to rectify lacking or incorrect information)

County: Wyandotte

Location listed as:

Location changed to:

Section-Township-Range: 34-10S-25E

35-10S-25E

Fraction ($\frac{1}{4}$ $\frac{1}{4}$ $\frac{1}{4}$): E $\frac{1}{2}$ SE SE

SW SW NW SW

Other changes: Initial statements: _____

Changed to: _____

Comments: _____

verification method: Map of well locations from owner, and

North Kansas City 1:24,000 topo. map.

initials: ORA date: 9/14/2005

R25E

NE

NW

34

35

SE

SW

T10S


T11S


2

NW

MISSOURI RIVER

N.KC
- KC

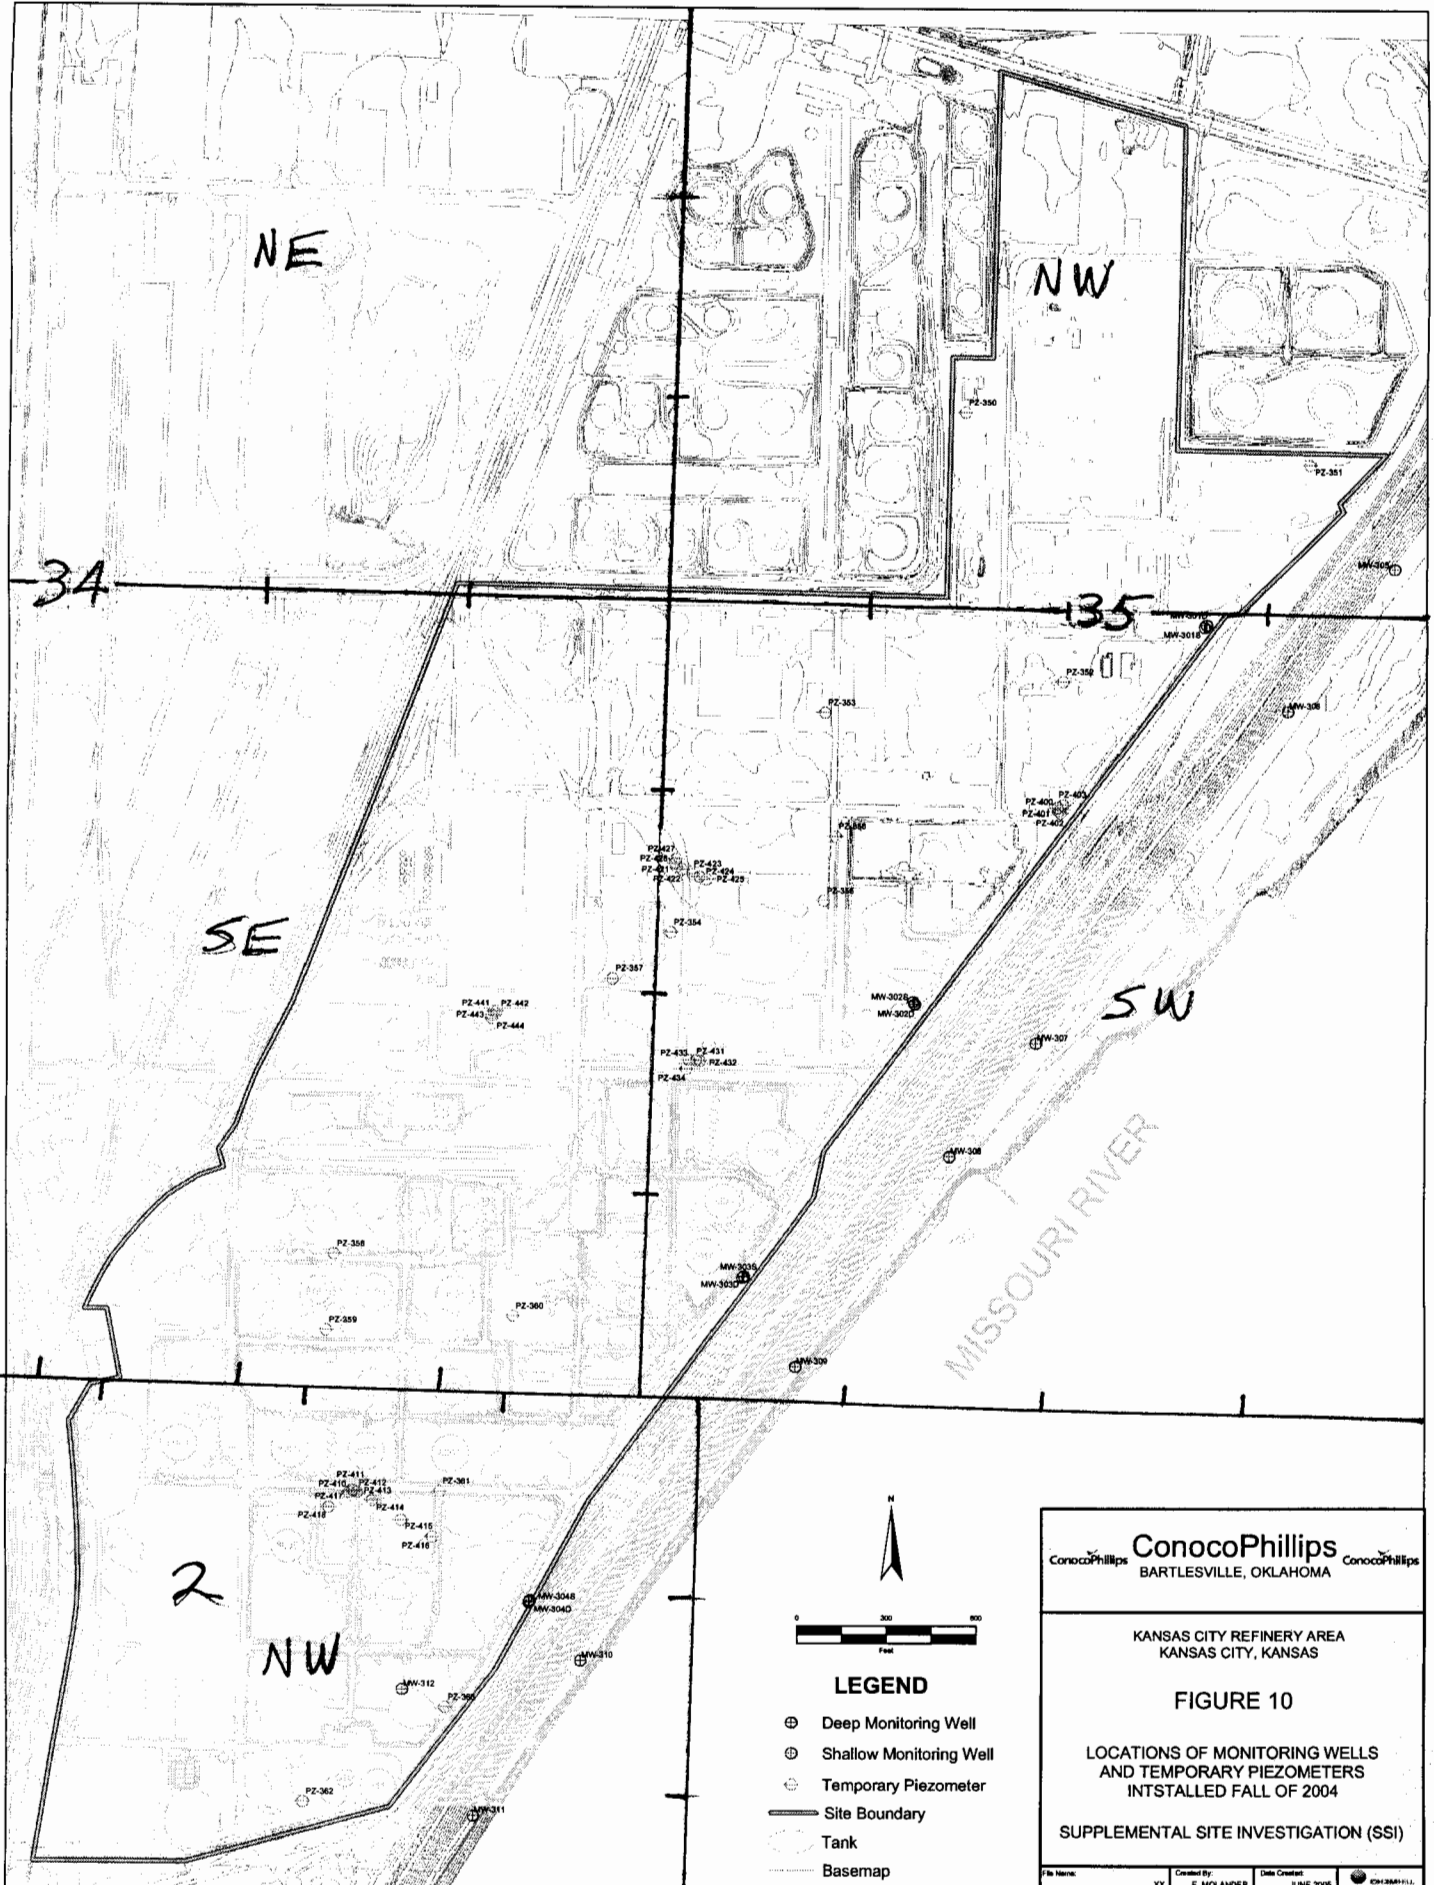


ConocoPhillips
 BARTLESVILLE, OKLAHOMA

KANSAS CITY REFINERY AREA
 KANSAS CITY, KANSAS

FIGURE 10
 LOCATIONS OF MONITORING WELLS
 AND TEMPORARY PIEZOMETERS
 INSTALLED FALL OF 2004
 SUPPLEMENTAL SITE INVESTIGATION (SSI)

File Name: XX Created By: E. MOLANDER Date Created: JUNE 2008 