

CORRECTION(S) TO WATER WELL RECORD (WWC-5)

(to rectify lacking or incorrect information)

County: Wyandotte

Location listed as:

Location changed to:

Section-Township-Range: 22-50N-33W

35-10S-25E

Fraction ($\frac{1}{4}$ $\frac{1}{4}$ $\frac{1}{4}$): NW NW SW

W2 NE SW SW

Other changes: Initial statements: _____

Changed to: _____

Comments: _____

verification method: Map of well locations from owner, and

North Kansas City 1:24,000 topo. map.


initials: DRJ date: 9/8/2005

MW 52

1	LOCATION OF WATER WELL:	Fraction	Section Number	Township Number	Range Number
	County: <u>Wyandotte</u>	<u>N 1/4 Sec 22</u>	<u>22</u>	<u>S 0 N</u>	<u>33</u> EW

Distance and direction from nearest town or city street address of well if located within city?
2029 Fairfax KCKS 66115

2 WATER WELL OWNER: Conoco Phillips Company
 RR #, St. Address, Box #: 1218 Phillips Bldg 420 S. Kecker Ave
 City, State, ZIP Code: Bartlesville OK 74004
 Board of Agriculture, Division of Water Resources
 Application Number: _____

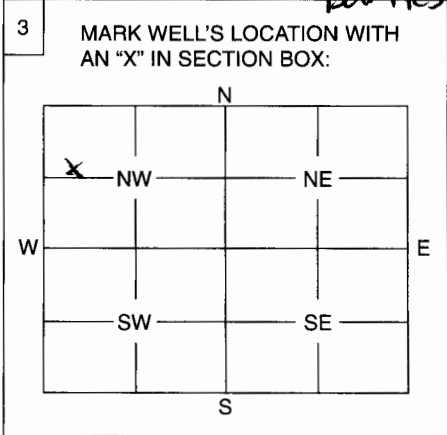

4 DEPTH OF WELL 26.89 ft.
 WELL'S STATIC WATER LEVEL _____ ft.
 WELL WAS USED AS:

1 Domestic	5 Public Water Supply	9 Dewatering
2 Irrigation	6 Oil Field Water Supply	<input checked="" type="checkbox"/> 10 Monitoring Well
3 Feedlot	7 Domestic (Lawn & Garden)	11 Injection Well
4 Industrial	8 Air Conditioning	12 Other _____

Was a chemical / bacteriological sample submitted to Department? Yes _____ No
 If yes, mo/day/yr sample was submitted _____
 Water Well Disinfected: Yes _____ No

5 TYPE OF BLANK CASING USED:

1 Steel	3 RMP (SR)	5 Wrought	7 Fiberglass	9 Other (Specify below)
<input checked="" type="checkbox"/> 2 PVC	4 ABS	6 Asbestos-Cement	8 Concrete Tile	_____

Blank casing diameter 2 in. Was casing pulled? Yes No _____ If yes, how much 10'
 Casing height above or below land surface 29 in.

6 GROUT PLUG MATERIAL: 1 Neat cement Cement grout 3 Bentonite 4 Other _____
 Grout Plug Intervals: From 26.89 ft. to 0 ft., From _____ ft. to _____ ft., From _____ to _____ ft.

What is the nearest source of possible contamination:

1 Septic tank	6 Seepage pit	11 Fuel storage	16 Other (specify below)
2 Sewer lines	7 Pit privy	12 Fertilizer storage	_____
3 Watertight sewer lines	8 Sewage lagoon	13 Insecticide storage	_____
4 Lateral lines	9 Feedyard	14 Abandoned water well	_____
5 Cess pool	10 Livestock pens	15 Oil well/Gas well	_____

Direction from well? _____ How many feet? _____

FROM	TO	PLUGGING MATERIALS
<u>26.89</u>	<u>0</u>	<u>Cement Grout</u>

7 CONTRACTOR'S OF LANDOWNERS CERTIFICATION: This water well was plugged under my jurisdiction and was completed on (mo/day/year) 11-23-09 and this record is true to the best of my knowledge and belief. Kansas Water Well Contractors License No. 2-21-09-704 This Water Well Record was completed on (mo/day/year) _____ under the business name of MAXS by (signature) David Gungl

INSTRUCTIONS: Use typewriter or ball point pen. Please press firmly and print clearly. Please fill in blanks, underline or circle the correct answers. Send top three copies to Kansas Department of Health and Environment, Bureau of Water, Geology Section, 1000 SW Jackson St., Ste. 420, Topeka, Kansas 66612-1367. Telephone: 785/296-5522. Send one to Water Well Owner and retain one for your records.

R25E

NE

NW

34

35

SE

SW



T10S

T11S

2

NW

MISSOURI RIVER

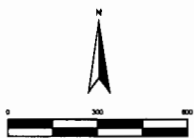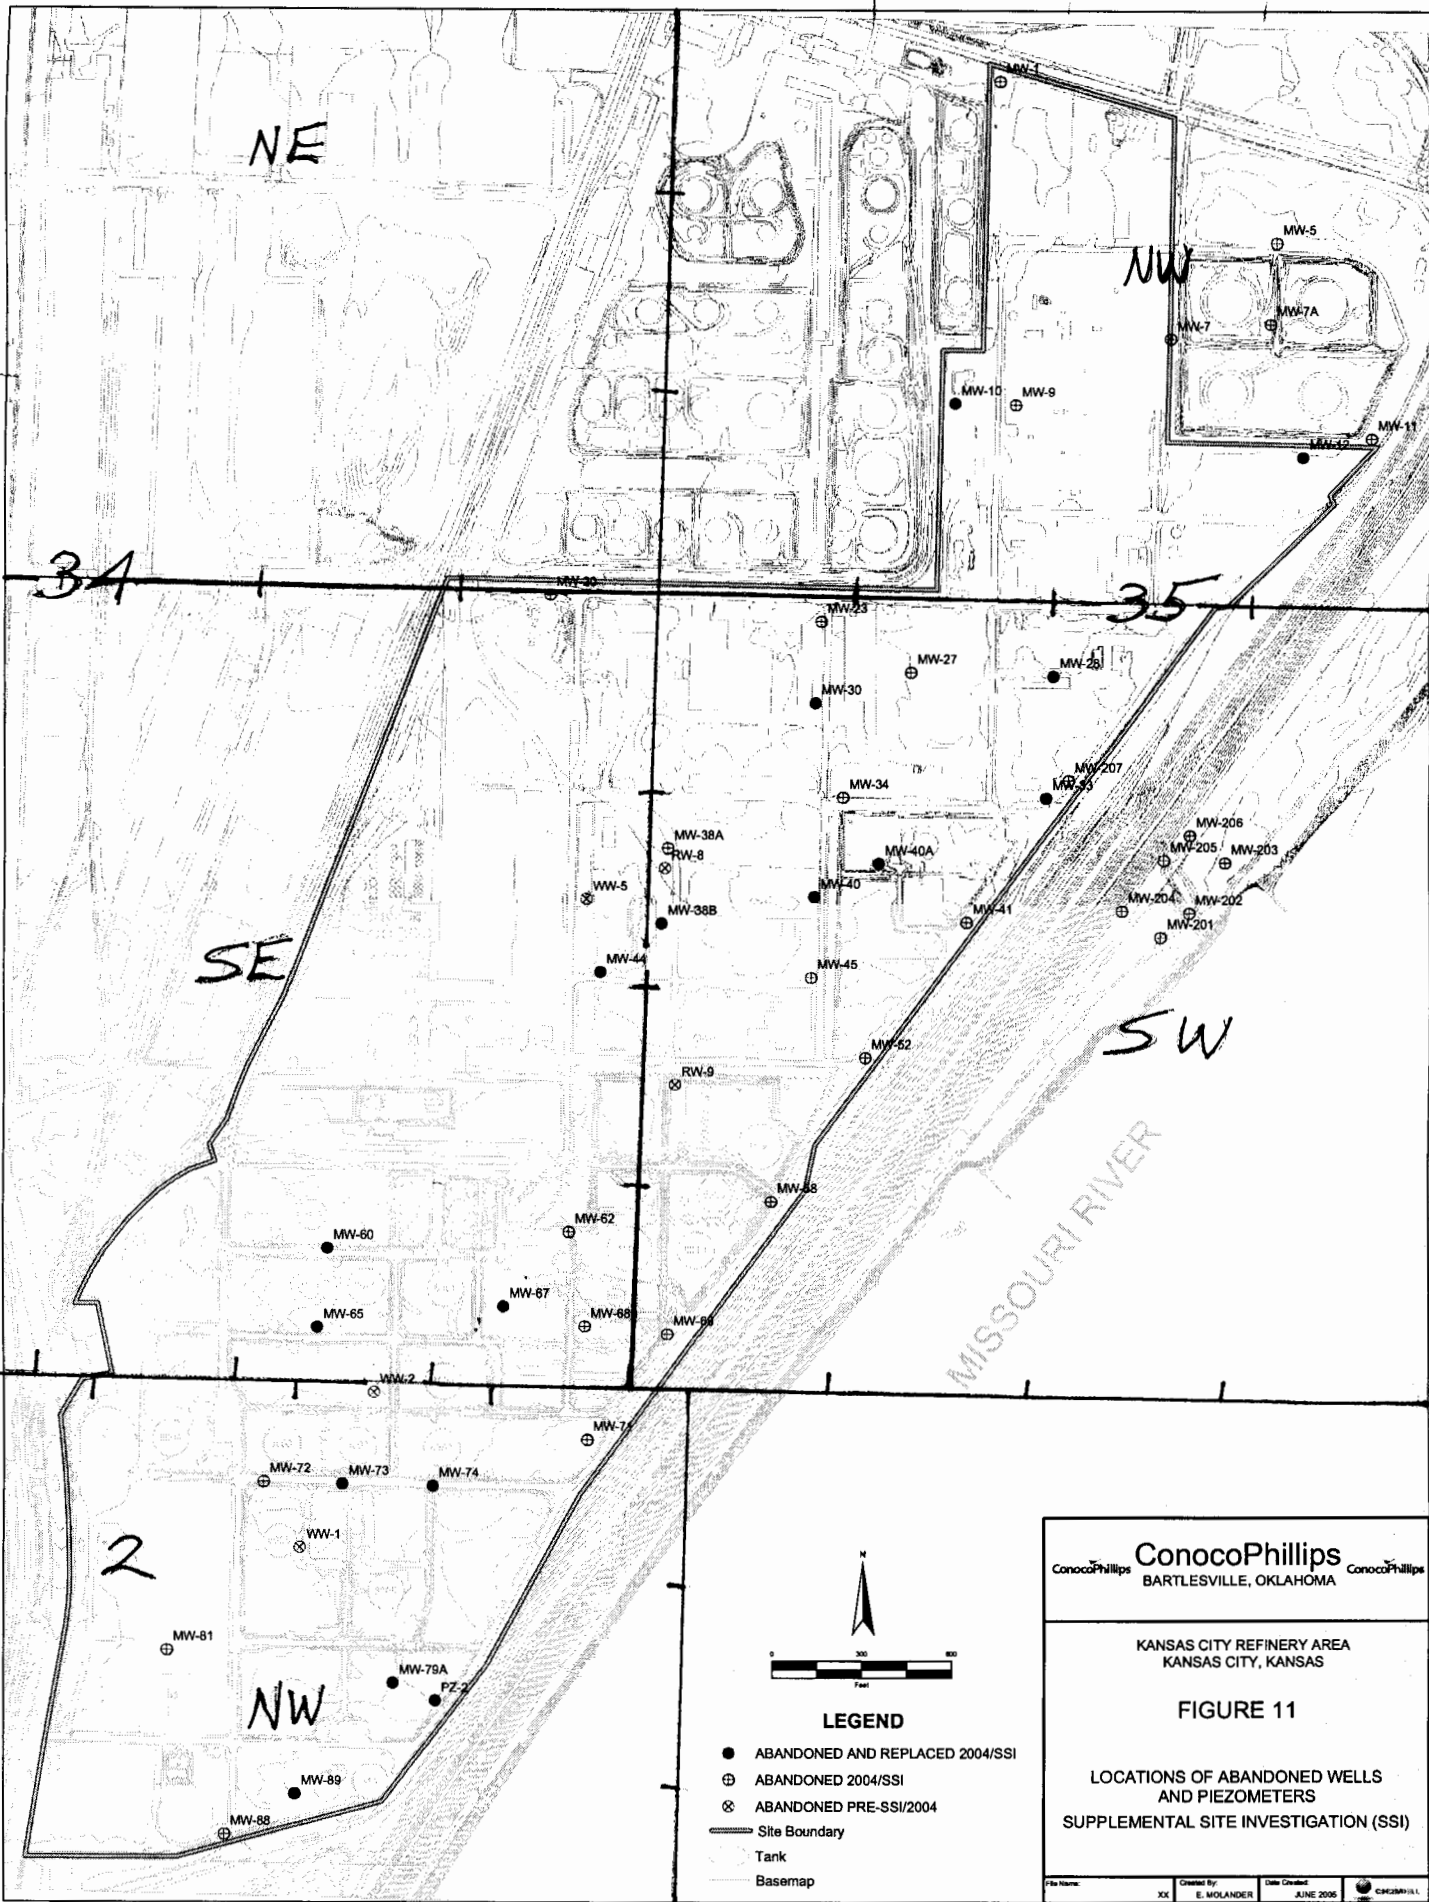

LEGEND

- ABANDONED AND REPLACED 2004/SSI
- ⊕ ABANDONED 2004/SSI
- ⊗ ABANDONED PRE-SSI/2004
- Site Boundary
- Tank
- Basemap

ConocoPhillips <small>ConocoPhillips</small> BARTLESVILLE, OKLAHOMA <small>ConocoPhillips</small>		
KANSAS CITY REFINERY AREA KANSAS CITY, KANSAS		
FIGURE 11 LOCATIONS OF ABANDONED WELLS AND PIEZOMETERS SUPPLEMENTAL SITE INVESTIGATION (SSI)		
File Name:	Created By: E. MOLANDER	Date Created: JUNE 2005