

CORRECTION(S) TO WATER WELL RECORD (WWC-5)

(to rectify lacking or incorrect information)

Location listed as:

Section-Township-Range: 22-50N-33W

Fraction ($\frac{1}{4}$ $\frac{1}{4}$ $\frac{1}{4}$): NW SW SW

County: Wyandotte

Location changed to:

35-10S-25E

S2 NE SW SW

Other changes: Initial statements: _____

Changed to: _____

Comments: _____

verification method: Map of well locations from owner, and

North Kansas City 1:24,000 topo. map.

initials: DRD date: 9/9/2005

submitted by: Kansas Geological Survey, Data Resources Library, 1930 Constant Ave., Lawrence, KS 66047-3726
to: Kansas Dept of Health & Environment, Bureau of Water, 1000 SW Jackson, Suite 420, Topeka, KS 66612-1367.



PROJECT NUMBER 321564.SI.01	BORING NUMBER MW-308	SHEET 1 OF 2
---------------------------------------	--------------------------------	---------------------

SOIL BORING LOG

PROJECT : Conoco Phillips - Supplemental SI	NORTHING: 308470.26	EASTING: 2276552.62
ELEVATION : 744.93 ft b.t.o.c.	DRILLING CONTRACTOR : Max's Enterprises Inc.	
DRILLING METHOD AND EQUIPMENT USED CME 750	LOGGER : E. Molander	
WATER LEVELS : 31-32' bgs during drilling	START : 11/8/04 1045	END : 11/8/04 1115

DEPTH BELOW SURFACE (FT)	INTERVAL (FT)		STANDARD PENETRATION TEST RESULTS 6"-6"-6" (N)	SOIL DESCRIPTION SOIL NAME, USCS GROUP SYMBOL, COLOR, MOISTURE CONTENT, RELATIVE DENSITY, OR CONSISTENCY, SOIL STRUCTURE, MINERALOGY.	COMMENTS DEPTH OF CASING, DRILLING RATE, DRILLING FLUID LOSS, TESTS, AND INSTRUMENTATION. Notes
	RECOVERY (FT)	#/TYPE			
0				0.0': Silty clay (CL), dark brown, moist, firm to stiff, thinly laminated, no odor	
3				3.0': Silty clay with sand (CL), dark brown, moist, sand loosely consolidated, well graded	
4				4.0': Well graded sand with gravel (SW), brown, loose, no odor	
6				6.0': Well graded sand (SW), moist, loose, fine to coarse, no odor	
8				8.0': Poorly graded sand (SP), brown, moist, no odor	
13				13.0': Poorly graded sand (SP), brown, moist, no odor	
24				24.0': Moist, no odor	
26				26.0': Poorly graded sand with clay chunks (SP-SC), brown to gray, , wet, trace coarse sand, no odor	
31				31.0': Encounter water	
34.9				34.9': End of boring	

R25E

NE

NW

34

35

SE

SW

T10S



T11S

2

NW

N. KC
KC

MISSOURI RIVER

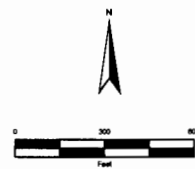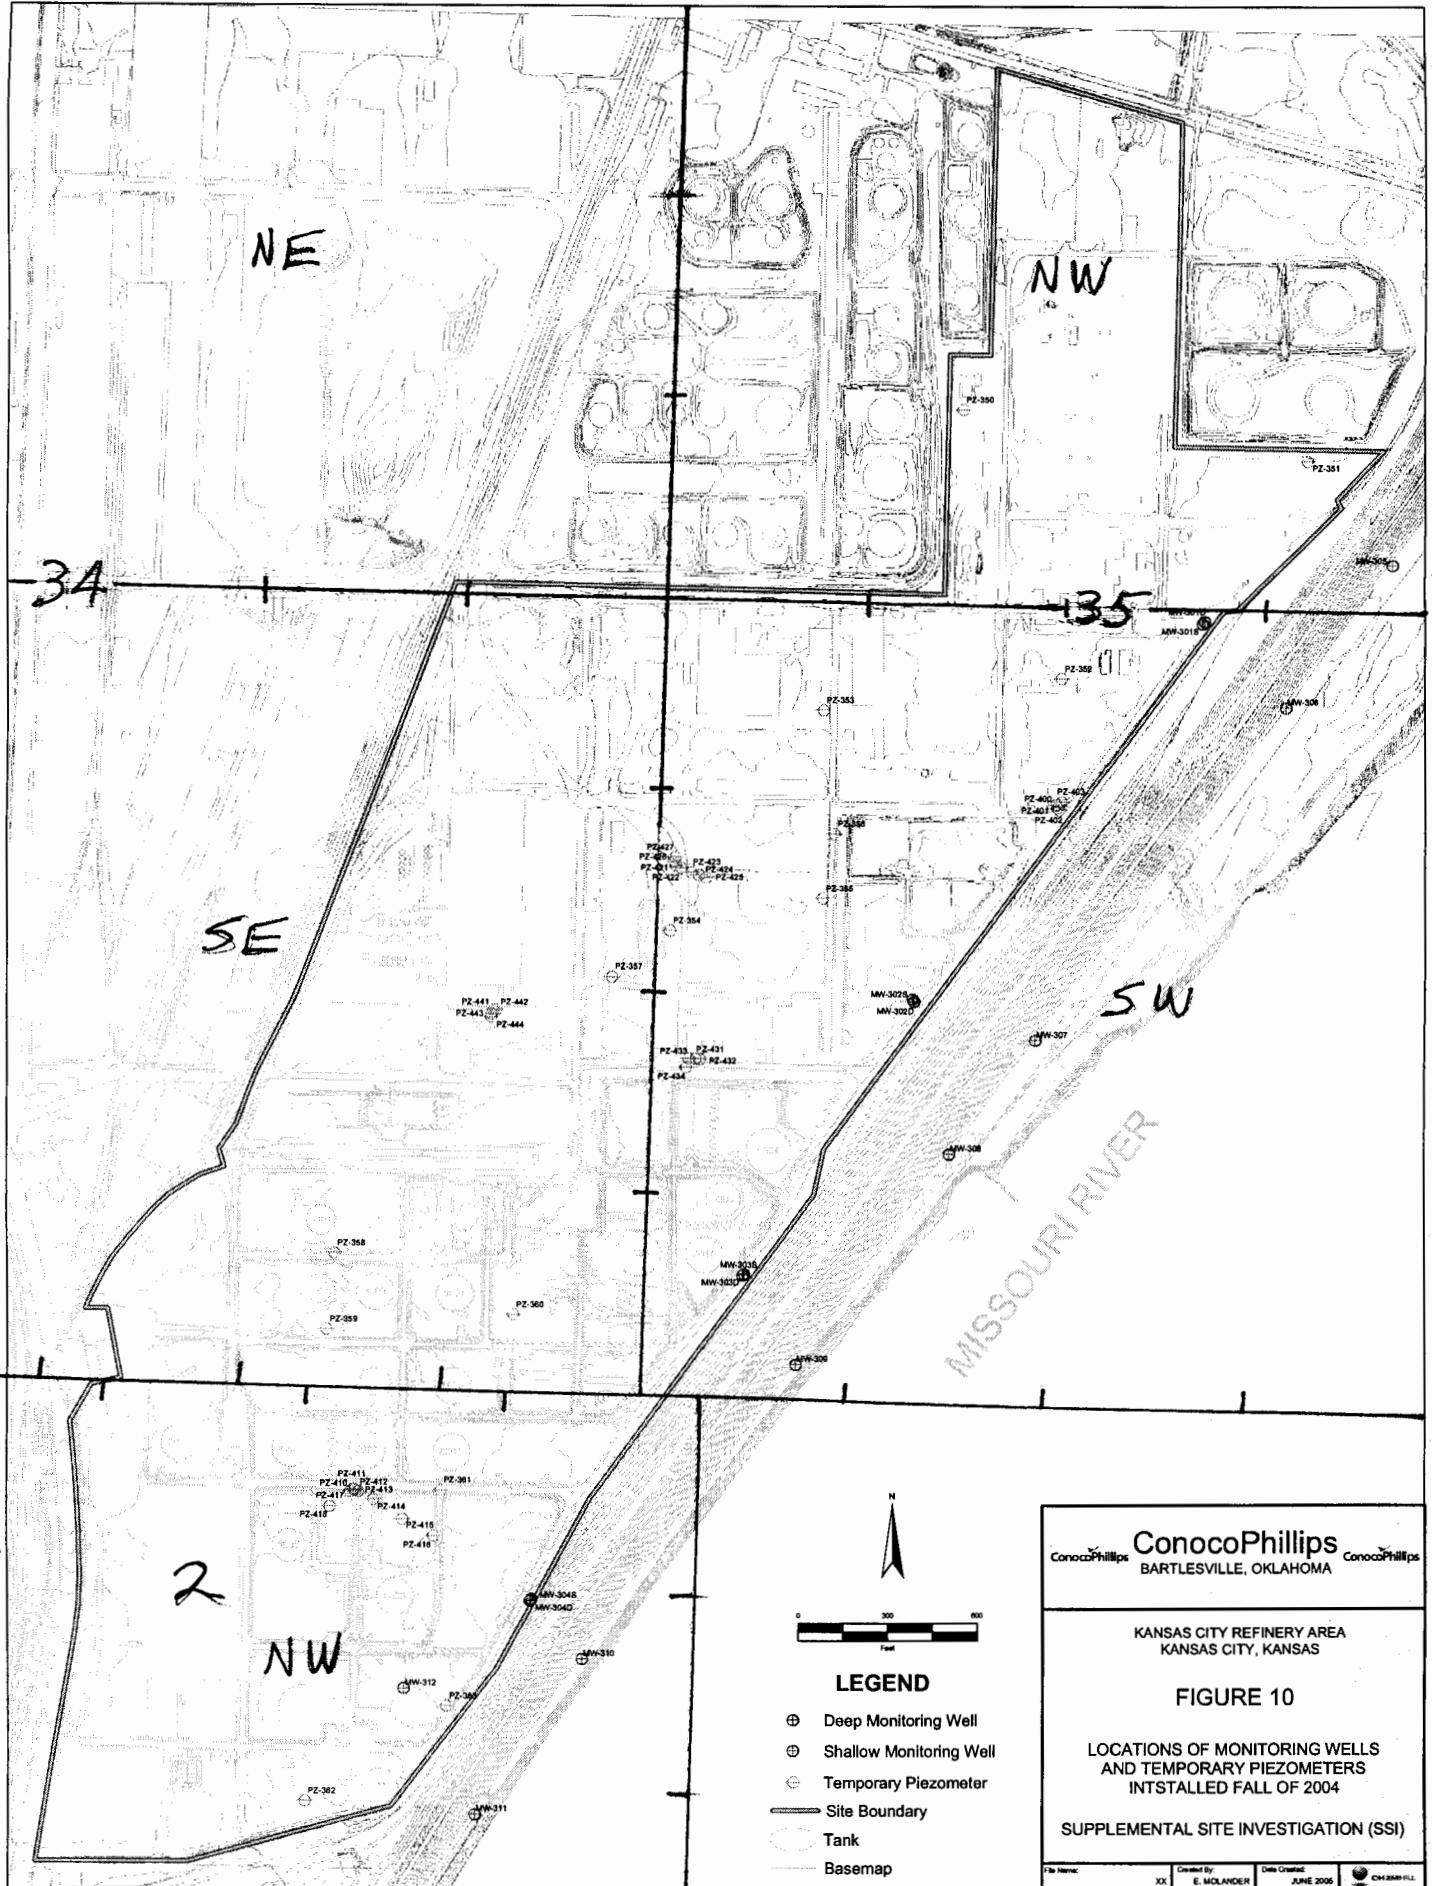

LEGEND

- ⊕ Deep Monitoring Well
- ⊕ Shallow Monitoring Well
- ⊕ Temporary Piezometer
- Site Boundary
- Tank
- Basemap

ConocoPhillips
BARTLESVILLE, OKLAHOMA

KANSAS CITY REFINERY AREA
KANSAS CITY, KANSAS

FIGURE 10

LOCATIONS OF MONITORING WELLS
AND TEMPORARY PIEZOMETERS
INSTALLED FALL OF 2004

SUPPLEMENTAL SITE INVESTIGATION (SSI)

File Name: XX Created By: E. MOLLANDER Date Created: JUNE 2005 CH2200-FLL