

CORRECTION(S) TO WATER WELL RECORD (WWC-5)

(to rectify lacking or incorrect information)

County: Wyandotte

Location listed as:

Location changed to:

Section-Township-Range: 22-50N-33W

35-10S-25E

Fraction ($\frac{1}{4}$ $\frac{1}{4}$ $\frac{1}{4}$): NW SW NE

NE NE SW SW

Other changes: Initial statements: _____

Changed to: _____

Comments: _____

verification method: Map of well locations from owner, and

North Kansas City 1:24,000 topo. map.

initials: DRL date: 9/9/2005

submitted by: Kansas Geological Survey, Data Resources Library, 1930 Constant Ave., Lawrence, KS 66047-3726

to: Kansas Dept of Health & Environment, Bureau of Water, 1000 SW Jackson, Suite 420, Topeka, KS 66612-1367.


MW 307

1 LOCATION OF WATER WELL: Fraction NW 1/4 SW 1/4 NE 1/4 Section Number 22 Township Number T 50 N S Range Number R 33 E/W
 County: Wyandotte

Distance and direction from nearest town or city street address of well if located within city?

2029 Fairfax RCKS 66115

2 WATER WELL OWNER: Conoco Phillips Company
 RR#, St. Address, Box #: 1218 Phillips Bldg 440 S Keeler Ave
 City, State, ZIP Code: Barthesville OK 74004
 Board of Agriculture, Division of Water Resources
 Application Number:

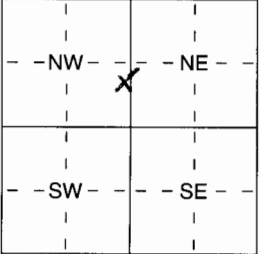3 LOCATE WELL'S LOCATION WITH AN "X" IN SECTION BOX:

 4 DEPTH OF COMPLETED WELL 35 ft. ELEVATION:
 Depth(s) Groundwater Encountered 1 ft. 2 ft. 3 ft.
 WELL'S STATIC WATER LEVEL ft. below land surface measured on mo/day/yr
 Pump test data: Well water was ft. after hours pumping gpm
 Est. Yield gpm: Well water was ft. after hours pumping gpm
 WELL WATER TO BE USED AS:
 1 Domestic 3 Feedlot 6 Oil field water supply 9 Dewatering 12 Other (Specify below)
 2 Irrigation 4 Industrial 7 Domestic (lawn & garden) Monitoring well MW 307
 Was a chemical/bacteriological sample submitted to Department? Yes No ; If yes, mo/day/yr sample was submitted
 Water Well Disinfected? Yes No

5 TYPE OF BLANK CASING USED:
 1 Steel 3 RMP (SR) 5 Wrought iron 8 Concrete tile CASING JOINTS: Glued Clamped
 2 PVC 4 ABS 7 Fiberglass 9 Other (specify below) Welded
 Blank casing diameter in. to 2 in. Dia ft. Dia in. to ft.
 Casing height above land surface Flush main in., weight lbs./ft. Wall thickness or gauge No.
 TYPE OF SCREEN OR PERFORATION MATERIAL:
 1 Steel 3 Stainless Steel 5 Fiberglass 8 RMP (SR) 10 Asbestos-Cement
 2 Brass 4 Galvanized Steel 6 Concrete tile 9 ABS 12 None used (open hole)
 SCREEN OR PERFORATION OPENINGS ARE:
 1 Continuous slot 3 Mill slot 5 Gauzed wrapped 8 Saw cut 11 None (open hole)
 2 Louvered shutter 4 Key punched 6 Wire wrapped 9 Drilled holes
 7 Torch cut 10 Other (specify) ft.
 SCREEN-PERFORATED INTERVALS: From 35 ft. to 25 ft., From ft. to ft.
 GRAVEL PACK INTERVALS: From 35 ft. to 23 ft., From ft. to ft.

6 GROUT MATERIAL: 1 Neat cement Cement grout Bentonite 4 Other 2" Clay 20 Cement grout
 Grout Intervals: From ft. to ft., From ft. to ft.
 What is the nearest source of possible contamination:
 1 Septic tank 4 Lateral lines 7 Pit privy 11 Fuel storage 14 Abandoned water well
 2 Sewer lines 5 Cess pool 8 Sewage lagoon 12 Fertilizer storage 15 Oil well/Gas well
 3 Watertight sewer lines 6 Seepage pit 9 Feedyard 13 Insecticide storage 16 Other (specify below)
 Direction from well? How many feet?

FROM	TO	LITHOLOGIC LOG	FROM	TO	PLUGGING INTERVALS
0	7	Bkn Silty Clay			
7	35	Silty Bkn Sand			

7 CONTRACTOR'S OR LANDOWNER'S CERTIFICATION: This water well was (1) constructed, (2) reconstructed, or (3) plugged under my jurisdiction and was completed on (mo/day/year) 11-8-04 and this record is true to the best of my knowledge and belief. Kansas Water Well Contractor's Licence No 704 This Water Well Record was completed on (mo/day/year) 11-8-04 under the business name of MAXS by (signature) David Henry



PROJECT NUMBER 321564.SI.01	BORING NUMBER MW-307	SHEET 1 OF 1
--------------------------------	-------------------------	--------------

SOIL BORING LOG

PROJECT : Conoco Phillips - Supplemental SI	NORTHING: 308865.00	EASTING: 2276820.30
ELEVATION : 743.45 ft b.t.o.c.	DRILLING CONTRACTOR : Max's Enterprises Inc.	
DRILLING METHOD AND EQUIPMENT USED CME 750	LOGGER : E. Molander	
WATER LEVELS : 32' bgs during drilling	START : 11/8/04 0826	END : 11/8/04 0905

DEPTH BELOW SURFACE (FT)	STANDARD PENETRATION TEST RESULTS		SOIL DESCRIPTION SOIL NAME, USCS GROUP SYMBOL, COLOR, MOISTURE CONTENT, RELATIVE DENSITY, OR CONSISTENCY, SOIL STRUCTURE, MINERALOGY.	COMMENTS DEPTH OF CASING, DRILLING RATE, DRILLING FLUID LOSS, TESTS, AND INSTRUMENTATION. Notes
	INTERVAL (FT)	RECOVERY (FT)		
	#/TYPE	6"-6"-6" (N)		
0.0' - 3.0'			0.0': Clay (CL), dark brown, moist, firm to stiff, highly plastic, organic debris	
3.0' - 4.0'			3.0': Silty clay with trace gravel and sand (CL), dark brown, moist, no odor	
4.0' - 6.0'			4.0': Clayey sand with gravel (SC), brown, moist, loose, fine to medium, well rounded gravel	
6.0' - 7.0'			6.0': Sandy Clay (CL), brown to gray, moist, plastic, no odor	
7.0' - 9.0'			7.0': Sandy silt (ML), brown, moist, semi-plastic, no odor	
9.0' - 12.0'			9.0': Elastic silt (MH), brown, moist, soft, no odor	
12.0' - 15.0'			12.0': Sandy silt (ML), brown, moist, no odor, semi-plastic	
15.0' - 18.0'			15.0': Silty sand (SM), brown, moist, loose, no odor	
18.0' - 21.0'			18.0': Elastic silt (MH), gray, moist, (increasing with depth), soft	
21.0' - 23.0'			21.0': trace fine sand	
23.0' - 27.0'			23.0': Silty sand (SM), gray, wet, no odor, encounter water	
27.0' - 29.0'			27.0': Poorly graded sand (SP), gray, wet, no odor	
29.0' - 34.5'			29.0': Poorly graded sand (SP), gray, medium, coarsening with depth	
34.5' - 35.0'			34.5': End of boring	

R25E

NE

NW

34

135

SE

SW

T10S



T11S

2

NW

MISSOURI RIVER

N. KC
KC

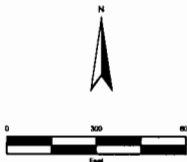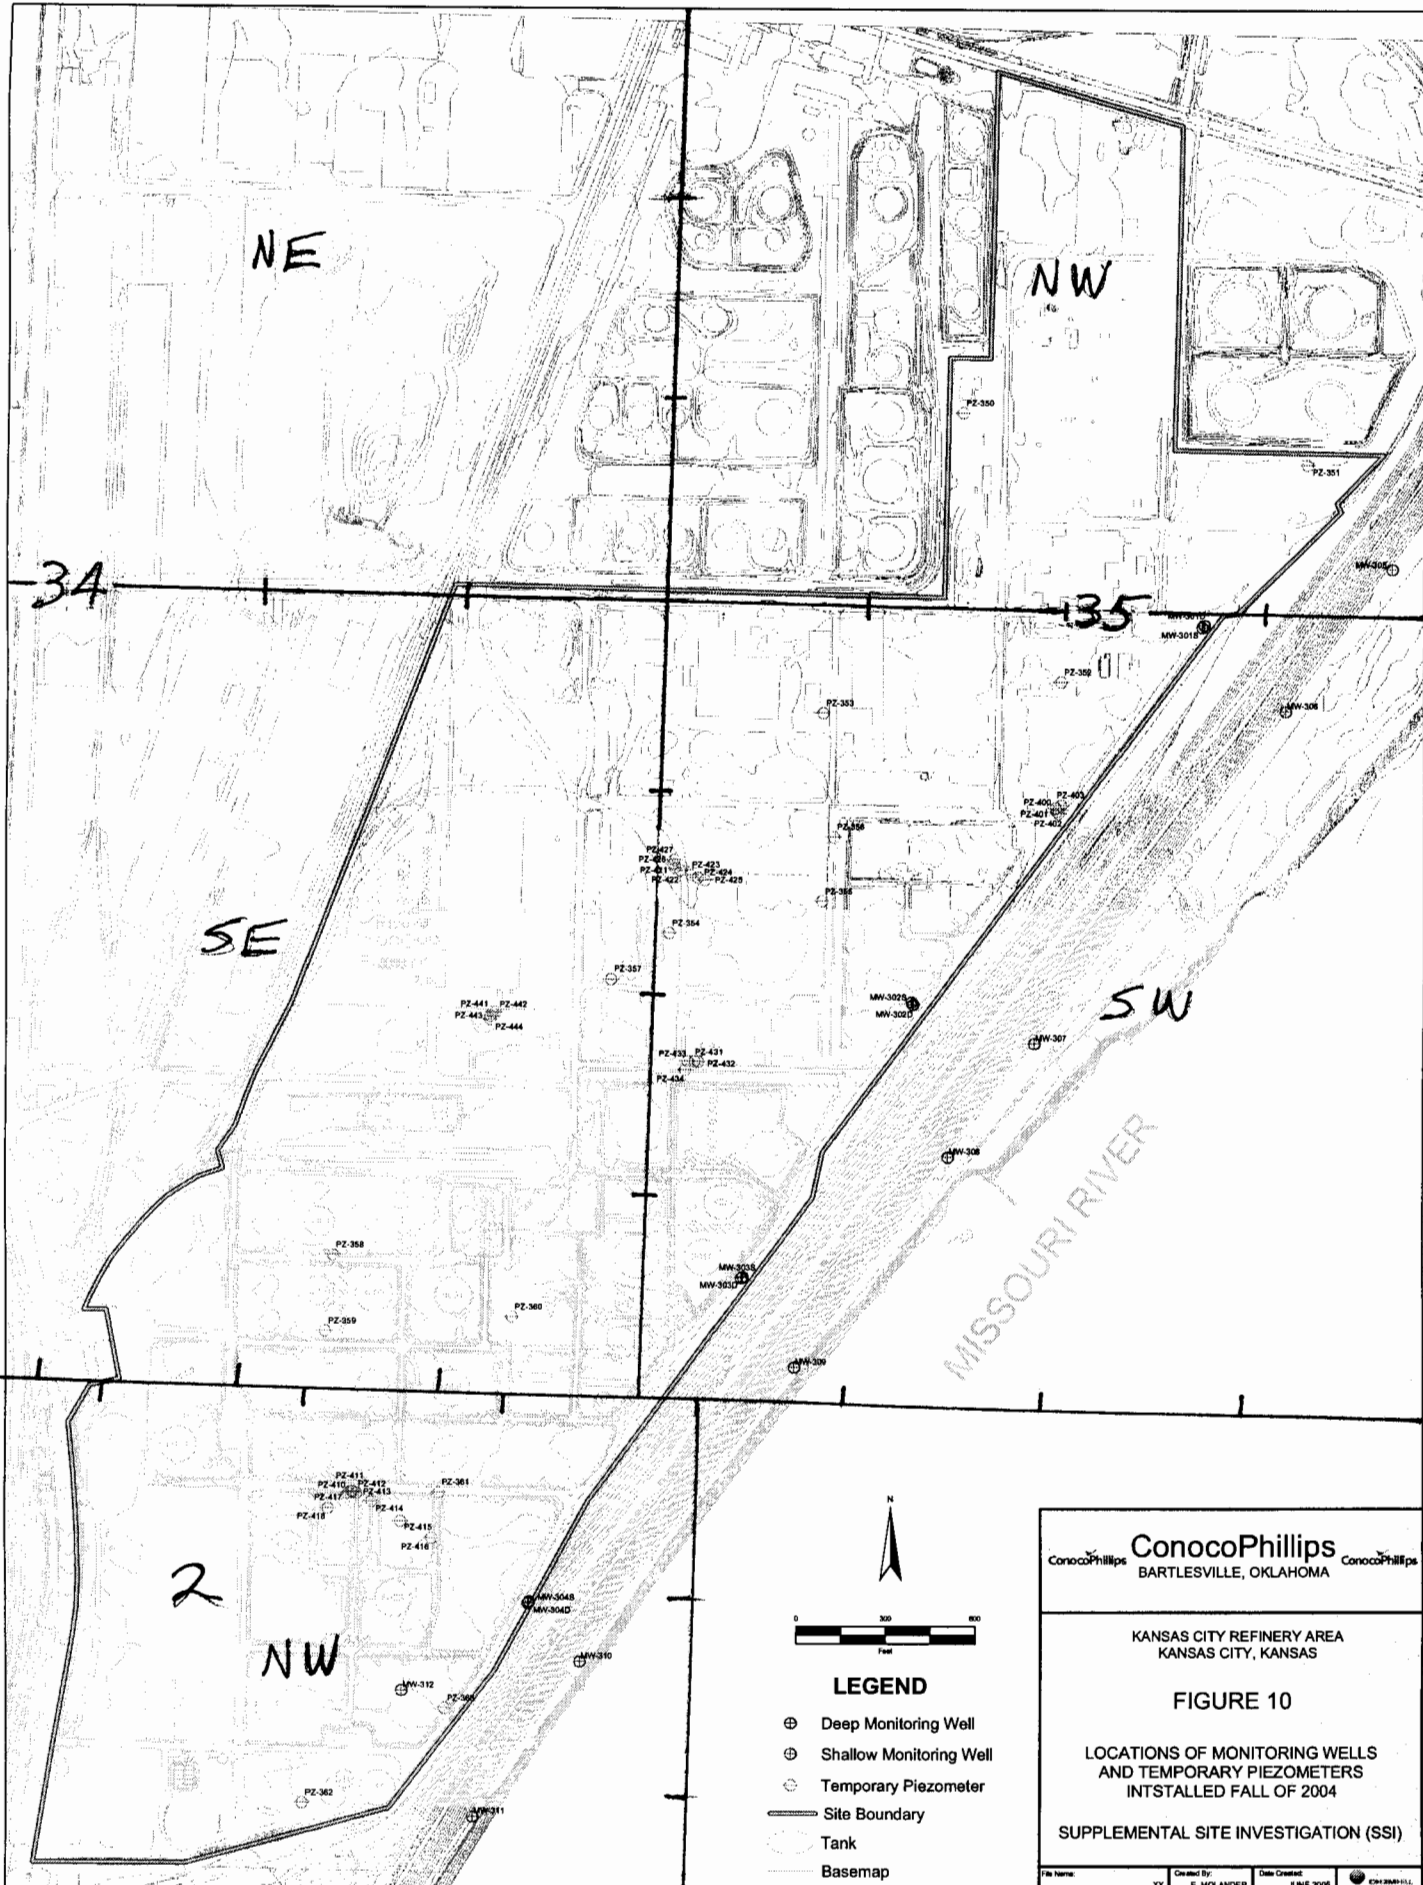

LEGEND

- ⊕ Deep Monitoring Well
- ⊙ Shallow Monitoring Well
- Temporary Piezometer
- Site Boundary
- Tank
- Basemap

ConocoPhillips BARTLESVILLE, OKLAHOMA		
KANSAS CITY REFINERY AREA KANSAS CITY, KANSAS		
FIGURE 10 LOCATIONS OF MONITORING WELLS AND TEMPORARY PIEZOMETERS INSTALLED FALL OF 2004		
SUPPLEMENTAL SITE INVESTIGATION (SSI)		
File Name:	XX	Created By: E. MOLANDER
		Date Created: JUNE 2006