

CORRECTION(S) TO WATER WELL RECORD (WWC-5)

(to rectify lacking or incorrect information)

County: Wyandotte

Location listed as:

Location changed to:

Section-Township-Range: 34-10S-25E

35-10S-25E

Fraction ($\frac{1}{4}$ $\frac{1}{4}$ $\frac{1}{4}$): E $\frac{1}{2}$ SE C

W2 NW SW SW

Other changes: Initial statements: _____

Changed to: _____

Comments: _____

verification method: Map of well locations from owner, and

North Kansas City 1:24,000 topo. map.

initials: ARL date: 9/9/2005

submitted by: Kansas Geological Survey, Data Resources Library, 1930 Constant Ave., Lawrence, KS 66047-3726

to: Kansas Dept of Health & Environment, Bureau of Water, 1000 SW Jackson, Suite 420, Topeka, KS 66612-1367.



PROJECT NUMBER 321564.SI.01	BORING NUMBER PZ-432	SHEET 1 OF 1
SOIL BORING LOG		

PROJECT : Conoco Phillips - Supplemental SI	NORTHING: 308741.29	EASTING: 2275701.10
ELEVATION : 748.34 ft b.t.o.c.	DRILLING CONTRACTOR : Max's Enterprises Inc.	
DRILLING METHOD AND EQUIPMENT USED : CME-750	LOGGER : C. Morris	
WATER LEVELS : 31' bgs	START : 11/22/04 0915	END : 11/22/04 0945

DEPTH BELOW SURFACE (FT)	STANDARD		SOIL DESCRIPTION	COMMENTS
	INTERVAL (FT)	PENETRATION		
	RECOVERY (FT)	6"-6"-6" (N)		DEPTH OF CASING, DRILLING RATE, DRILLING FLUID LOSS, TESTS, AND INSTRUMENTATION.
	#/TYPE			Notes
5	No Soil Sampling		1.0': Silty clay with organic matter and gravel fill (CL), brown, moist, soft 2.0': Poorly graded sand (SP) and silty clay (CL) with gravel, brown, moist, coarse sand, fine gravel 2.5': Concrete 6.0': Sandy gravelly silty clay (CL), grayish brown, moist, medium stiff 8.0': Sandy silt (ML), dark gray to black, moist, fine sand, slight HC odor 10.0': Silty sand (SM), olive gray, moist, fine to medium, HC odor 11.0': Sandy silt with trace clay (ML), dark gray, wet, fine, odor 14.0': Grades moist, more clay 15.0': Poorly graded sand (SP), tan to light gray, moist, fine to medium, HC odor (sweet) 22.0': Grades medium brownish gray, HC odor (gasoline-like) 24.0': Grades light tan to gray 30.0': Well graded sand (SW), light gray, wet, fine to coarse, HC odor (gasoline) 31.0': Encounter water 32.0': Well graded sand (SP), gray, wet to saturated, fine to coarse, HC odor, sheen visible 35.0': End of boring	

R 25 E

NE

NW

34

35

SE

SW

T 10 S



T 11 S

2

NW


MISSOURI RIVER

N. KC
KC

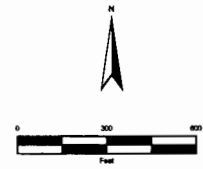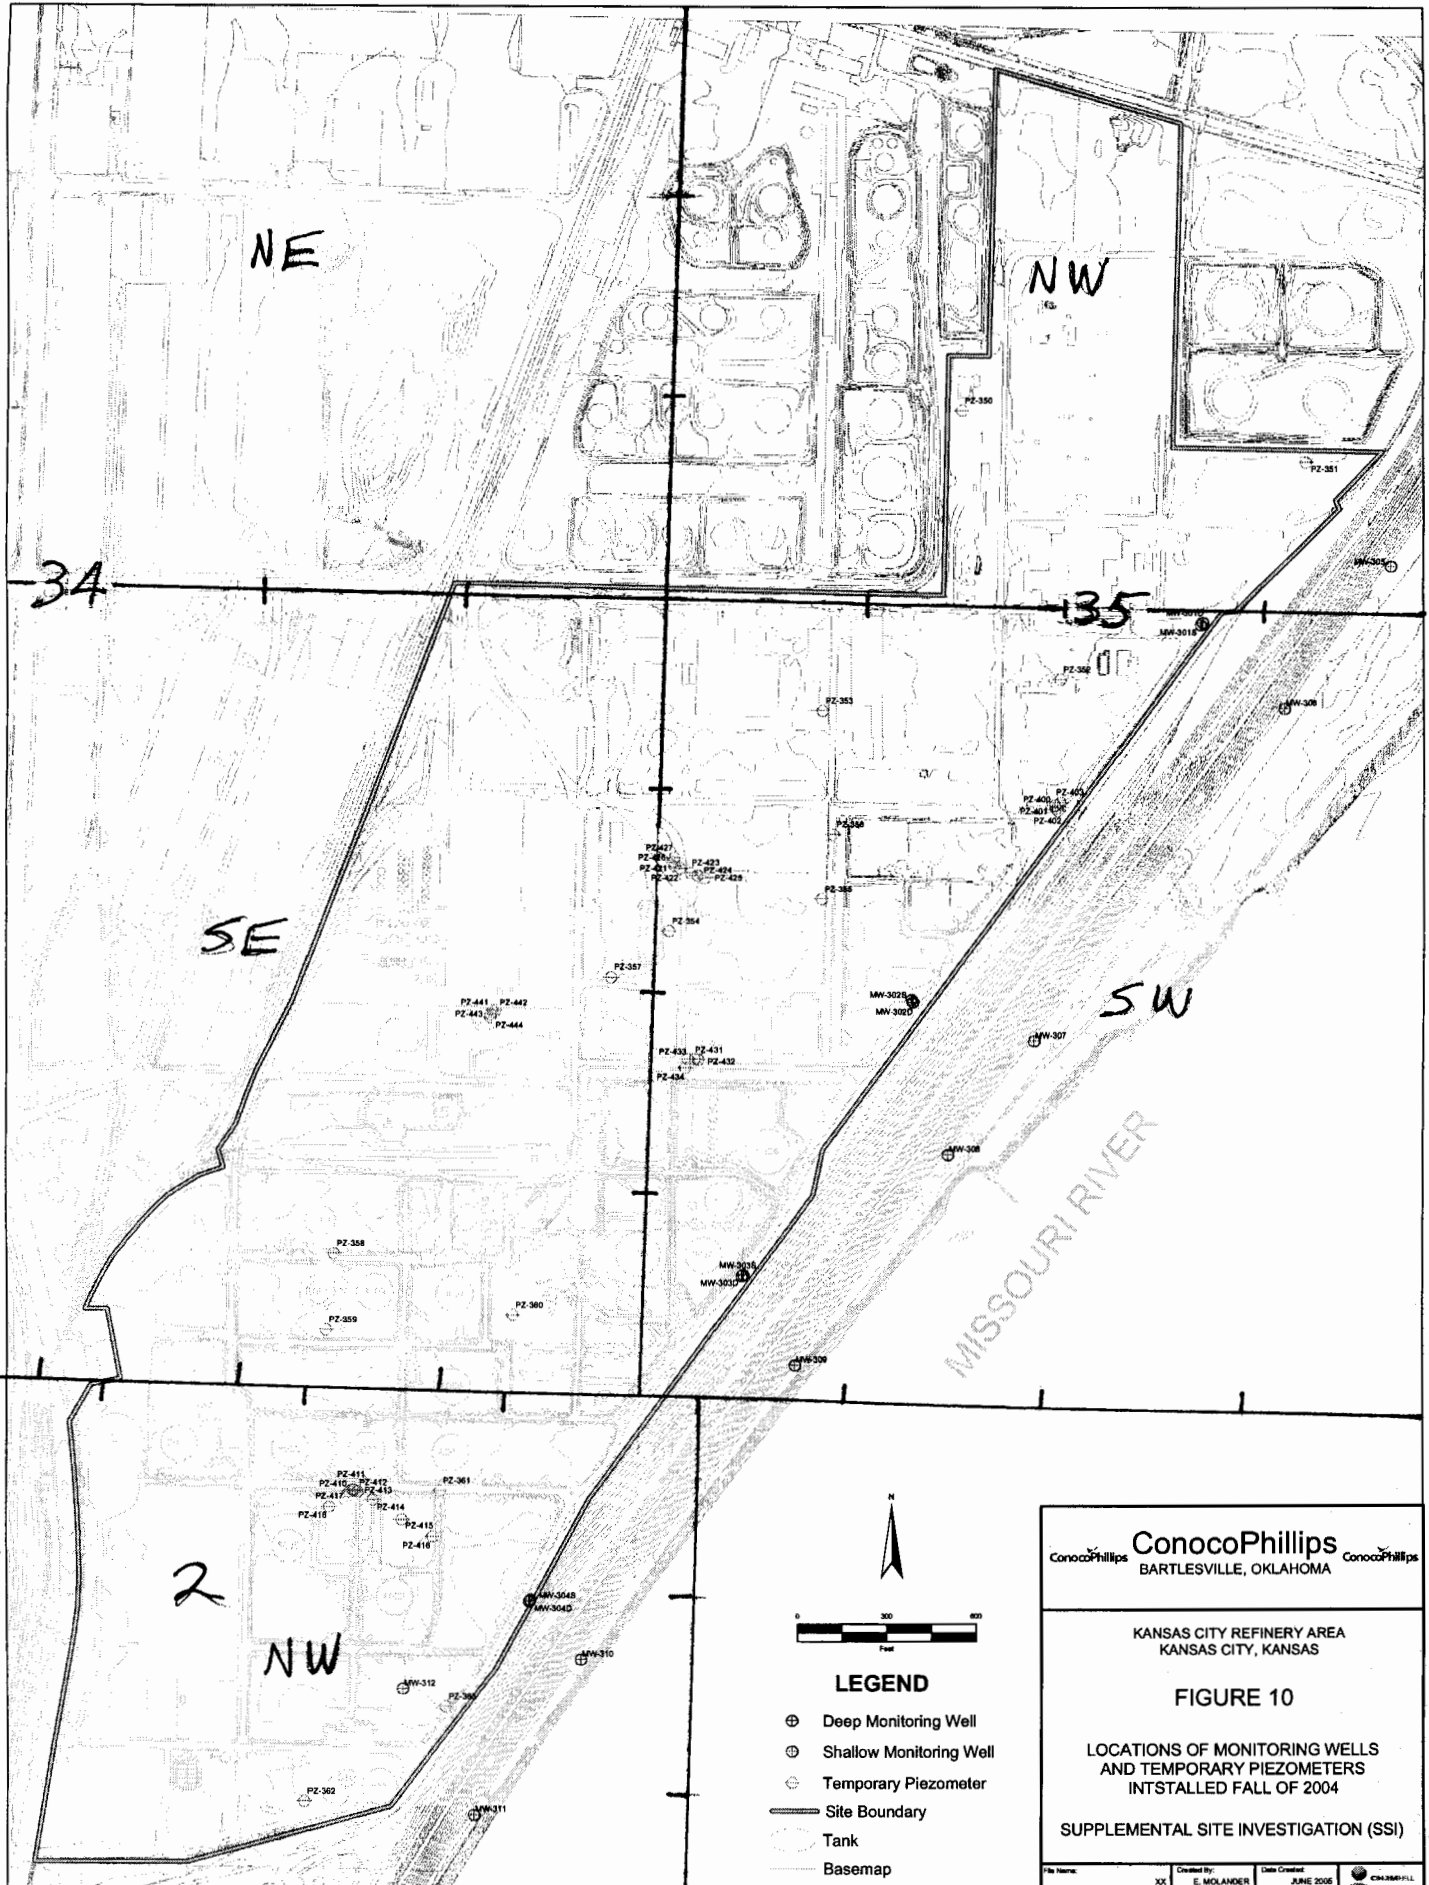

LEGEND

- ⊕ Deep Monitoring Well
- ⊙ Shallow Monitoring Well
- ⊖ Temporary Piezometer
- Site Boundary
- Tank
- Basemap


ConocoPhillips
 BARTLESVILLE, OKLAHOMA

KANSAS CITY REFINERY AREA
 KANSAS CITY, KANSAS

FIGURE 10

LOCATIONS OF MONITORING WELLS
 AND TEMPORARY PIEZOMETERS
 INSTALLED FALL OF 2004

SUPPLEMENTAL SITE INVESTIGATION (SSI)

File Name: XX | Created By: E. MOLANDER | Date Created: JUNE 2006 | CNA366P11