

CORRECTION(S) TO WATER WELL RECORD (WWC-5)

(to rectify lacking or incorrect information)

Location listed as:

Section-Township-Range: 34-10S-25E

Fraction (1/4 1/4 1/4): E 1/2 SE NE

County: Wyandotte

Location changed to:

35-10S-25E

W2 NW SW SW

Other changes: Initial statements: _____

Changed to: _____

Comments: _____

verification method: Map of well locations from owner, and

North Kansas City 1:24,000 topo. map.

initials: DRL date: 9/9/2005

submitted by: Kansas Geological Survey, Data Resources Library, 1930 Constant Ave., Lawrence, KS 66047-3726
to: Kansas Dept of Health & Environment, Bureau of Water, 1000 SW Jackson, Suite 420, Topeka, KS 66612-1367.



PROJECT NUMBER 321564.SI.01	BORING NUMBER PZ-434	SHEET 1 OF 1
SOIL BORING LOG		

PROJECT : Conoco Phillips - Supplemental SI	NORTHING: 308710.25	EASTING: 2275657.95
ELEVATION : 747.60 ft b.t.o.c.	DRILLING CONTRACTOR : Max's Enterprises Inc.	
DRILLING METHOD AND EQUIPMENT USED : CME-750	LOGGER : C. Morris	
WATER LEVELS : 31' bgs	START : 11/23/04 0935	END : 11/23/04 1000

DEPTH BELOW SURFACE (FT)	INTERVAL (FT)		STANDARD PENETRATION TEST RESULTS 6"-6"-6" (N)	SOIL DESCRIPTION	COMMENTS	
	RECOVERY (FT)	#/TYPE				DEPTH OF CASING, DRILLING RATE, DRILLING FLUID LOSS, TESTS, AND INSTRUMENTATION.
1.0				1.0': Silty clay with gravel fill (CL), brown, soft, moist		
4.0				4.0': Grades dark olive gray (stained), slight HC odor		
5.0				5.0': Grades dark gray, slight odor, increasing moisture		
6.0				6.0': Sandy elastic silt (MH), dark gray, moist, soft, slight HC odor		
7.0				7.0': Silty sand with clay (SM-SC), dark olive gray, moist, slight odor		
10.0				10.0': Sandy silt (ML), dark gray, moist, fine, slight odor		
12.0				12.0': Grades wet, trace clay		
14.0				14.0': Silty sand (SM), olive gray, wet, fine to coarse, slight odor		
19.0				19.0': Well graded sand (SW), tan to gray, moist, light HC odor (gasoline-like)		
21.0				21.0': Silty sand (SM)		
26.0				26.0': Well graded sand (SW), tan, moist, strong HC odor		
29.0				29.0': Grades moist to wet		
31.0				31.0': Grades coarse, strong odor, wet to saturated		
35.0				35.0': End of boring		

R 25 E

NE

NW

34

35

SE

SW

T 10 S


T 11 S


2

NW

MISSOURI RIVER

N. KC
KC

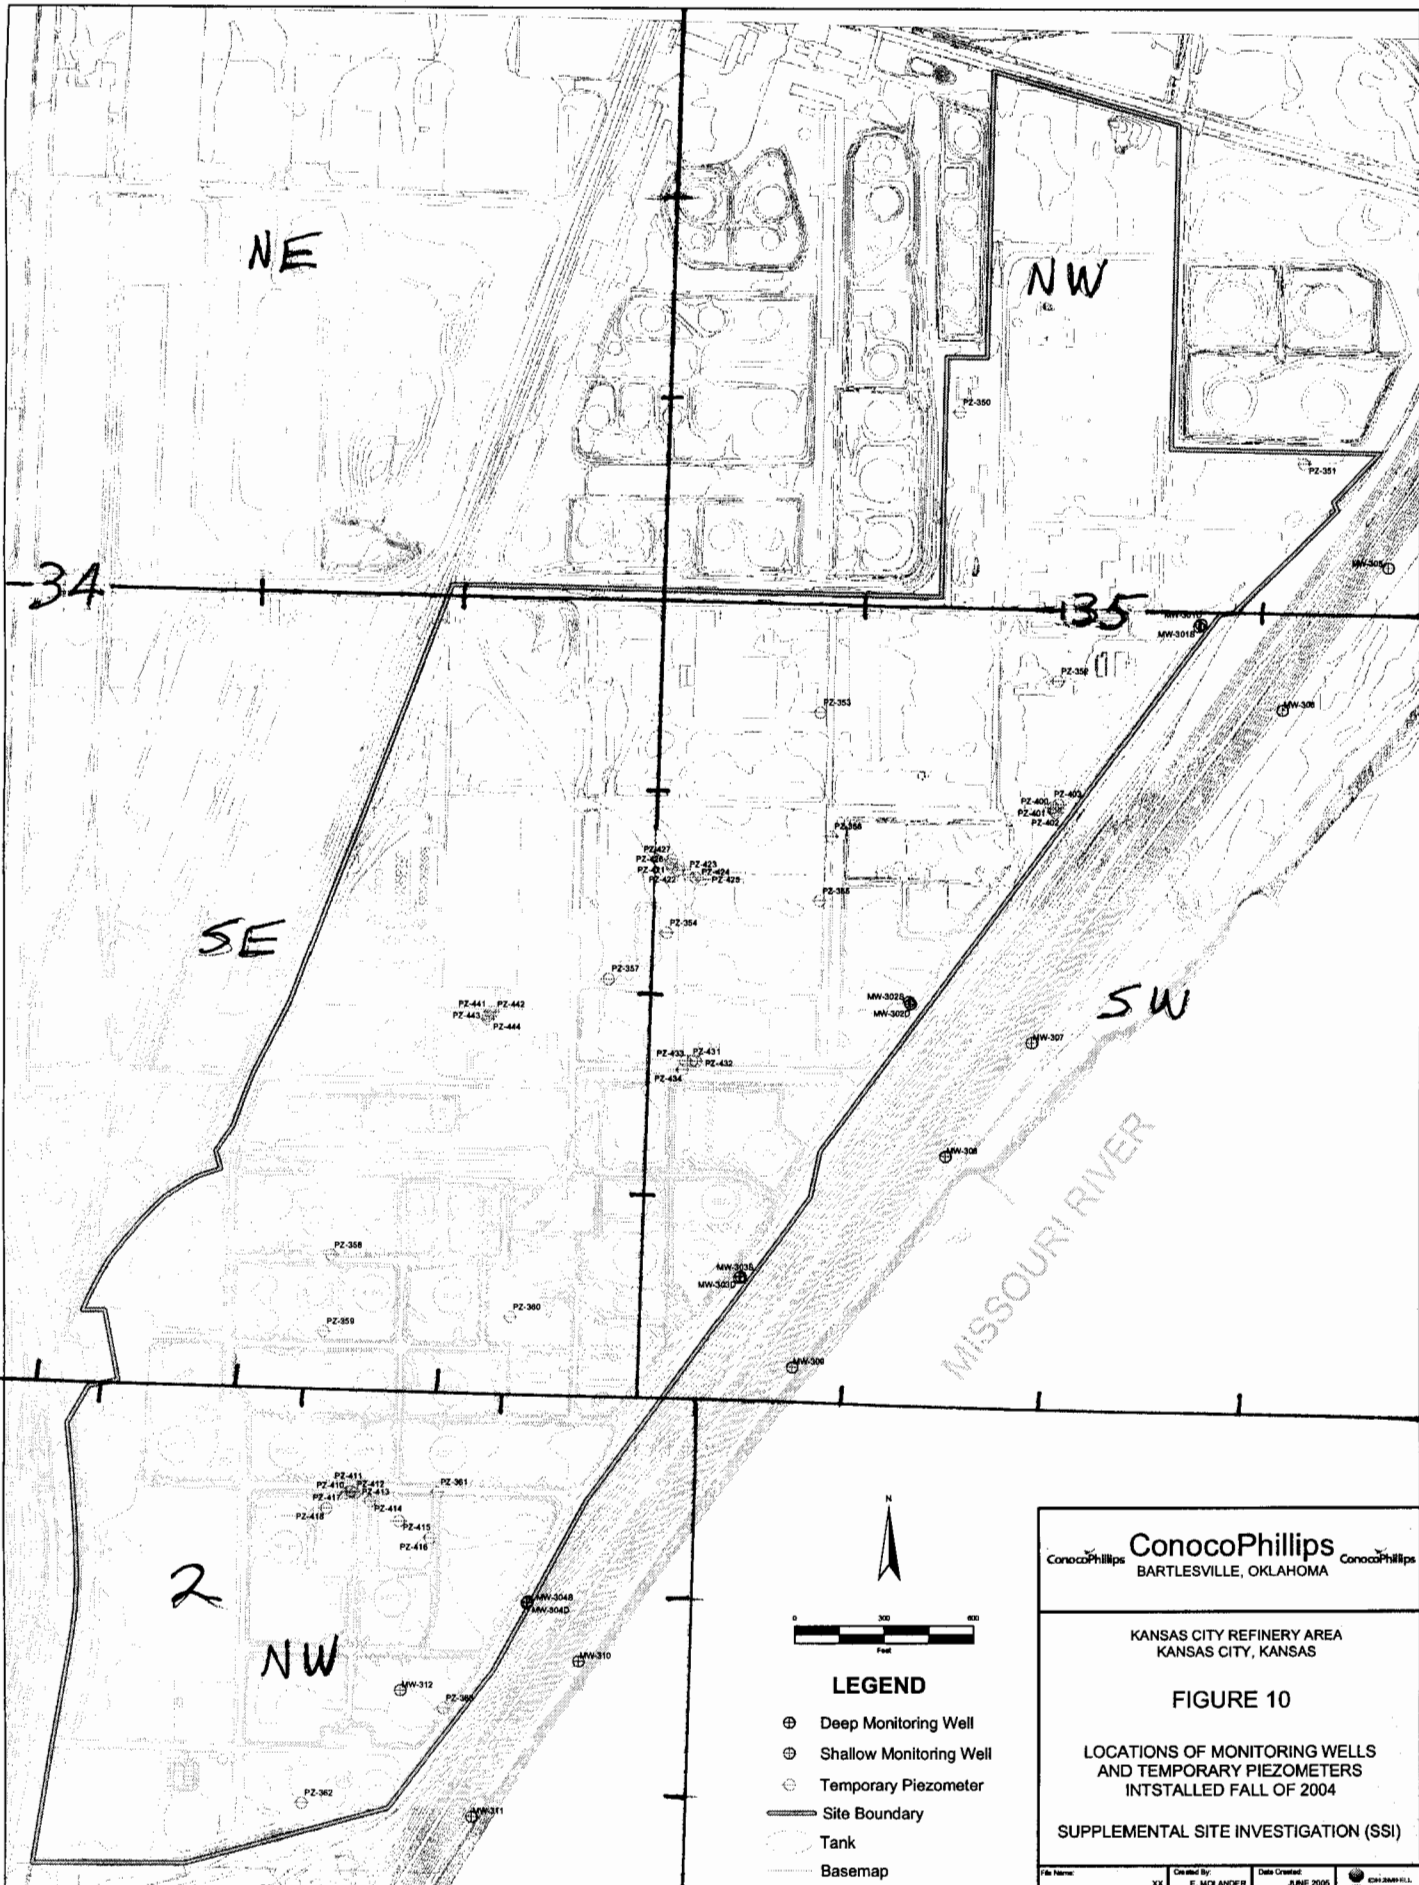


ConocoPhillips
 BARTLESVILLE, OKLAHOMA

KANSAS CITY REFINERY AREA
 KANSAS CITY, KANSAS

FIGURE 10
 LOCATIONS OF MONITORING WELLS
 AND TEMPORARY PIEZOMETERS
 INSTALLED FALL OF 2004

SUPPLEMENTAL SITE INVESTIGATION (SSI)

File Name: XX | Created By: E. MOLANDER | Date Created: JUNE 2005 | 