

CORRECTION(S) TO WATER WELL RECORD (WWC-5)

(to rectify lacking or incorrect information)

Location listed as:

Section-Township-Range: 34-10S-25E

Fraction (  $\frac{1}{4}$   $\frac{1}{4}$   $\frac{1}{4}$ ): E $\frac{1}{2}$  SE SE

County: Wyandotte

Location changed to:

35-10S-25E

SW SW SW

Other changes: Initial statements: \_\_\_\_\_

Changed to: \_\_\_\_\_

Comments: \_\_\_\_\_


verification method: Map of well locations from owner, and

North Kansas City 1:24,000 topo. map.

initials: DRJ date: 9/14/2005

submitted by: Kansas Geological Survey, Data Resources Library, 1930 Constant Ave., Lawrence, KS 66047-3726  
to: Kansas Dept of Health & Environment, Bureau of Water, 1000 SW Jackson, Suite 420, Topeka, KS 66612-1367.



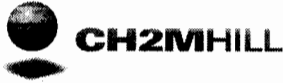

<b>PROJECT NUMBER</b> 321564.SI.01	<b>BORING NUMBER</b> MW-303D
SHEET 1 OF 3	
<b>SOIL BORING LOG</b>	

<b>PROJECT :</b> Conoco Phillips - Supplemental SI	<b>NORTHING:</b> 308028.97	<b>EASTING:</b> 2275884.47
<b>ELEVATION :</b> 748.65 ft b.t.o.c.	<b>DRILLING CONTRACTOR :</b> Max's Enterprises Inc.	
<b>DRILLING METHOD AND EQUIPMENT USED</b> CME 750	<b>LOGGER :</b> C. Morris	
<b>WATER LEVELS :</b> 32.0' bgs during drilling	<b>START :</b> 10/28/04 0840	<b>END :</b> 10/28/04 0925

DEPTH BELOW SURFACE (FT)	INTERVAL (FT)	RECOVERY (FT)	STANDARD PENETRATION TEST RESULTS	SOIL DESCRIPTION	COMMENTS
		#/TYPE	6"-6"-6" (N)	SOIL NAME, USCS GROUP SYMBOL, COLOR, MOISTURE CONTENT, RELATIVE DENSITY, OR CONSISTENCY, SOIL STRUCTURE, MINERALOGY.	DEPTH OF CASING, DRILLING RATE, DRILLING FLUID LOSS, TESTS, AND INSTRUMENTATION.
					Notes
	No Soil Sampling			0.0': Elastic silt with gravel (MH), dark brown, moist, organic material present, some fill light colored	
5				5.0': Silty clay with trace gravel (CL), dark brown, moist, soft, high plasticity, fine gravel	
				7.0': Elastic silt with sand (MH), dark gray brown, wet (saturated at 7'), high plasticity, fine sand	
10				9.0': Sandy elastic silt (MH), dark gray, wet to saturated, high plasticity, fine sand	
15					
				17.0': Silty sand (SM), medium grayish brown, moist, fine to medium	
20					
				22.0': Silty sand (SM), olive brown, moist, fine to medium	
25					
				24.0': Silty sand (SM), olive gray, moist, fine	
				30.0': Silty sand (SM), dark olive gray, moist, fine	



PROJECT NUMBER 321564.S1.01	BORING NUMBER MW-303D	SHEET 2 OF 3
<b>SOIL BORING LOG</b>		

PROJECT : Conoco Phillips - Supplemental SI	NORTHING: 308028.97	EASTING: 2275884.47
ELEVATION : 748.65 ft b.t.o.c.	DRILLING CONTRACTOR : Max's Enterprises Inc.	
DRILLING METHOD AND EQUIPMENT USED CME 750	LOGGER : C. Morris	
WATER LEVELS : 32.0' bgs during drilling	START : 10/28/04 0840	END : 10/28/04 0925

DEPTH BELOW SURFACE (FT)		STANDARD PENETRATION TEST RESULTS 6"-6"-6" (N)	SOIL DESCRIPTION	COMMENTS
INTERVAL (FT)	RECOVERY (FT) #/TYPE			
No Soil Sampling			32.0': Poorly graded sand (SP), olive gray, moisture increasing, saturated at 32', fine	DEPTH OF CASING, DRILLING RATE, DRILLING FLUID LOSS, TESTS, AND INSTRUMENTATION. Notes
35			37.0': Poorly graded sand (SP), dark gray, wet to saturated, fine to medium	
40			42.0': Poorly graded sand with trace gravel (SP), dark gray, very wet (flowing), fine to coarse sand	
45			46.0': Medium gray	
50				

55		55.0': Poorly graded sand with gravel (SP), brownish gray, wet to saturated, some fine black gravel, (coal-like) fracturing	
60			



PROJECT NUMBER 321564.SI.01	BORING NUMBER MW-303D
SHEET 3 OF 3	
<b>SOIL BORING LOG</b>	

PROJECT : Conoco Phillips - Supplemental SI	NORTHING: 308028.97	EASTING: 2275884.47
ELEVATION : 748.65 ft b.t.o.c.	DRILLING CONTRACTOR : Max's Enterprises Inc.	
DRILLING METHOD AND EQUIPMENT USED CME 750	LOGGER : C. Morris	
WATER LEVELS : 32.0' bgs during drilling	START : 10/28/04 0840	END : 10/28/04 0925

DEPTH BELOW SURFACE (FT)	STANDARD PENETRATION TEST RESULTS	SOIL DESCRIPTION	COMMENTS
INTERVAL (FT)	6"-6"-6" (N)	SOIL NAME, USCS GROUP SYMBOL, COLOR, MOISTURE CONTENT, RELATIVE DENSITY, OR CONSISTENCY, SOIL STRUCTURE, MINERALOGY.	DEPTH OF CASING, DRILLING RATE, DRILLING FLUID LOSS, TESTS, AND INSTRUMENTATION.
RECOVERY (FT)	#/TYPE		Notes
<div style="text-align: center;">No Soil Sampling</div>		60.0': Poorly graded sand with gravel (SP), brownish gray, wet to saturated, loose, fine black gravel  65.0': End of boring  Note: When augers removed, significant fine gravel in augers	

R 25 E

NE

NW

34

35

SE

SW

T 10 S


T 11 S


2

NW

MISSOURI RIVER

N. KC  
KC

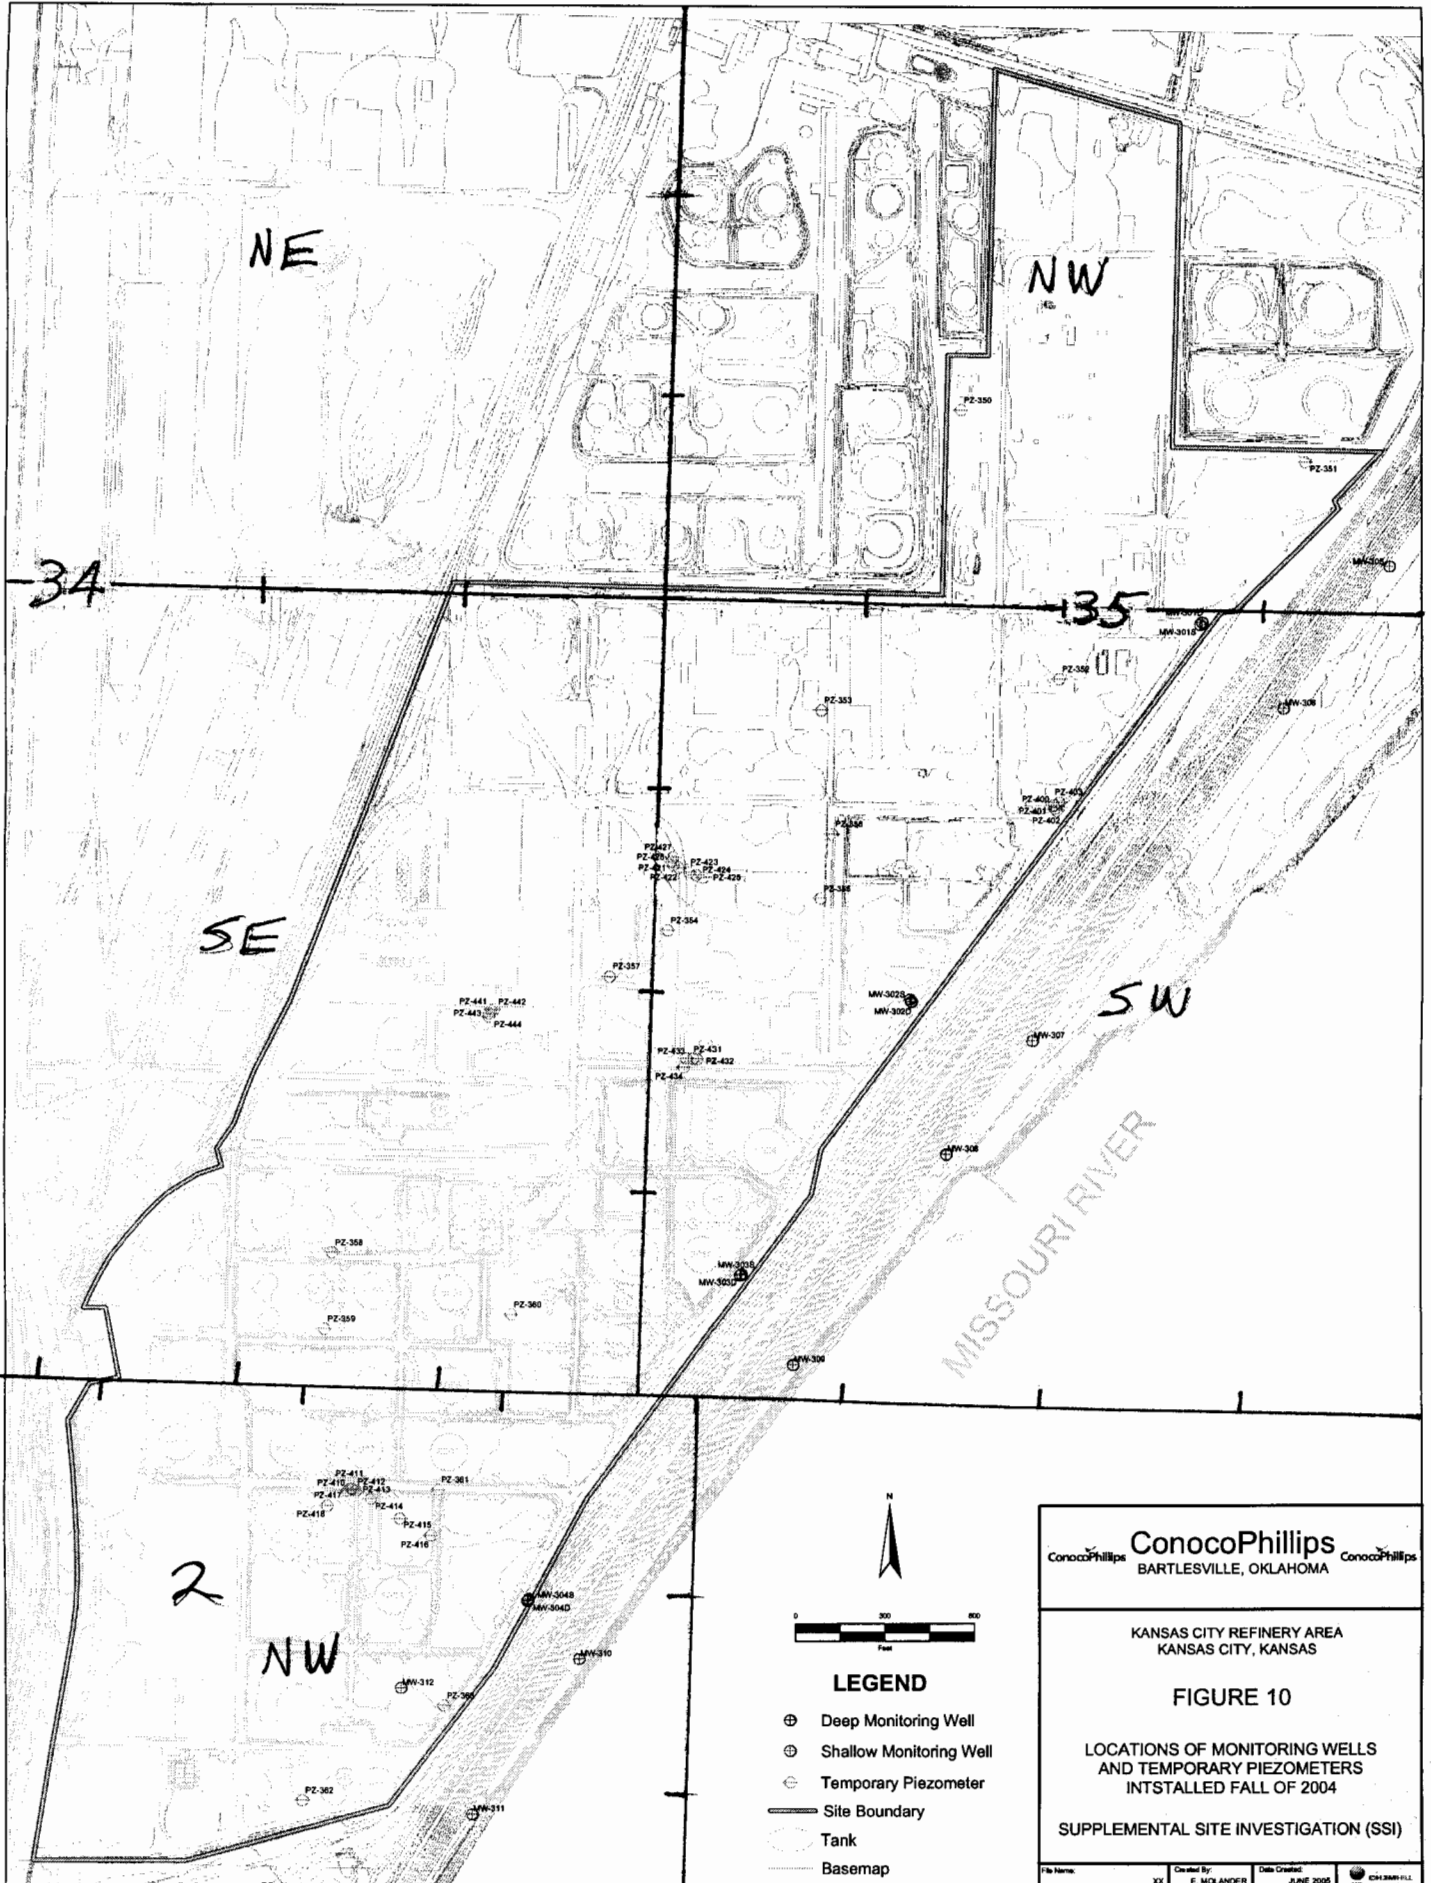


**ConocoPhillips**  
 BARTLESVILLE, OKLAHOMA

---

KANSAS CITY REFINERY AREA  
 KANSAS CITY, KANSAS

**FIGURE 10**  
 LOCATIONS OF MONITORING WELLS  
 AND TEMPORARY PIEZOMETERS  
 INSTALLED FALL OF 2004  
 SUPPLEMENTAL SITE INVESTIGATION (SSI)

File Name: XX    Created by: E. MCLANDER    Date Created: JUNE 2005    CH1388411