

CORRECTION(S) TO WATER WELL RECORD (WWC-5)

(to rectify lacking or incorrect information)

Location listed as:

Section-Township-Range: 34-105-25E

Fraction ($\frac{1}{4}$ $\frac{1}{4}$ $\frac{1}{4}$): E $\frac{1}{2}$ SE SE

County: Wyandotte

Location changed to:

35-105-25E

SW SW SW

Other changes: Initial statements: _____

Changed to: _____

Comments: _____

verification method: Map of well locations from owner, and

North Kansas City 1:24,000 topo. map.

initials: ARL date: 9/14/2005

submitted by: Kansas Geological Survey, Data Resources Library, 1930 Constant Ave., Lawrence, KS 66047-3726

to: Kansas Dept of Health & Environment, Bureau of Water, 1000 SW Jackson, Suite 420, Topeka, KS 66612-1367.



PROJECT NUMBER 321564.SI.01	BORING NUMBER MW-303S	SHEET 1 OF 1
SOIL BORING LOG		

PROJECT : Conoco Phillips - Supplemental SI	NORTHING: 308034.48 EASTING: 2275888.62
ELEVATION : 748.65 ft b.t.o.c.	DRILLING CONTRACTOR : Max's Enterprises Inc.
DRILLING METHOD AND EQUIPMENT USED : CME 750 ATV, HSA	LOGGER : C. Morris
WATER LEVELS : 32' bgs	START : 10/27/04 1625 END : 10/27/04 1655

DEPTH BELOW SURFACE (FT)		STANDARD PENETRATION TEST RESULTS	SOIL DESCRIPTION	COMMENTS
INTERVAL (FT)	RECOVERY (FT) #/TYPE			
		6"-6"-6" (N)	SOIL NAME, USCS GROUP SYMBOL, COLOR, MOISTURE CONTENT, RELATIVE DENSITY, OR CONSISTENCY, SOIL STRUCTURE, MINERALOGY.	DEPTH OF CASING, DRILLING RATE, DRILLING FLUID LOSS, TESTS, AND INSTRUMENTATION. Notes
	No Soil Sampling		0.0': Silty clay (CL), brown, dry, soft, topsoil, medium plasticity, some organic material, fill/gravel, no odor	
5			5.0': Sandy silty clay (CL), brown, moist, soft, plastic, no odor	
10			9.0': Saturated 10.0'-17.0': Occasional gravel, grading to more fine silts and sands, moist	
15			17.0': Silty sand (SM), moist	
20			19.0': Poorly graded sand (SP), fine	
25			22.0': Sand (SP), gray, moist, fine to medium sand	
			27.0': Poorly graded sand (SP), dark gray, moist, fine to medium	
			30.0': Poorly graded sand (SP), dark gray, wet, fine to medium	
			32.0': Saturated	
35			35.0': End of boring	

R 25 E

NE

NW

34

35

SE

SW

T 10 S


T 11 S


2

NW

MISSOURI RIVER

N. KC
KC

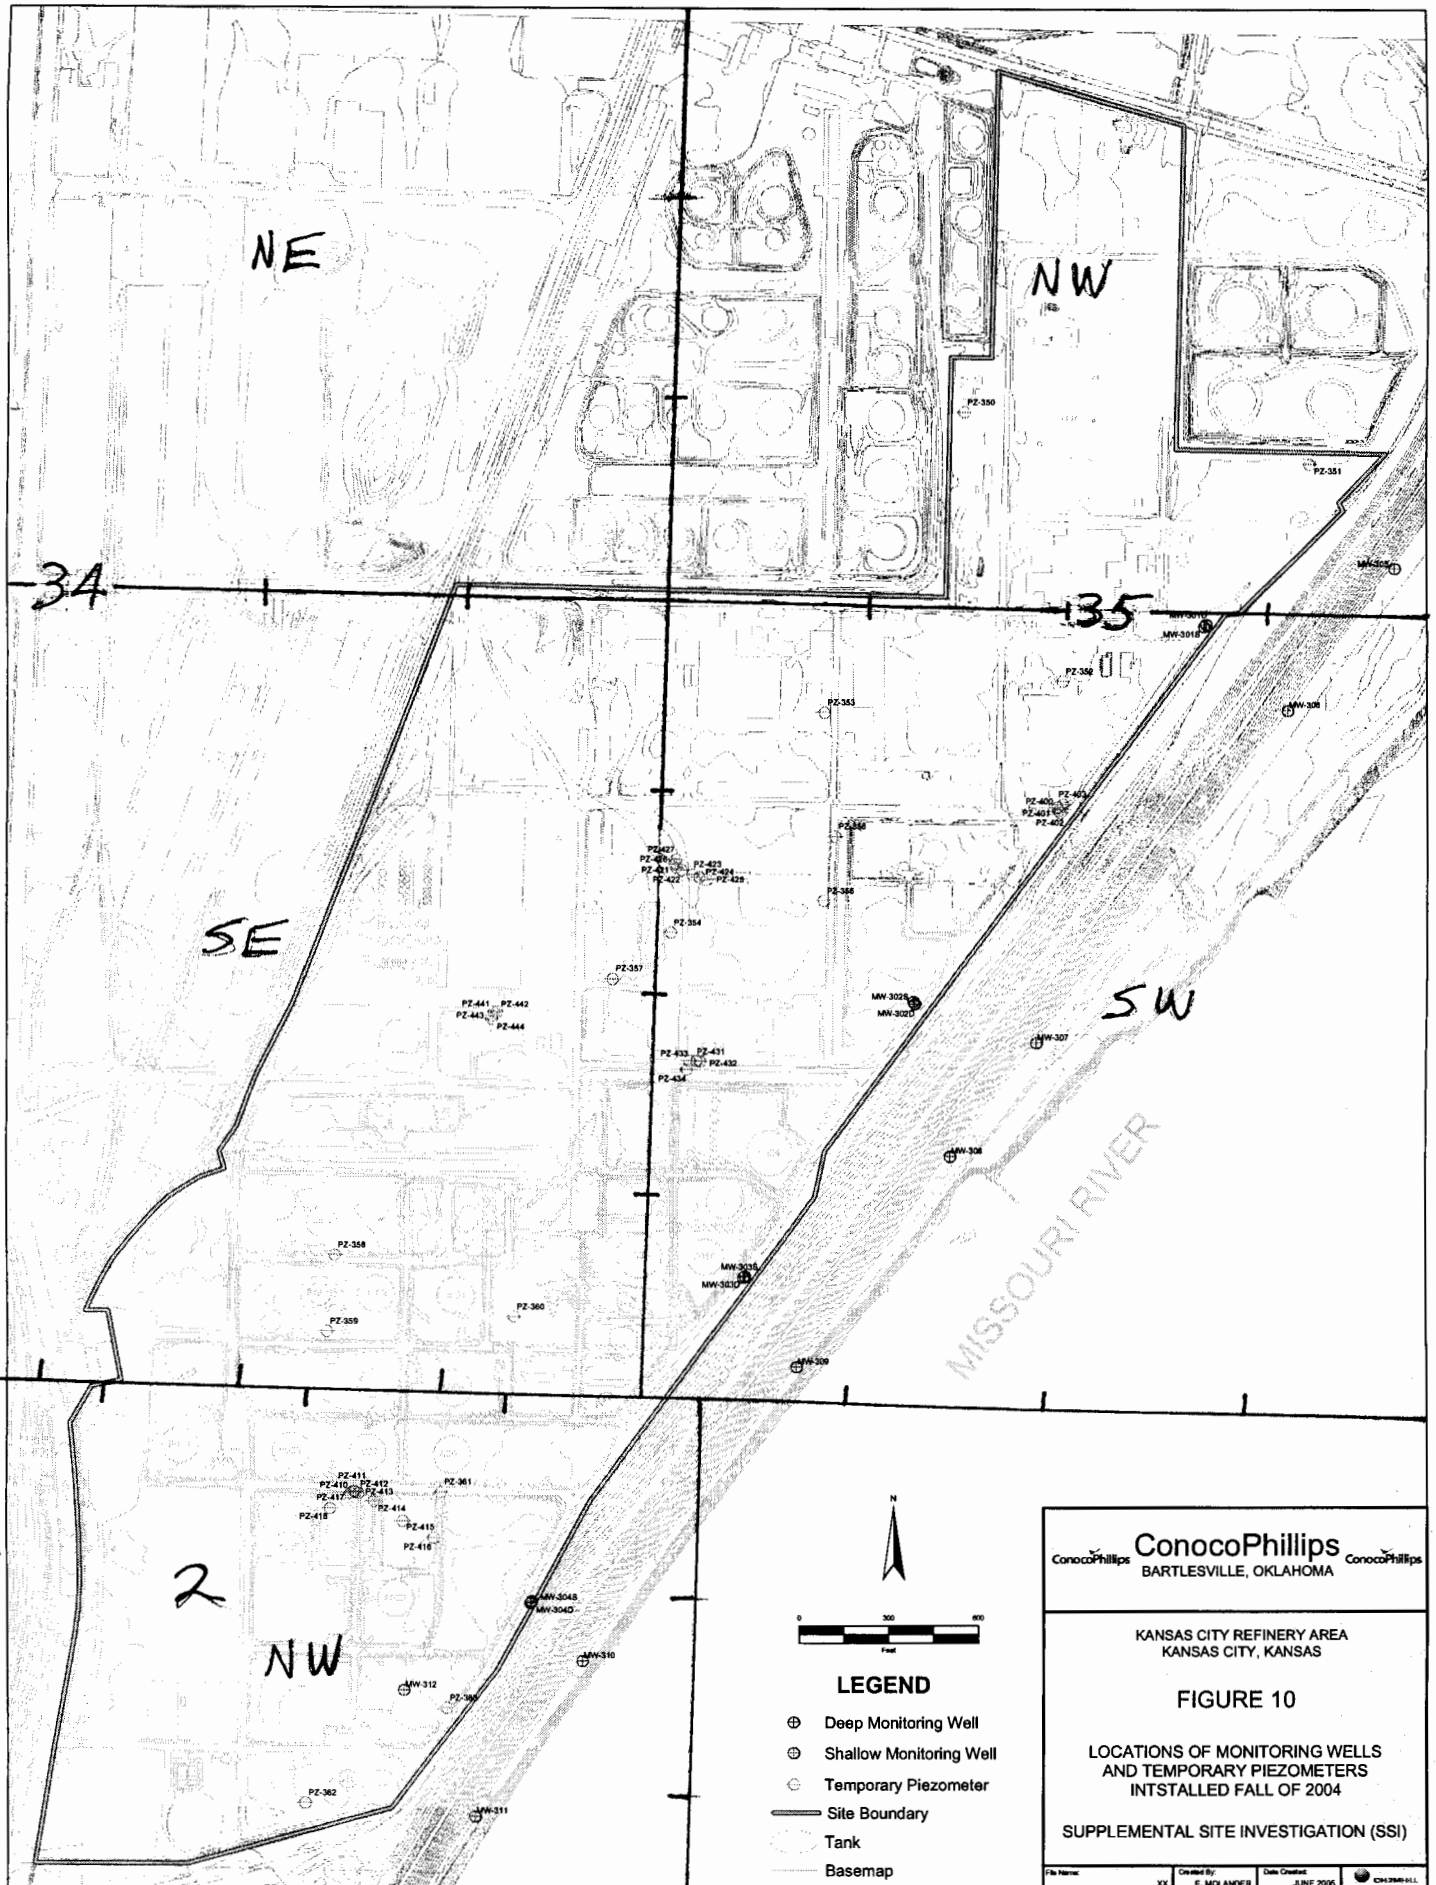


ConocoPhillips
 BARTLESVILLE, OKLAHOMA

KANSAS CITY REFINERY AREA
 KANSAS CITY, KANSAS

FIGURE 10
 LOCATIONS OF MONITORING WELLS
 AND TEMPORARY PIEZOMETERS
 INSTALLED FALL OF 2004
 SUPPLEMENTAL SITE INVESTIGATION (SSI)

File Name: XX Created By: E. MOLANDER Date Created: JUNE 2005 CH17949-011