

CORRECTION(S) TO WATER WELL RECORD (WWC-5)

(to rectify lacking or incorrect information)

County: Wyandotte

Location listed as:

Section-Township-Range: 34-105-25E

Fraction (  $\frac{1}{4}$   $\frac{1}{4}$   $\frac{1}{4}$ ): E $\frac{1}{2}$  SE SE

Location changed to:

35-105-25E

SW SW SW SW

Other changes: Initial statements: \_\_\_\_\_

Changed to: \_\_\_\_\_

Comments: \_\_\_\_\_

verification method: Map of well locations from owner, and  
North Kansas City 1:24,000 topo. map.

initials: DRJ date: 9/9/2005

submitted by: Kansas Geological Survey, Data Resources Library, 1930 Constant Ave., Lawrence, KS 66047-3726  
to: Kansas Dept of Health & Environment, Bureau of Water, 1000 SW Jackson, Suite 420, Topeka, KS 66612-1367.

MV 69

|         |                         |                     |                |                 |              |
|---------|-------------------------|---------------------|----------------|-----------------|--------------|
| 1       | LOCATION OF WATER WELL: | Fraction            | Section Number | Township Number | Range Number |
| County: | Wichita                 | E 1/4 SE 1/4 SE 1/4 | 34             | 10S             | 25 E EW      |

Distance and direction from nearest town or city street address of well if located within city?

2029 Fairfax KCKS 166115

|   |                           |   |
|---|---------------------------|---|
| 2 | WATER WELL OWNER:         | Board of Agriculture, Division of Water Resources |
|   | RR #, St. Address, Box #: | Application Number:                               |
|   | City, State, ZIP Code :   |   |

Conoco Phillips Company  
1218 Phillips Bldg 420 S. Kecker Ave  
Bartlesville OK 74004

|   |  |   |                               |
|---|--|---|-------------------------------|
| 3   | MARK WELL'S LOCATION WITH AN "X" IN SECTION BOX: | 4   | DEPTH OF WELL ..... 26.45 ft. |
|   |  | WELL'S STATIC WATER LEVEL ..... ft.<br>WELL WAS USED AS:<br>1 Domestic                      5 Public Water Supply                      9 Dewatering<br>2 Irrigation                      6 Oil Field Water Supply                      10 Monitoring Well<br>3 Feedlot                      7 Domestic (Lawn & Garden)                      11 Injection Well<br>4 Industrial                      8 Air Conditioning                      12 Other ..... |                               |
| Was a chemical / bacteriological sample submitted to Department? Yes ..... No .....<br>If yes, mo/day/yr sample was submitted .....<br>Water Well Disinfected: Yes ..... No ..... |  |   |                               |

|  |   |
|--|---|
| 5  | TYPE OF BLANK CASING USED:  |
|  | 1 Steel      3 RMP (SR)      5 Wrought      7 Fiberglass      9 Other (Specify below)<br>2 PVC      4 ABS      6 Asbestos-Cement      8 Concrete Tile |
| Blank casing diameter ..... in.      Was casing pulled? Yes <input checked="" type="checkbox"/> No .....      If yes, how much .....<br>Casing height above or below land surface ..... 29 in. |   |

|  |                      |               |                |             |               |
|--|----------------------|---------------|----------------|-------------|---------------|
| 6  | GROUT PLUG MATERIAL: | 1 Neat cement | 2 Cement grout | 3 Bentonite | 4 Other ..... |
| Grout Plug Intervals: From 26.45 ft. to 0 ft., From ..... ft. to ..... ft., From ..... to ..... ft.  |                      |               |                |             |               |
| What is the nearest source of possible contamination:<br>1 Septic tank      6 Seepage pit      11 Fuel storage      16 Other (specify below)<br>2 Sewer lines      7 Pit privy      12 Fertilizer storage<br>3 Watertight sewer lines      8 Sewage lagoon      13 Insecticide storage<br>4 Lateral lines      9 Feedyard      14 Abandoned water well<br>5 Cess pool      10 Livestock pens      15 Oil well/Gas well |                      |               |                |             |               |
| Direction from well? .....      How many feet? .....   |                      |               |                |             |               |

| FROM  | TO | PLUGGING MATERIALS |
|-------|----|--------------------|
| 26.45 | 0  | Cement Grout       |
|       |    |                    |
|       |    |                    |
|   |  |
|---|--|
| 7 | CONTRACTOR'S OR LANDOWNER'S CERTIFICATION: This water well was plugged under my jurisdiction and was completed on (mo/day/year) 11-23-04 and this record is true to the best of my knowledge and belief. Kansas Water Well Contractor's License No. 704 This Water Well Record was completed on (mo/day/year) 1-1-05 under the business name of MAXS by (signature) David Maxs |
|---|--|

INSTRUCTIONS: Use typewriter or ball point pen. Please press firmly and print clearly. Please fill in blanks, underline or circle the correct answers. Send top three copies to Kansas Department of Health and Environment, Bureau of Water, Geology Section, 1000 SW Jackson St., Ste. 420, Topeka, Kansas 66612-1367. Telephone: 785/296-5522. Send one to Water Well Owner and retain one for your records.

R25E

NE

NW

34

35

SE

SW



T10S

T11S

2

NW

MISSOURI RIVER

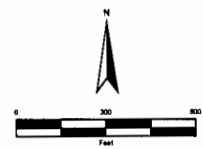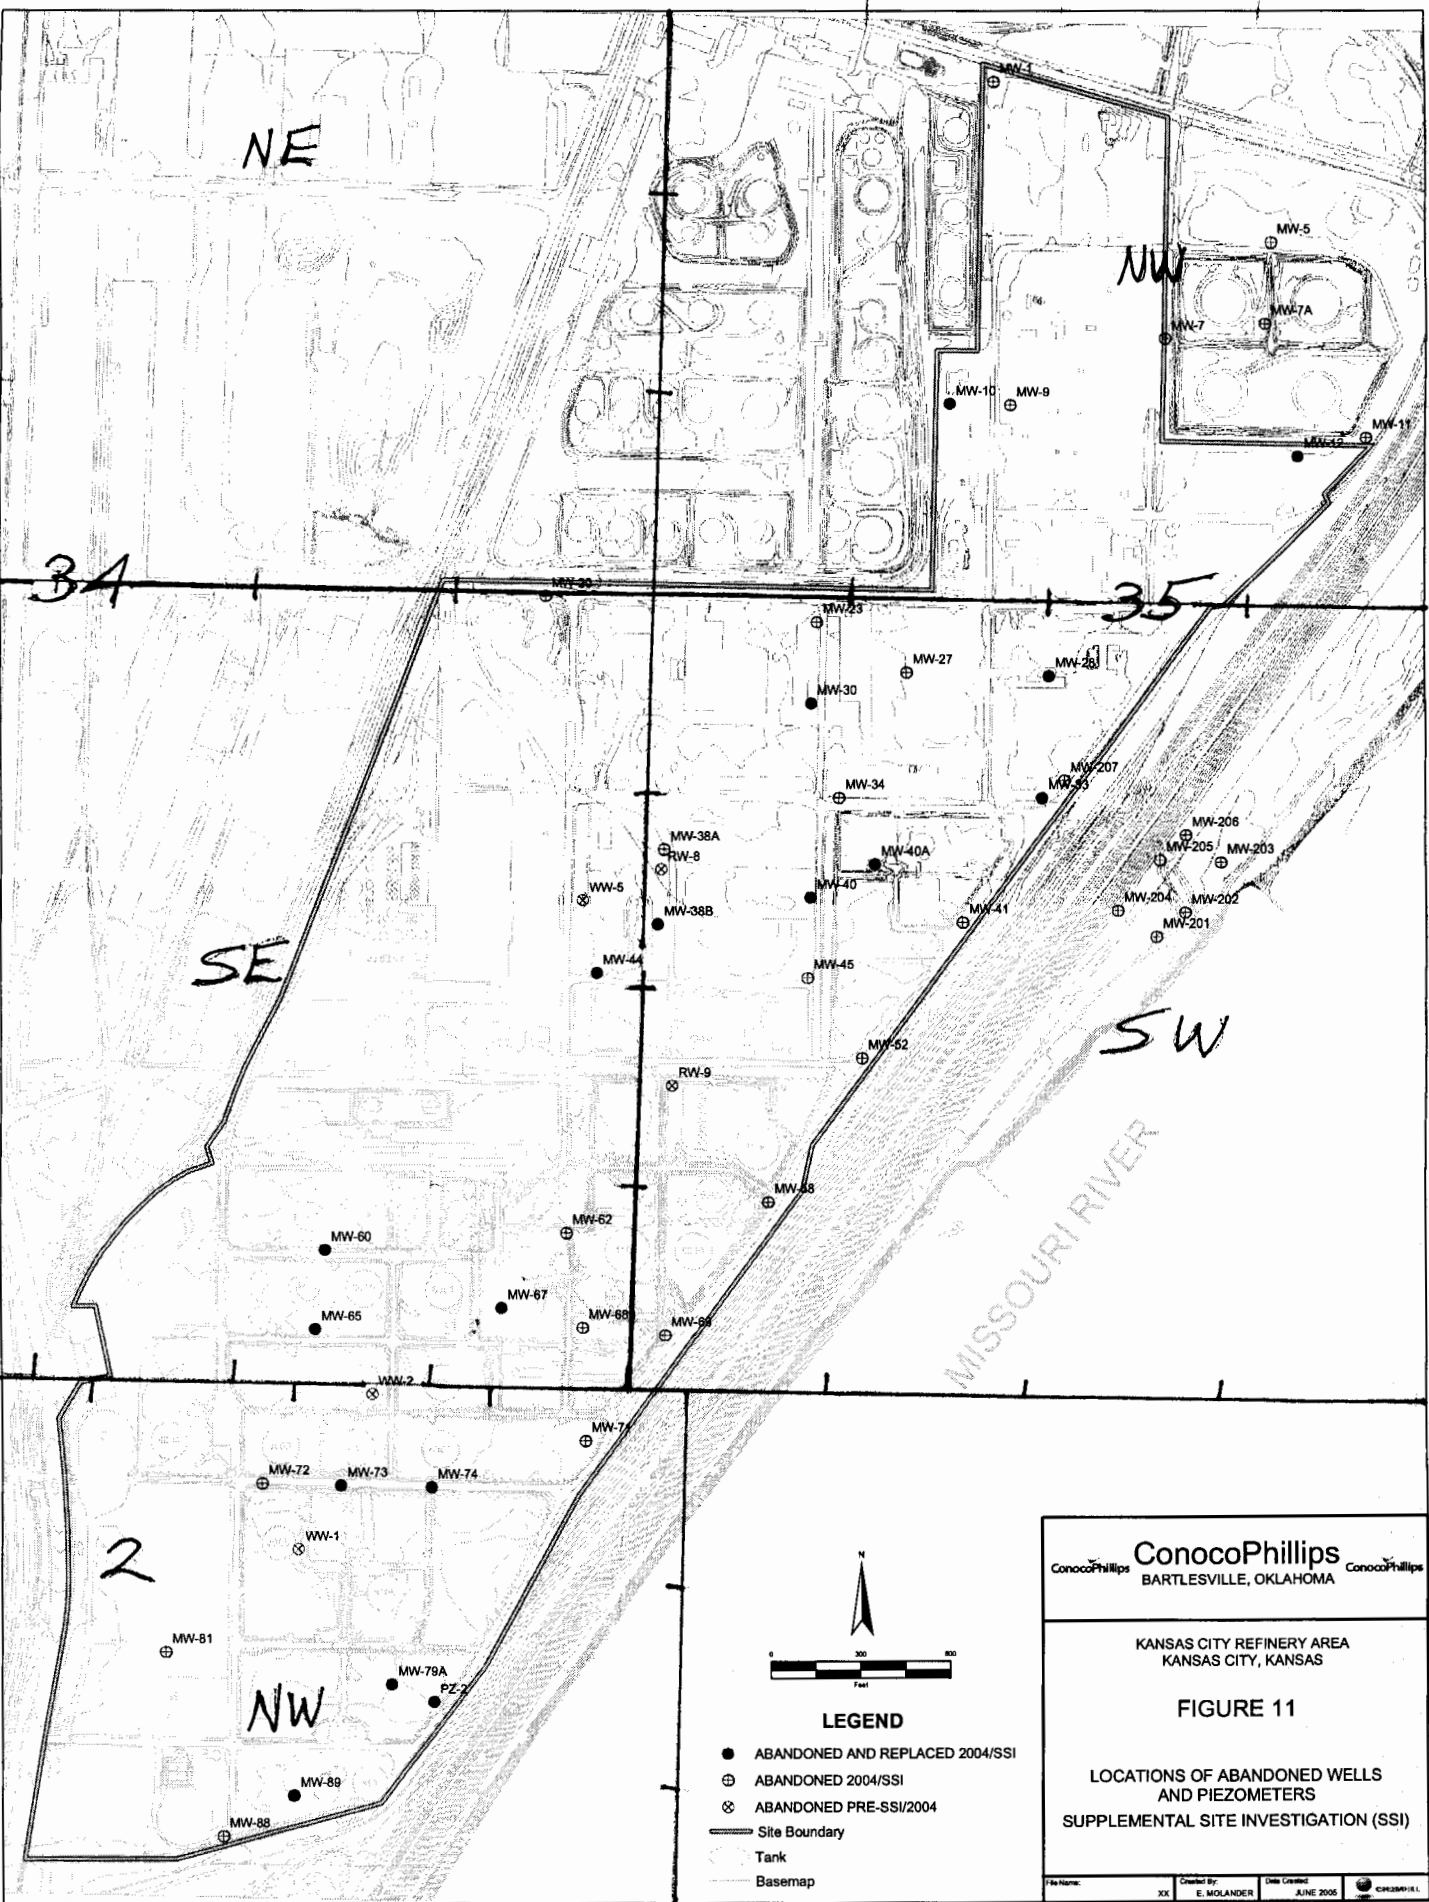

**LEGEND**

- ABANDONED AND REPLACED 2004/SSI
- ⊕ ABANDONED 2004/SSI
- ⊖ ABANDONED PRE-SSI/2004
- Site Boundary
- Tank
- Basemap

|  |  |
|--|--|
| <br><b>ConocoPhillips</b><br>BARTLESVILLE, OKLAHOMA  |  |
| KANSAS CITY REFINERY AREA<br>KANSAS CITY, KANSAS   |  |
| <b>FIGURE 11</b><br><br>LOCATIONS OF ABANDONED WELLS<br>AND PIEZOMETERS<br>SUPPLEMENTAL SITE INVESTIGATION (SSI) |  |
| File Name:   | Created By: E. MOLANDER<br>Date Created: JUNE 2005 |