

CORRECTION(S) TO WATER WELL RECORD (WWC-5)

(to rectify lacking or incorrect information)

Location listed as:

Section-Township-Range: 22-50N-33WFraction ($\frac{1}{4}$ $\frac{1}{4}$ $\frac{1}{4}$): NE NW NWCounty: Wyandotte

Location changed to:

35-10S-25ESE SW NW

Other changes: Initial statements: _____


Changed to: _____

Comments: _____

verification method: Projection of legal description onto Kansas survey system, and North Kansas City 1:24,000 topo. map.initials: DRL date: 10/4/2005

1 LOCATION OF WATER WELL: Fraction NE 1/4 NW 1/4 NW 1/4 Section Number 22 Township Number T 50 S 17 Range Number R 33 E 17
 County: WYANDOTTE
 Distance and direction from nearest town or city street address of well if located within city?
KANSAS CITY, KS.

2 WATER WELL OWNER: PHILLIPS PETROLEUM CO.
 RR#, St. Address, Box #: BARTLESVILLE, OKLAHOMA 74004
 City, State, ZIP Code: BARTLESVILLE, OKLAHOMA 74004
 Board of Agriculture, Division of Water Resources
 Application Number:

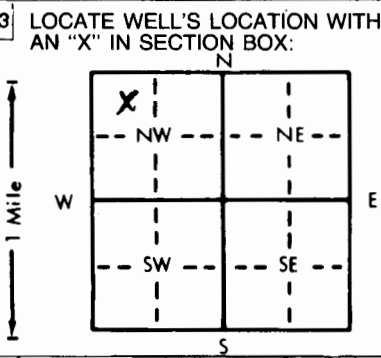

4 DEPTH OF COMPLETED WELL: 25.0 ft. ELEVATION:
 Depth(s) Groundwater Encountered 1. 18.0 ft. 2. ft. 3. ft.
 WELL'S STATIC WATER LEVEL ft. below land surface measured on mo/day/yr
 Pump test data: Well water was ft. after hours pumping gpm
 Est. Yield gpm Well water was ft. after hours pumping gpm
 Bore Hole Diameter: 5 in. to 25.0 ft., and in. to ft.
 WELL WATER TO BE USED AS:
 5 Public water supply 8 Air conditioning 11 Injection well
 1 Domestic 3 Feedlot 6 Oil field water supply 9 Dewatering 12 Other (Specify below)
 2 Irrigation 4 Industrial 7 Lawn and garden only 10 Observation well
 Was a chemical/bacteriological sample submitted to Department? Yes.....No.....X.....; If yes, mo/day/yr sample was submitted
 Water Well Disinfected? Yes No X

5 TYPE OF BLANK CASING USED:
 1 Steel 3 RMP (SR) 5 Wrought iron 8 Concrete tile CASING JOINTS: Glued Clamped
2 PVC 4 ABS 6 Asbestos-Cement 9 Other (specify below) Welded
 7 Fiberglass Threaded. X
 Blank casing diameter 2 in. to 5.0 ft., Dia in. to ft., Dia in. to ft.
 Casing height above land surface 24 in., weight lbs./ft. Wall thickness or gauge No. Sch. 40
 TYPE OF SCREEN OR PERFORATION MATERIAL:
 1 Steel 3 Stainless steel 5 Fiberglass 8 RMP (SR) 10 Asbestos-cement
2 Brass 4 Galvanized steel 6 Concrete tile 9 ABS 11 Other (specify)
 12 None used (open hole)
 SCREEN OR PERFORATION OPENINGS ARE:
 1 Continuous slot 3 Mill slot 5 Gauzed wrapped 8 Saw cut 11 None (open hole)
 2 Louvered shutter 4 Key punched 6 Wire wrapped 9 Drilled holes
 7 Torch cut 10 Other (specify)
 SCREEN-PERFORATED INTERVALS: From 5.0 ft. to 25.0 ft., From ft. to ft.
 From ft. to ft., From ft. to ft.
 GRAVEL PACK INTERVALS: From 5.0 ft. to 25.0 ft., From ft. to ft.
 From ft. to ft., From ft. to ft.

6 GROUT MATERIAL: 1 Neat cement 2 Cement grout 3 Bentonite 4 Other
 Grout Intervals: From 4.5 ft. to 5.0 ft., From 0 ft. to 4.5 ft., From ft. to ft.
 What is the nearest source of possible contamination:
 1 Septic tank 4 Lateral lines 7 Pit privy 10 Livestock pens 14 Abandoned water well
 2 Sewer lines 5 Cess pool 8 Sewage lagoon 11 Fuel storage 15 Oil well/Gas well
 3 Watertight sewer lines 6 Seepage pit 9 Feedyard 12 Fertilizer storage 16 Other (specify below)
 13 Insecticide storage REFINERY
 Direction from well? How many feet? 50' EQUIPMENT

FROM	TO	LITHOLOGIC LOG	FROM	TO	LITHOLOGIC LOG
0	5.0	LIGHT GREY SILTY SAND & GRAVEL WITH CRUSHED LIMESTONE	17		
5.0	25.0	GREY SILTY SAND, WITH HYDROCARBONS	02		

7 CONTRACTOR'S OR LANDOWNER'S CERTIFICATION: This water well was (1) constructed, (2) reconstructed, or (3) plugged under my jurisdiction and was completed on (mo/day/year) 1-18-83 and this record is true to the best of my knowledge and belief. Kansas Water Well Contractor's License No. 438 This Water Well Record was completed on (mo/day/yr) 1-28-83 under the business name of KANSAS CITY TESTING LABORATORY (signature) John Rodgers
 INSTRUCTIONS: Use typewriter or ball point pen, PLEASE PRESS FIRMLY and PRINT clearly. Please fill in blanks, underline or circle the correct answers. Send top three copies to Kansas Department of Health and Environment, Division of Environment, Environmental Geology Section, Topeka, KS 66620. Send one to WATER WELL OWNER and retain one for your records.

OFFICE USE ONLY
T
50
R
33
E
17
SEC.
22
NE
1/4
NW
1/4
NW
1/4

DP