

CORRECTION(S) TO WATER WELL RECORD (WWC-5)

(to rectify lacking or incorrect information)

County: Wyandotte

Location listed as:

Section-Township-Range: 22-50N-33W

Fraction ($\frac{1}{4}$ $\frac{1}{4}$ $\frac{1}{4}$): NW SW NW

Location changed to:

35-105-25E

C NW SW

Other changes: Initial statements: _____

Changed to: _____

Comments: _____

verification method: Map of well locations from well owner, and
North Kansas City 1:24,000 topo. map.

initials: ARD date: 10/4/2005

submitted by: Kansas Geological Survey, Data Resources Library, 1930 Constant Ave., Lawrence, KS 66047-3726
to: Kansas Dept of Health & Environment, Bureau of Water, 1000 SW Jackson, Suite 420, Topeka, KS 66612-1367.


Well #34

OFFICE USE ONLY
T
50 NR
33 EW
SEC. 22
NW 1/4 SW 1/4

1 LOCATION OF WATER WELL: County: Wyandotte Fraction: NW 1/4 SW 1/4 NW 1/4 Section Number: 22 Township Number: T 50 S (N) Range Number: R 33 E (W)

Distance and direction from nearest town or city street address of well if located within city?
Kansas City, Kansas

2 WATER WELL OWNER: Phillips Petroleum Company
RR#, St. Address, Box #: Bartlesville, Oklahoma Board of Agriculture, Division of Water Resources
City, State, ZIP Code: 74004 Application Number:

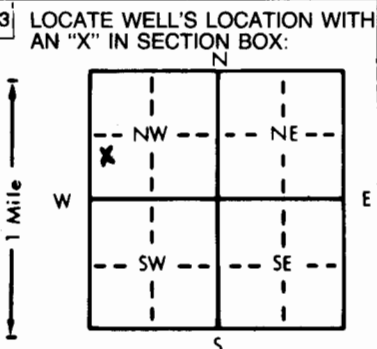

4 DEPTH OF COMPLETED WELL: 25.0 ft. ELEVATION:
Depth(s) Groundwater Encountered 1. @ 17.0 ft. 2. ft. 3. ft.
WELL'S STATIC WATER LEVEL: ft. below land surface measured on mo/day/yr
Pump test data: Well water was ft. after hours pumping gpm
Est. Yield gpm: Well water was ft. after hours pumping gpm
Bore Hole Diameter: 5" in. to 25.0 ft., and in. to ft.
WELL WATER TO BE USED AS:
1 Domestic 3 Feedlot 6 Oil field water supply 9 Dewatering 12 Other (Specify below)
2 Irrigation 4 Industrial 7 Lawn and garden only 10 Observation well
Was a chemical/bacteriological sample submitted to Department? Yes No X; If yes, mo/day/yr sample was submitted
Water Well Disinfected? Yes No X

5 TYPE OF BLANK CASING USED:
1 Steel 3 RMP (SR) 5 Wrought iron 8 Concrete tile CASING JOINTS: Glued Clamped
2 PVC 4 ABS 6 Asbestos-Cement 9 Other (specify below) Welded
Blank casing diameter 2" in. to 15.0 ft., Dia in. to ft., Dia in. to ft.
Casing height above land surface: 24" in., weight lbs./ft. Wall thickness or gauge No. sch-40
7 Fiberglass Threaded X

TYPE OF SCREEN OR PERFORATION MATERIAL:
1 Steel 3 Stainless steel 5 Fiberglass 8 RMP (SR) 11 Other (specify)
2 Brass 4 Galvanized steel 6 Concrete tile 9 ABS 12 None used (open hole)

SCREEN OR PERFORATION OPENINGS ARE:
1 Continuous slot 3 Mill slot 5 Gauzed wrapped 8 Saw cut 11 None (open hole)
2 Louvered shutter 4 Key punched 7 Torch cut 9 Drilled holes 10 Other (specify)

SCREEN-PERFORATED INTERVALS: From 15.0 ft. to 25.0 ft., From ft. to ft.
GRAVEL PACK INTERVALS: From 15.0 ft. to 25.0 ft., From ft. to ft.

6 GROUT MATERIAL: 1 Neat cement 2 Cement grout 8 Bentonite 4 Other
Grout Intervals: From 4.50 ft. to 9.0 ft., From 0 ft. to 4.5 ft., From ft. to ft.

What is the nearest source of possible contamination:
1 Septic tank 4 Lateral lines 7 Pit privy 10 Livestock pens 14 Abandoned water well
2 Sewer lines 5 Cess pool 8 Sewage lagoon 11 Fuel storage 15 Oil well/Gas well
3 Watertight sewer lines 6 Seepage pit 9 Feedyard 12 Fertilizer storage 16 Other (specify below)
How many feet? 80' refinery tanks and lines

FROM	TO	LITHOLOGIC LOG	FROM	TO	LITHOLOGIC LOG
0	6.0	gravel, brown clay + grey silt			03
6.0	18.0	grey silt and sandy silt layer - moist			07
18.0	25.0	grey medium sand - wet			08

7 CONTRACTOR'S OR LANDOWNER'S CERTIFICATION: This water well was (1) constructed, (2) reconstructed, or (3) plugged under my jurisdiction and was completed on (mo/day/year) 1-21-83 and this record is true to the best of my knowledge and belief. Kansas Water Well Contractor's License No. 438 This Water Well Record was completed on (mo/day/yr) 1-21-83 under the business name of K C Testing Lab by (signature) Richard C Zeebe

INSTRUCTIONS: Use typewriter or ball point pen, PLEASE PRESS FIRMLY and PRINT clearly. Please fill in blanks, underline or circle the correct answers. Send top three copies to Kansas Department of Health and Environment, Division of Environment, Environmental Geology Section, Topeka, KS 66620. Send one to WATER WELL OWNER and retain one for your records.