

**CORRECTION(S) TO WATER WELL RECORD (WWC-5)**  
(to rectify lacking or incorrect information)

County: Wyandotte

Location listed as:

Section-Township-Range: 22-50N-33W

Fraction (  $\frac{1}{4}$   $\frac{1}{4}$   $\frac{1}{4}$ ): SW SW NW

Location changed to:

35-10S-25E

SE SW NW SW

Other changes: Initial statements: \_\_\_\_\_

Changed to: \_\_\_\_\_

Comments: \_\_\_\_\_

verification method: Map of well locations from well owner, and  
North Kansas City 1:24,000 topo. map.

initials: DRL date: 10/5/2005


WELL # 45

1 LOCATION OF WATER WELL: County: <b>WYANDOTTE</b>	Fraction <b>SW 1/4 SW 1/4 NW 1/4</b>	Section Number <b>22</b>	Township Number <b>T 50 S (N)</b>	Range Number <b>R 33 E (W)</b>
---	---	-----------------------------	--------------------------------------	-----------------------------------

Distance and direction from nearest town or city street address of well if located within city?  
**KANSAS CITY, KS.**

2 WATER WELL OWNER: **PHILLIPS PETROLEUM CO.**  
 RR#, St. Address, Box # : **BARTLESVILLE, OKLAHOMA 74004** Board of Agriculture, Division of Water Resources  
 City, State, ZIP Code : Application Number:

3 LOCATE WELL'S LOCATION WITH AN "X" IN SECTION BOX:

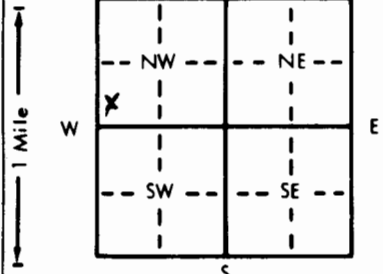

4 DEPTH OF COMPLETED WELL: **25.0** ft. ELEVATION:  
 Depth(s) Groundwater Encountered 1. **18.0** ft. 2. ft. 3. ft.  
 WELL'S STATIC WATER LEVEL . . . . . ft. below land surface measured on mo/day/yr  
 Pump test data: Well water was . . . . . ft. after . . . . . hours pumping . . . . . gpm  
 Est. Yield . . . . . gpm: Well water was . . . . . ft. after . . . . . hours pumping . . . . . gpm  
 Bore Hole Diameter: **5** in. to **25.0** ft., and . . . . . in. to . . . . . ft.  
 WELL WATER TO BE USED AS:  
 1 Domestic 3 Feedlot 6 Oil field water supply 9 Dewatering 12 Other (Specify below)  
 2 Irrigation 4 Industrial 7 Lawn and garden only **10 Observation well**  
 Was a chemical/bacteriological sample submitted to Department? Yes . . . . . No **X**; If yes, mo/day/yr sample was submitted  
 Water Well Disinfected? Yes . . . . . No **X**

5 TYPE OF BLANK CASING USED:  
 1 Steel 3 RMP (SR) 5 Wrought iron 8 Concrete tile CASING JOINTS: Glued . . . . . Clamped . . . . .  
**2 PVC** 4 ABS 6 Asbestos-Cement 9 Other (specify below) Welded . . . . .  
 7 Fiberglass Threaded . . . . . **X**

Blank casing diameter . . . . . **2** in. to **5.0** ft., Dia . . . . . in. to . . . . . ft., Dia . . . . . in. to . . . . . ft.  
 Casing height above land surface . . . . . **24** in., weight . . . . . lbs./ft. Wall thickness or gauge No. **SCN 40**

TYPE OF SCREEN OR PERFORATION MATERIAL:  
 1 Steel 3 Stainless steel 5 Fiberglass 8 RMP (SR) 10 Asbestos-cement  
 2 Brass 4 Galvanized steel 6 Concrete tile 9 ABS 11 Other (specify) . . . . .  
 12 None used (open hole)

SCREEN OR PERFORATION OPENINGS ARE:  
 1 Continuous slot 3 Mill slot 5 Gauzed wrapped 8 Saw cut 11 None (open hole)  
 2 Louvered shutter 4 Key punched 6 Wire wrapped 9 Drilled holes  
 7 Torch cut 10 Other (specify) . . . . .

SCREEN-PERFORATED INTERVALS: From **5.0** ft. to **25.0** ft., From . . . . . ft. to . . . . . ft.  
 GRAVEL PACK INTERVALS: From **5.0** ft. to **25.0** ft., From . . . . . ft. to . . . . . ft.

6 GROUT MATERIAL: 1 Neat cement 2 Cement grout 3 Bentonite 4 Other  
 Grout Intervals: From **4.5 BENTONITE** ft. to **5.0** ft., From **0** ft. to **4.5** ft., From . . . . . ft. to . . . . . ft.

What is the nearest source of possible contamination:  
 1 Septic tank 4 Lateral lines 7 Pit privy 10 Livestock pens 14 Abandoned water well  
 2 Sewer lines 5 Cess pool 8 Sewage lagoon 11 Fuel storage 15 Oil well/Gas well  
 3 Watertight sewer lines 6 Seepage pit 9 Feedyard 12 Fertilizer storage 16 Other (specify below)  
**REFINERY EQUIPMENT**  
 How many feet? **25'**

FROM	TO	LITHOLOGIC LOG	FROM	TO	LITHOLOGIC LOG
0	19.0	GREY SANDY SILT, SOME CLAY			02
19.0	25.0	GREY SILTY SAND, COARSE TO FINE, WET			08

7 CONTRACTOR'S OR LANDOWNER'S CERTIFICATION: This water well was **(1) constructed**, (2) reconstructed, or (3) plugged under my jurisdiction and was completed on (mo/day/year) **1-24-83** and this record is true to the best of my knowledge and belief. Kansas Water Well Contractor's License No. **438** This Water Well Record was completed on (mo/day/yr) **1-30-83** under the business name of **KANSAS CITY TESTING LABORATORY** by (signature) **Jim Rodgels**  
 INSTRUCTIONS: Use typewriter or ball point pen, PLEASE PRESS FIRMLY and PRINT clearly. Please fill in blanks, underline or circle the correct answers. Send top three copies to Kansas Department of Health and Environment, Division of Environment, Environmental Geology Section, Topeka, KS 66620. Send one to WATER WELL OWNER and retain one for your records.