

CORRECTION(S) TO WATER WELL RECORD (WWC-5)  
(to rectify lacking or incorrect information)

County: Wyandotte

Location listed as:

Location changed to:

Section-Township-Range: 22-50N-33W

35-10S-25E

Fraction ( 1/4 1/4 1/4): NW NW SW

NE SW SW SW

Other changes: Initial statements: \_\_\_\_\_

Changed to: \_\_\_\_\_

Comments: \_\_\_\_\_

verification method: Map of well locations from well owner, and  
North Kansas City 1:24,000 topo. map.

initials: DRL date: 10/5/2005

submitted by: Kansas Geological Survey, Data Resources Library, 1930 Constant Ave., Lawrence, KS 66047-3726  
to: Kansas Dept of Health & Environment, Bureau of Water, 1000 SW Jackson, Suite 420, Topeka, KS 66612-1367.

WELL #58


1 LOCATION OF WATER WELL: County: <b>WYANDOTTE</b>	Fraction <b>NW 1/4 NW 1/4 SW 1/4</b>	Section Number <b>22</b>	Township Number T <b>50</b> S <b>(N)</b>	Range Number R <b>33</b> E <b>(W)</b>
---	---	-----------------------------	---	--

Distance and direction from nearest town or city street address of well if located within city?

**KANSAS CITY, KS.**

2 WATER WELL OWNER:  
 PHILLIPS PETROLEUM CO.  
 RR#, St. Address, Box # :  
**BARTLESVILLE, OKLAHOMA 74004**  
 City, State, ZIP Code :  
 Board of Agriculture, Division of Water Resources  
 Application Number:

3 LOCATE WELL'S LOCATION WITH AN "X" IN SECTION BOX:

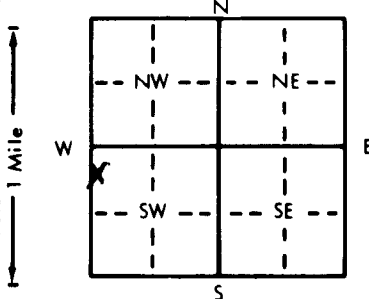

4 DEPTH OF COMPLETED WELL **25.0** ft. ELEVATION:

Depth(s) Groundwater Encountered 1. **18.0** ft. 2. ft. 3. ft.

WELL'S STATIC WATER LEVEL ft. below land surface measured on mo/day/yr

Pump test data: Well water was ft. after hours pumping gpm

Est. Yield gpm: Well water was ft. after hours pumping gpm

Bore Hole Diameter **5** in. to **25.0** ft., and in. to ft.

WELL WATER TO BE USED AS: 5 Public water supply 8 Air conditioning 11 Injection well

1 Domestic 3 Feedlot 6 Oil field water supply 9 Dewatering 12 Other (Specify below)

2 Irrigation 4 Industrial 7 Lawn and garden only **10 Observation well**

Was a chemical/bacteriological sample submitted to Department? Yes No **X**; If yes, mo/day/yr sample was submitted

Water Well Disinfected? Yes No **X**

5 TYPE OF BLANK CASING USED: 5 Wrought iron 8 Concrete tile CASING JOINTS: Glued Clamped

1 Steel 3 RMP (SR) 6 Asbestos-Cement 9 Other (specify below) Welded

**2 PVC** 4 ABS 7 Fiberglass Threaded **X**

Blank casing diameter **2** in. to **5.0** ft., Dia in. to ft., Dia in. to ft.

Casing height above land surface **24** in., weight lbs./ft. Wall thickness or gauge No. **Sch. 40**

TYPE OF SCREEN OR PERFORATION MATERIAL: **PVC** 10 Asbestos-cement

1 Steel 3 Stainless steel 5 Fiberglass 8 RMP (SR) 11 Other (specify)

2 Brass 4 Galvanized steel 6 Concrete tile 9 ABS 12 None used (open hole)

SCREEN OR PERFORATION OPENINGS ARE: 5 Gauzed wrapped 8 Saw cut 11 None (open hole)

1 Continuous slot **3 Mill slot** 6 Wire wrapped 9 Drilled holes

2 Louvered shutter 4 Key punched 7 Torch cut 10 Other (specify)

SCREEN-PERFORATED INTERVALS: From **5.0** ft. to **25.0** ft., From ft. to ft.

From ft. to ft., From ft. to ft.

GRAVEL PACK INTERVALS: From **5.0** ft. to **25.0** ft., From ft. to ft.

From ft. to ft., From ft. to ft.

6 GROUT MATERIAL: 1 Neat cement **2 Cement grout** **3 Bentonite** 4 Other

Grout Intervals: From **4.5 BENTONITE** ft. to **5.0** ft., From **0 GROUT** ft. to **4.5** ft., From ft. to ft.

What is the nearest source of possible contamination: 10 Livestock pens 14 Abandoned water well

1 Septic tank 4 Lateral lines 7 Pit privy 11 Fuel storage 15 Oil well/Gas well

2 Sewer lines 5 Cess pool 8 Sewage lagoon 12 Fertilizer storage 16 Other (specify below)

3 Watertight sewer lines 6 Seepage pit 9 Feedyard 13 Insecticide storage **REFINERY TANKS**

Direction from well? How many feet? **100'**

FROM	TO	LITHOLOGIC LOG	FROM	TO	LITHOLOGIC LOG
<b>0</b>	<b>18.0</b>	<b>BROWN CLAY WITH SAND + SILT</b>	<b>03</b>		
<b>18.0</b>	<b>25.0</b>	<b>LIGHT BROWN SAND, COARSE TO FINE</b>	<b>08</b>		

7 CONTRACTOR'S OR LANDOWNER'S CERTIFICATION: This water well was **(1) constructed**, **(2) reconstructed**, or **(3) plugged** under my jurisdiction and was completed on (mo/day/year) **1-25-83** and this record is true to the best of my knowledge and belief. Kansas

Water Well Contractor's License No. **438** This Water Well Record was completed on (mo/day/yr) **1-30-83**

under the business name of **KANSAS CITY TESTING LABORATORY** by (signature) **John Rodgers**

INSTRUCTIONS: Use typewriter or ball point pen, PLEASE PRESS FIRMLY and PRINT clearly. Please fill in blanks, underline or circle the correct answers. Send top three copies to Kansas Department of Health and Environment, Division of Environment, Environmental Geology Section, Topeka, KS 66620. Send one to WATER WELL OWNER and retain one for your records.

OFFICE USE ONLY  
T  
50 N R  
33  
SEC.  
22  
NW 1/4  
SW 1/4

DP