

CORRECTION(S) TO WATER WELL RECORD (WWC-5)

(to rectify lacking or incorrect information)

Location listed as:

Section-Township-Range: 15-50N-33W

Fraction ($\frac{1}{4}$ $\frac{1}{4}$ $\frac{1}{4}$): NE NW NW

County: Wyandotte

Location changed to:

26-105-25E

SW SW NW

Other changes: Initial statements: _____

Changed to: _____

Comments: _____

verification method: Written & legal descriptions, position on plat map, and North Kansas City 1:24,000 topo. map.

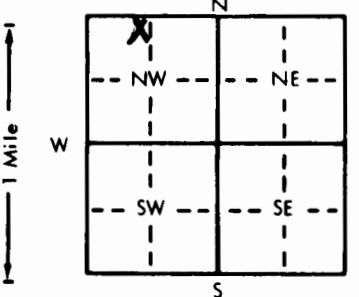
initials: DRJ date: 10/6/2005

submitted by: Kansas Geological Survey, Data Resources Library, 1930 Constant Ave., Lawrence, KS 66047-3726
to: Kansas Dept of Health & Environment, Bureau of Water, 1000 SW Jackson, Suite 420, Topeka, KS 66612-1367.

1 LOCATION OF WATER WELL: Fraction NE 1/4 NW 1/4 NW 1/4 Section Number 15 Township Number T 50N Range Number R 33 EW

Distance and direction from nearest town or city street address of well if located within city?
4200' Northeast of 3101 Fairfax Trafficway - KC, Ks.

2 WATER WELL OWNER: General Motors Corp.
 RR#, St. Address, Box # : 100 Kindelberger Road Board of Agriculture, Division of Water Resources
 City, State, ZIP Code : KC, Ks. 66115 Application Number:

3 LOCATE WELL'S LOCATION WITH AN "X" IN SECTION BOX:

 4 DEPTH OF COMPLETED WELL: 85.0 ft. ELEVATION: 743.0 (g.s.)
 Depth(s) Groundwater Encountered 1. 1 ft. 2. 2 ft. 3. 3 ft.
 WELL'S STATIC WATER LEVEL 16.6 ft. below top of casing measured on mo/day/yr 4/4/85
 Pump test data: Well water was _____ ft. after _____ hours pumping _____ gpm
 Est. Yield _____ gpm: Well water was _____ ft. after _____ hours pumping _____ gpm
 Bore Hole Diameter .6 in. to 85.0 ft., and _____ in. to _____ ft.
 WELL WATER TO BE USED AS:
 5 Public water supply 8 Air conditioning 11 Injection well
 1 Domestic 3 Feedlot 6 Oil field water supply 9 Dewatering 12 Other (Specify below)
2 Irrigation 4 Industrial 7 Lawn and garden only 10 Observation well Monitoring
 Was a chemical/bacteriological sample submitted to Department? Yes _____ No X; If yes, mo/day/yr sample was submitted _____
 Water Well Disinfected? Yes _____ No X

5 TYPE OF BLANK CASING USED:
 1 Steel 3 RMP (SR) 5 Wrought iron 8 Concrete tile CASING JOINTS: Glued _____ Clamped _____
2 VC 4 ABS 6 Asbestos-Cement 9 Other (specify below) Welded _____
 7 Fiberglass _____ Threaded X
 Blank casing diameter 2 in. to 65 ~~xxx~~ ft., Dia _____ in. to _____ ft., Dia _____ in. to _____ ft.
 Casing height above land surface 24 in., weight _____ lbs./ft. Wall thickness or gauge No. Schedule 40
 TYPE OF SCREEN OR PERFORATION MATERIAL:
 1 Steel 3 Stainless steel 5 Fiberglass 7 PVC 10 Asbestos-cement
 2 Brass 4 Galvanized steel 6 Concrete tile 8 RMP (SR) 11 Other (specify) _____
 9 ABS 12 None used (open hole)
 SCREEN OR PERFORATION OPENINGS ARE:
 1 Continuous slot 3 Mill slot 5 Gauzed wrapped 8 Saw cut 11 None (open hole)
 2 Louvered shutter 4 Key punched 6 Wire wrapped 9 Drilled holes
 7 Torch cut 10 Other (specify) _____
 SCREEN-PERFORATED INTERVALS: From 65.0 ft. to 85.0 ft., From _____ ft. to _____ ft.
 From _____ ft. to _____ ft., From _____ ft. to _____ ft.
 GRAVEL PACK INTERVALS: From 63.0 ft. to 85.0 ft., From _____ ft. to _____ ft.
 From _____ ft. to _____ ft., From _____ ft. to _____ ft.

6 GROUT MATERIAL: 1 Neat cement 2 Cement grout 3 Bentonite pellets 4 Other _____
 Grout Intervals: From 0.0 ft. to 61.0 ft., From 61.0 ft. to 63.0 ft., From _____ ft. to _____ ft.
 What is the nearest source of possible contamination:
 1 Septic tank 4 Lateral lines 7 Pit privy 11 Fuel storage 14 Abandoned water well
 2 Sewer lines 5 Cess pool 8 Sewage lagoon 12 Fertilizer storage 15 Oil well/Gas well
 3 Watertight sewer lines 6 Seepage pit 9 Feedyard 13 Insecticide storage 16 Other (specify below) _____
 Direction from well? Southwest How many feet? 4000'

FROM	TO	LITHOLOGIC LOG	FROM	TO	LITHOLOGIC LOG
0.0	1.5	Topsoil			
1.5	10.0	Brown silty clay			
10.0	18.0	Brown sandy silt			
18.0	27.5	Brown fine sand			
27.5	43.0	Gray medium to fine sand, trace gravel			
43.0	52.0	Gray fine to very fine sand, trace clay, dense			
52.0	60.0	Gray medium to coarse sand, trace fine sand, gravel, boulders			
60.0	65.0	Gray fine to very fine sand			
65.0	85.0	Gray coarse to medium sand, gravel & boulders			
85.0	Total	Depth			

7 CONTRACTOR'S OR LANDOWNER'S CERTIFICATION: This water well was (1) constructed, (2) reconstructed, or (3) plugged under my jurisdiction and was completed on (mo/day/year) 4/4/85 and this record is true to the best of my knowledge and belief. Kansas Water Well Contractor's License No. 102 This Water Well Record was completed on (mo/day/yr) 6/15/85 under the business name of Layne-Western Company, Inc. by (signature) Diana J. Alumbaugh

INSTRUCTIONS: Use typewriter or ball point pen, PLEASE PRESS FIRMLY and PRINT clearly. Please fill in blanks, underline or circle the correct answers. Send top three copies to Kansas Department of Health and Environment, Division of Environment, Environmental Geology Section, Topeka, KS 66620. Send one to WATER WELL OWNER and retain one for your records.

OFFICE USE ONLY

T

R

EW

SEC.

1/4

1/4

1/4