


1	LOCATION OF WATER WELL:	Fraction	Section Number	Township Number	Range Number
County:	<i>Wyandotte</i>	<i>NW 1/4 NW 1/4 SW 1/4 SW</i>	<i>Sec. 27</i>	<i>T 10 S</i>	<i>R 25 E</i>

Distance and direction from nearest town or city street address of well if located within city?
655 Sunshine Rd; North Kansas City, Ks. former Duhnke Furniture Co.

2	WATER WELL OWNER:	Board of Agriculture, Division of Water Resources
	<i>40 Kevin R. Jones</i>	Application Number:
	<i>Jones Development Company</i>	
	RR #, St. Address, Box #:	
	<i>4600 Madison Suite 725</i>	
	City, State, ZIP Code:	
	<i>Kansas City, Mo. 64112</i>	

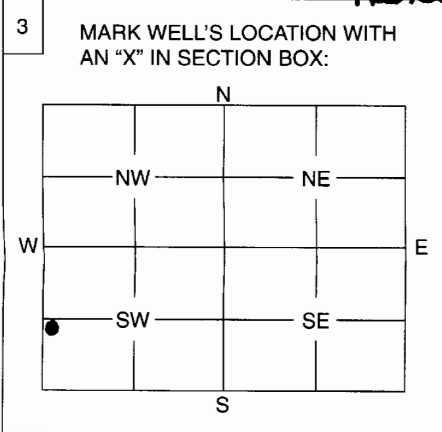

4	DEPTH OF WELL	<i>77'</i> ft.
	WELL'S STATIC WATER LEVEL	<i>27.55</i> ft.
	WELL WAS USED AS:	
	1 Domestic	5 Public Water Supply
	2 Irrigation	6 Oil Field Water Supply
	3 Feedlot	7 Domestic (Lawn & Garden)
	4 Industrial	8 Air Conditioning
	9 Dewatering	10 Monitoring Well
	11 Injection Well	12 Other
	Was a chemical / bacteriological sample submitted to Department? Yes	No <input checked="" type="checkbox"/>
	If yes, mo/day/yr sample was submitted	
	Water Well Disinfected: Yes <input checked="" type="checkbox"/>	No

5	TYPE OF BLANK CASING USED:
	<input checked="" type="checkbox"/> 1 Steel 3 RMP (SR) 5 Wrought 7 Fiberglass 9 Other (Specify below) <input type="checkbox"/> 2 PVC 4 ABS 6 Asbestos-Cement 8 Concrete Tile
	Blank casing diameter <i>10"</i> in. Was casing pulled? Yes No <input checked="" type="checkbox"/> If yes, how much
	Casing height above or below land surface <i>flush w/ cement floor</i>

6	GROUT PLUG MATERIAL:	1 Neat cement	2 Cement grout	<input checked="" type="checkbox"/> 3 Bentonite	4 Other <i>Cement</i>
	Grout Plug Intervals:	From <i>77</i> ft. to	<i>1</i> ft.,	From <i>1</i> ft. to	<i>0'</i> ft.,
	What is the nearest source of possible contamination:				
	<input type="checkbox"/> 1 Septic tank <input type="checkbox"/> 6 Seepage pit <input type="checkbox"/> 11 Fuel storage <input type="checkbox"/> 16 Other (specify below) <input type="checkbox"/> 2 Sewer lines <input type="checkbox"/> 7 Pit privy <input type="checkbox"/> 12 Fertilizer storage <input checked="" type="checkbox"/> 3 Watertight sewer lines <input type="checkbox"/> 8 Sewage lagoon <input type="checkbox"/> 13 Insecticide storage <input type="checkbox"/> 4 Lateral lines <input type="checkbox"/> 9 Feedyard <input type="checkbox"/> 14 Abandoned water well <input type="checkbox"/> 5 Cess pool <input type="checkbox"/> 10 Livestock pens <input type="checkbox"/> 15 Oil well/Gas well				
	Direction from well? <i>West</i>	How many feet? <i>50'</i>			

FROM	TO	PLUGGING MATERIALS
<i>77</i>	<i>1'</i>	<i>Bentonite</i>
<i>1'</i>	<i>0'</i>	<i>Cement</i>

Well was not used by this owner for last 20+ years. Well was located inside a warehouse, could not remove top 3ft. Therefore, grouted the hole from top to bottom. - cemented casing flush w/ surface.

7	CONTRACTOR'S OF LANDOWNER'S CERTIFICATION: This water well was plugged under my jurisdiction and was completed on (mo/day/year) <i>9-13-05</i> and this record is true to the best of my knowledge and belief. Kansas Water Well Contractor's License No. <i>730</i> This Water Well Record was completed on (mo/day/year) <i>9-21-05</i> under the business name of <i>QB Environmental Service & Supply</i> by (signature) <i>James Burek</i>
---	---

INSTRUCTIONS: Use typewriter or ball point pen. Please press firmly and print clearly. Please fill in blanks, underline or circle the correct answers. Send top three copies to Kansas Department of Health and Environment, Bureau of Water, Geology Section, 1000 SW Jackson St., Ste. 420, Topeka, Kansas 66612-1367. Telephone: 785/296-5522. Send one to Water Well Owner and retain one for your records.