


1 LOCATION OF WATER WELL: County: <u>Wyandotte</u>	Fraction <u>NW 1/4 NW 1/4</u>	Section Number <u>35</u>	Township Number <u>T -10 S</u>	Range Number <u>R 25 E/W</u>
---	----------------------------------	-----------------------------	-----------------------------------	---------------------------------

Distance and direction from nearest town or city street address of well if located within city?

401 E. Donovan Rd. Kansas City

2 WATER WELL OWNER: RR#, St. Address, Box # : City, State, ZIP Code	<u>Magellan Pipeline Kansas City Terminal</u> <u>401 E. Donovan Rd.</u> <u>Kansas City KS 66115</u>	Board of Agriculture, Division of Water Resources Application Number:
---	---	--

3 LOCATE WELL'S LOCATION WITH AN "X" IN SECTION BOX:	4 DEPTH OF COMPLETED WELL <u>40</u> ft. ELEVATION: <u>743.90</u>
--	--

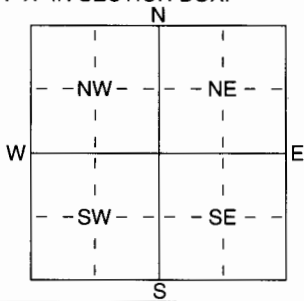

Depth(s) Groundwater Encountered 1 ft. 2 ft. 3 ft.
 WELL'S STATIC WATER LEVEL ft. below land surface measured on mo/day/yr
 Pump test data: Well water was ft. after hours pumping gpm
 Est. Yield gpm: Well water was ft. after hours pumping gpm
 WELL WATER TO BE USED AS: 5 Public water supply 8 Air conditioning 11 Injection well
 1 Domestic 3 Feedlot 6 Oil field water supply 9 Dewatering (12) Other (Specify below)
 2 Irrigation 4 Industrial 7 Domestic (lawn & garden) 10 Monitoring well Air Space / Soil Vap

Was a chemical/bacteriological sample submitted to Department? Yes No X; If yes, mo/day/yr sample was submitted
 Water Well Disinfected? Yes No

5 TYPE OF BLANK CASING USED:	5 Wrought iron	8 Concrete tile	CASING JOINTS: Glued Clamped
1 Steel	3 RMP (SR)	6 Asbestos-Cement	Welded
<u>(2) PVC</u>	4 ABS	7 Fiberglass	Threaded <u>X</u>

Blank casing diameter 2 in. to 36.5 ft., Dia 4 in. to 11.5 ft., Dia in. to ft.
 Casing height above land surface in., weight lbs./ft. Wall thickness or gauge No. Sch. 40

TYPE OF SCREEN OR PERFORATION MATERIAL:	<u>(7) PVC</u>	10 Asbestos-Cement
1 Steel	3 Stainless Steel	5 Fiberglass
2 Brass	4 Galvanized Steel	6 Concrete tile
		8 RMP (SR)
		9 ABS
		11 Other (Specify)
		12 None used (open hole)

SCREEN OR PERFORATION OPENINGS ARE:

<u>(1) Continuous slot</u>	3 Mill slot	5 Gauzed wrapped	8 Saw cut	11 None (open hole)
2 Louvered shutter	4 Key punched	6 Wire wrapped	9 Drilled holes	
		7 Torch cut	10 Other (specify)	

SCREEN-PERFORATED INTERVALS: From 36.5 ft. to 39.5 ft., From 11.5 ft. to 31.0 ft.
 From ft. to ft., From ft. to ft.
 GRAVEL PACK INTERVALS: From 35.5 ft. to 40 ft., From 9.5 ft. to 31.5 ft.
 From ft. to ft., From ft. to ft.

6 GROUT MATERIAL:	1 Neat cement	2 Cement grout	<u>(3) Bentonite</u>	4 Other
-------------------	---------------	----------------	----------------------	---------------

Grout Intervals: From 31.5 ft. to 35.5 ft., From ft. to ft., From ft. to ft.

What is the nearest source of possible contamination:


1 Septic tank	4 Lateral lines	7 Pit privy	<u>(11) Fuel storage</u>	14 Abandoned water well
2 Sewer lines	5 Cess pool	8 Sewage lagoon	12 Fertilizer storage	15 Oil well/Gas well
3 Watertight sewer lines	6 Seepage pit	9 Feedyard	13 Insecticide storage	16 Other (specify below)

Direction from well? How many feet?

FROM	TO	LITHOLOGIC LOG	FROM	TO	PLUGGING INTERVALS
		<u>See attached Geologic log</u>			

7 CONTRACTOR'S OR LANDOWNER'S CERTIFICATION: This water well was (1) constructed, (2) reconstructed, or (3) plugged under my jurisdiction and was completed on (mo/day/year) <u>5/16/04</u> and this record is true to the best of my knowledge and belief. Kansas Water Well Contractor's Licence No <u>658</u> This Water Well Record was completed on (mo/day/yr) <u>7/29/04</u> under the business name of <u>Boart Longyear Env. Drilling Division</u> by (signature) <u>[Signature]</u>

INSTRUCTIONS: Use typewriter or ball point pen. PLEASE PRESS FIRMLY and PRINT clearly. Please fill in blanks, underline or circle the correct answers. Send two true copies to Kansas Department of Health and Environment, Bureau of Water, Geology Section, 1000 SW Jackson St., Suite 420, Topeka, Kansas 66612-1367. Telephone 785-296-5522. Send one to WATER WELL OWNER and retain one for your records. Fee of \$5.00 for each constructed well.

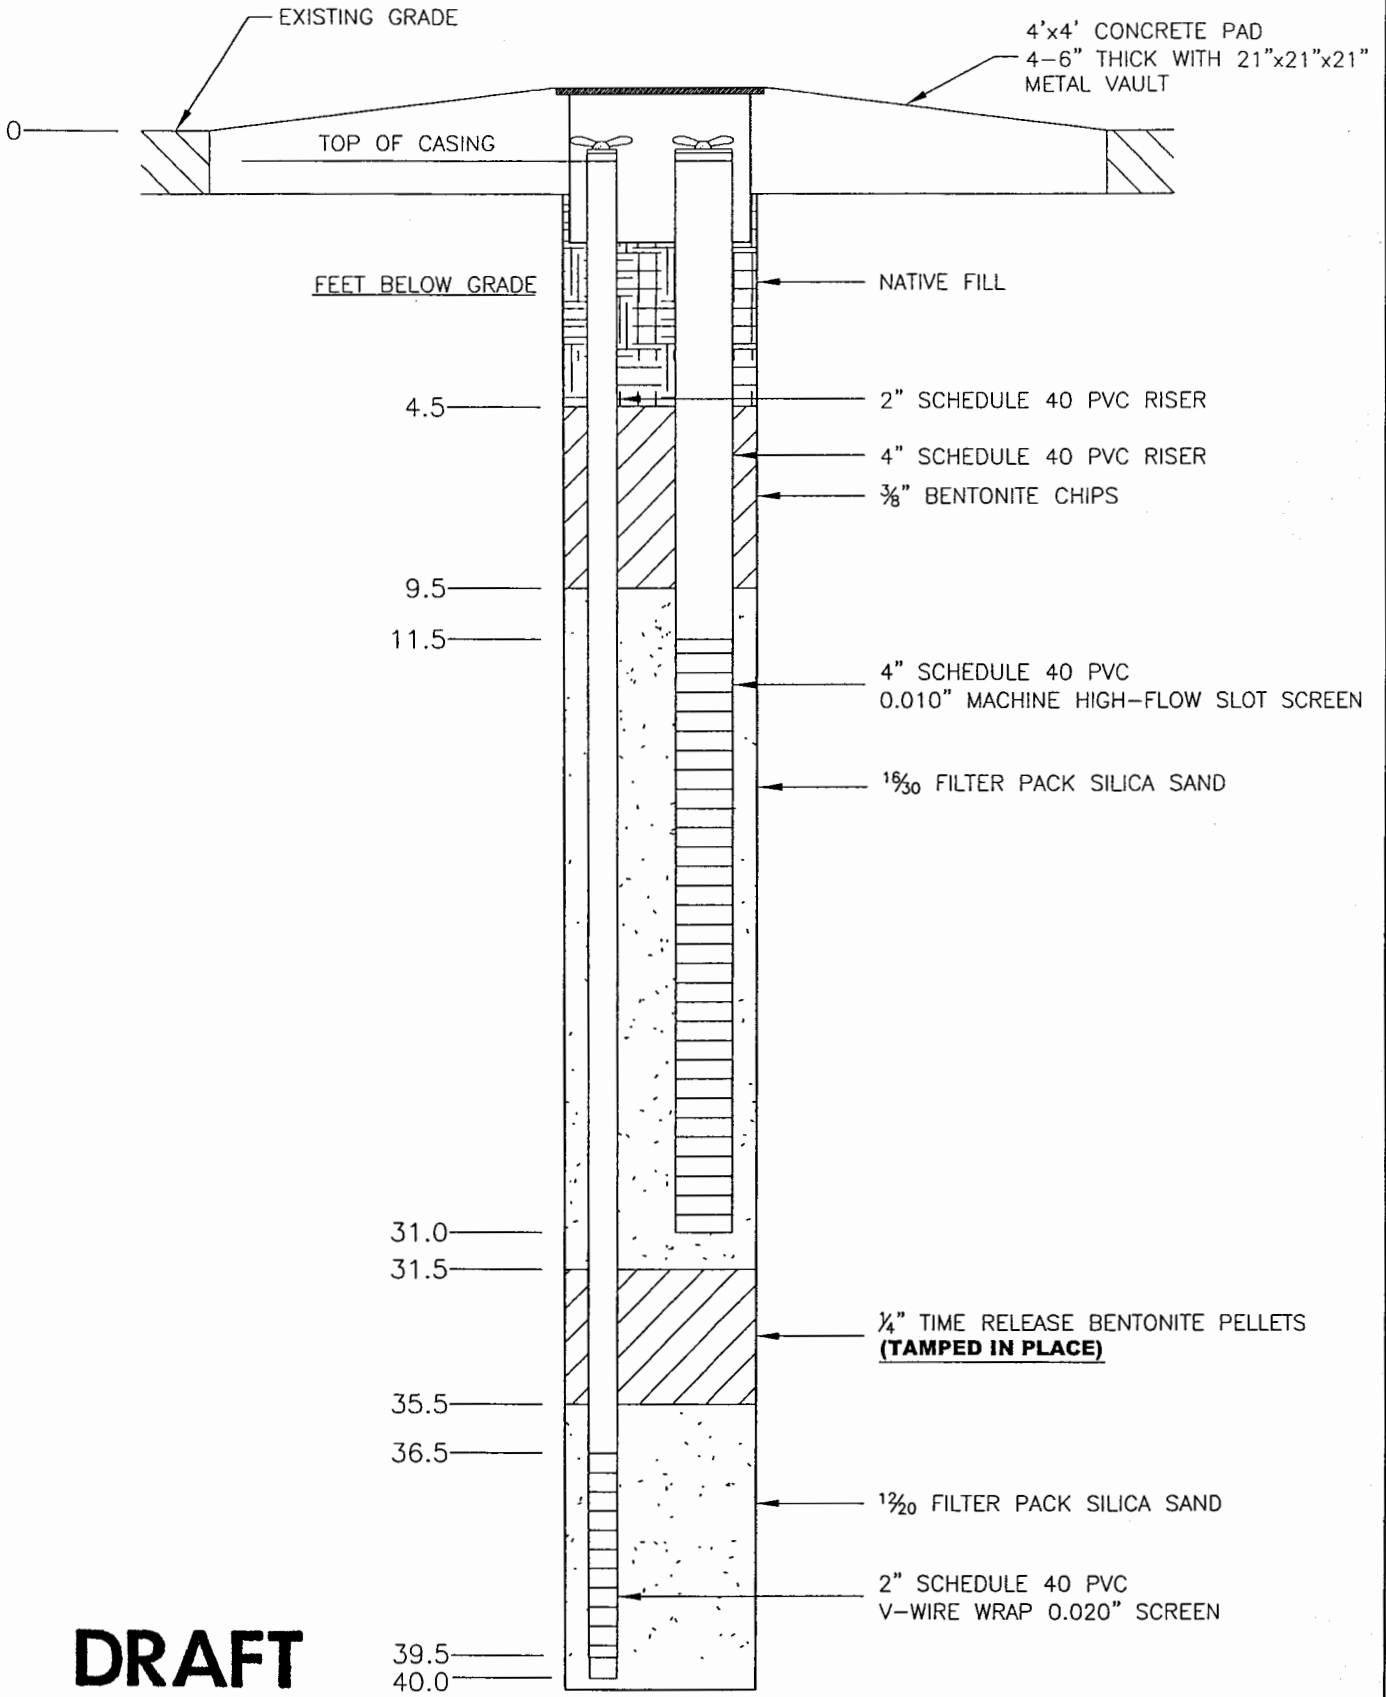

DRAFT

NOT TO SCALE

INSTALLED: 05/06/04

DATE	REVISED	Prepared By:	MAGELLAN PIPELINE COMPANY, LLC
		LEGGETTE, BRASHEARS & GRAHAM, INC.	KANSAS CITY TERMINAL
		Professional Ground-Water and	KANSAS CITY, KANSAS
		Environmental Engineering Services	MPE/SVE & AS WELL 03
		2103 Burlington Street	CONSTRUCTION DIAGRAM
		North Kansas City, Missouri 64116	FILE: MPE_AS 03.dwg
		(816) 421-7766	DATE: MAY 2004
			FIGURE: 1