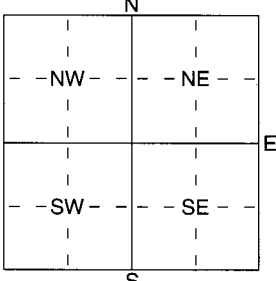


1 LOCATION OF WATER WELL: County: <u>Wyandotte</u>	Fraction <u>NW 1/4 NW 1/4</u>	Section Number <u>35</u>	Township Number <u>T -10 S</u>	Range Number <u>R 25 (EW)</u>
---	----------------------------------	-----------------------------	-----------------------------------	----------------------------------

Distance and direction from nearest town or city street address of well if located within city?

401 E. Donovan Rd., Kansas City, KS


2 WATER WELL OWNER: RR#, St. Address, Box # : <u>Magellan Kansas City Terminal</u> City, State, ZIP Code : <u>401 E. Donovan Rd.</u> <u>Kansas City, KS 66115</u>	Board of Agriculture, Division of Water Resources Application Number:
--	--

3 LOCATE WELL'S LOCATION WITH AN "X" IN SECTION BOX: 	4 DEPTH OF COMPLETED WELL ..... <u>40.5</u> ..... ft. ELEVATION: ..... <u>744.8</u> ..... Depth(s) Groundwater Encountered 1 ..... ft. 2 ..... ft. 3 ..... ft. WELL'S STATIC WATER LEVEL ..... ft. below land surface measured on mo/day/yr ..... Pump test data: Well water was ..... ft. after ..... hours pumping ..... gpm Est. Yield ..... gpm: Well water was ..... ft. after ..... hours pumping ..... gpm WELL WATER TO BE USED AS: 1 Domestic 3 Feedlot 5 Public water supply 8 Air conditioning 11 Injection well 2 Irrigation 4 Industrial 6 Oil field water supply 9 Dewatering 10 Monitoring well <u>(12) Other (Specify below)</u> <u>Air Sparge / Soil Vapor Extraction Wells</u> Was a chemical/bacteriological sample submitted to Department? Yes ..... No <input checked="" type="checkbox"/> ; If yes, mo/day/yr sample was submitted Water Well Disinfected? Yes ..... No <input checked="" type="checkbox"/>
---	---

5 TYPE OF BLANK CASING USED: 1 Steel 3 RMP (SR) 5 Wrought iron 8 Concrete tile <input checked="" type="radio"/> PVC 4 ABS 6 Asbestos-Cement 9 Other (specify below) 7 Fiberglass Blank casing diameter ..... <u>2</u> ..... in. to ..... <u>37.0</u> ..... ft., Dia ..... <u>4</u> ..... in. to ..... <u>11.5</u> ..... ft., Dia ..... in. to ..... ft. Casing height above land surface ..... in., weight ..... lbs./ft. Wall thickness or gauge No. <u>Sch. 40</u> TYPE OF SCREEN OR PERFORATION MATERIAL: 1 Steel 3 Stainless Steel 5 Fiberglass 7 PVC 10 Asbestos-Cement 2 Brass 4 Galvanized Steel 6 Concrete tile 8 RMP (SR) 11 Other (Specify) ..... 9 ABS 12 None used (open hole) SCREEN OR PERFORATION OPENINGS ARE: <input checked="" type="radio"/> Continuous slot 3 Mill slot 5 Gauzed wrapped 8 Saw cut 11 None (open hole) 2 Louvered shutter 4 Key punched 6 Wire wrapped 9 Drilled holes 7 Torch cut 10 Other (specify) ..... ft. SCREEN-PERFORATED INTERVALS: From ..... <u>37.0</u> ..... ft. to ..... <u>40.0</u> ..... ft., From ..... <u>11.5</u> ..... ft. to ..... <u>31.5</u> ..... ft. GRAVEL PACK INTERVALS: From ..... <u>36.0</u> ..... ft. to ..... <u>40.5</u> ..... ft., From ..... <u>9.5</u> ..... ft. to ..... <u>32.0</u> ..... ft. From ..... ft. to ..... ft., From ..... ft. to ..... ft.
---


6 GROUT MATERIAL: 1 Neat cement 2 Cement grout 3 Bentonite 4 Other ..... Grout Intervals: From ..... <u>32.0</u> ..... ft. to ..... <u>36.0</u> ..... ft., From ..... <u>4.5</u> ..... ft. to ..... <u>9.5</u> ..... ft., From ..... ft. to ..... ft. What is the nearest source of possible contamination: 1 Septic tank 4 Lateral lines 7 Pit privy 11 Fuel storage 14 Abandoned water well 2 Sewer lines 5 Cess pool 8 Sewage lagoon 12 Fertilizer storage 15 Oil well/Gas well 3 Watertight sewer lines 6 Seepage pit 9 Feedyard 13 Insecticide storage 16 Other (specify below) Direction from well? How many feet?
--

FROM	TO	LITHOLOGIC LOG	FROM	TO	PLUGGING INTERVALS
		<u>See attached Geologic Log</u>			

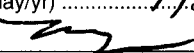7 CONTRACTOR'S OR LANDOWNER'S CERTIFICATION: This water well was (1) constructed, (2) reconstructed, or (3) plugged under my jurisdiction and was completed on (mo/day/year) ..... <u>5/05/04</u> ..... and this record is true to the best of my knowledge and belief. Kansas Water Well Contractor's Licence No ..... <u>6058</u> ..... This Water Well Record was completed on (mo/day/yr) ..... <u>7/29/04</u> ..... under the business name of <u>Boat Longyear Engr. Drilling Division</u> by (signature) 
---

INSTRUCTIONS: Use typewriter or ball point pen. PLEASE PRESS FIRMLY and PRINT clearly. Please fill in blanks, underline or circle the correct answers. Send top three copies to Kansas Department of Health and Environment, Bureau of Water, Geology Section, 1000 SW Jackson St., Suite 420, Topeka, Kansas 66612-1367. Telephone 785-296-5522. Send one to WATER WELL OWNER and retain one for your records. Fee of \$5.00 for each constructed well.



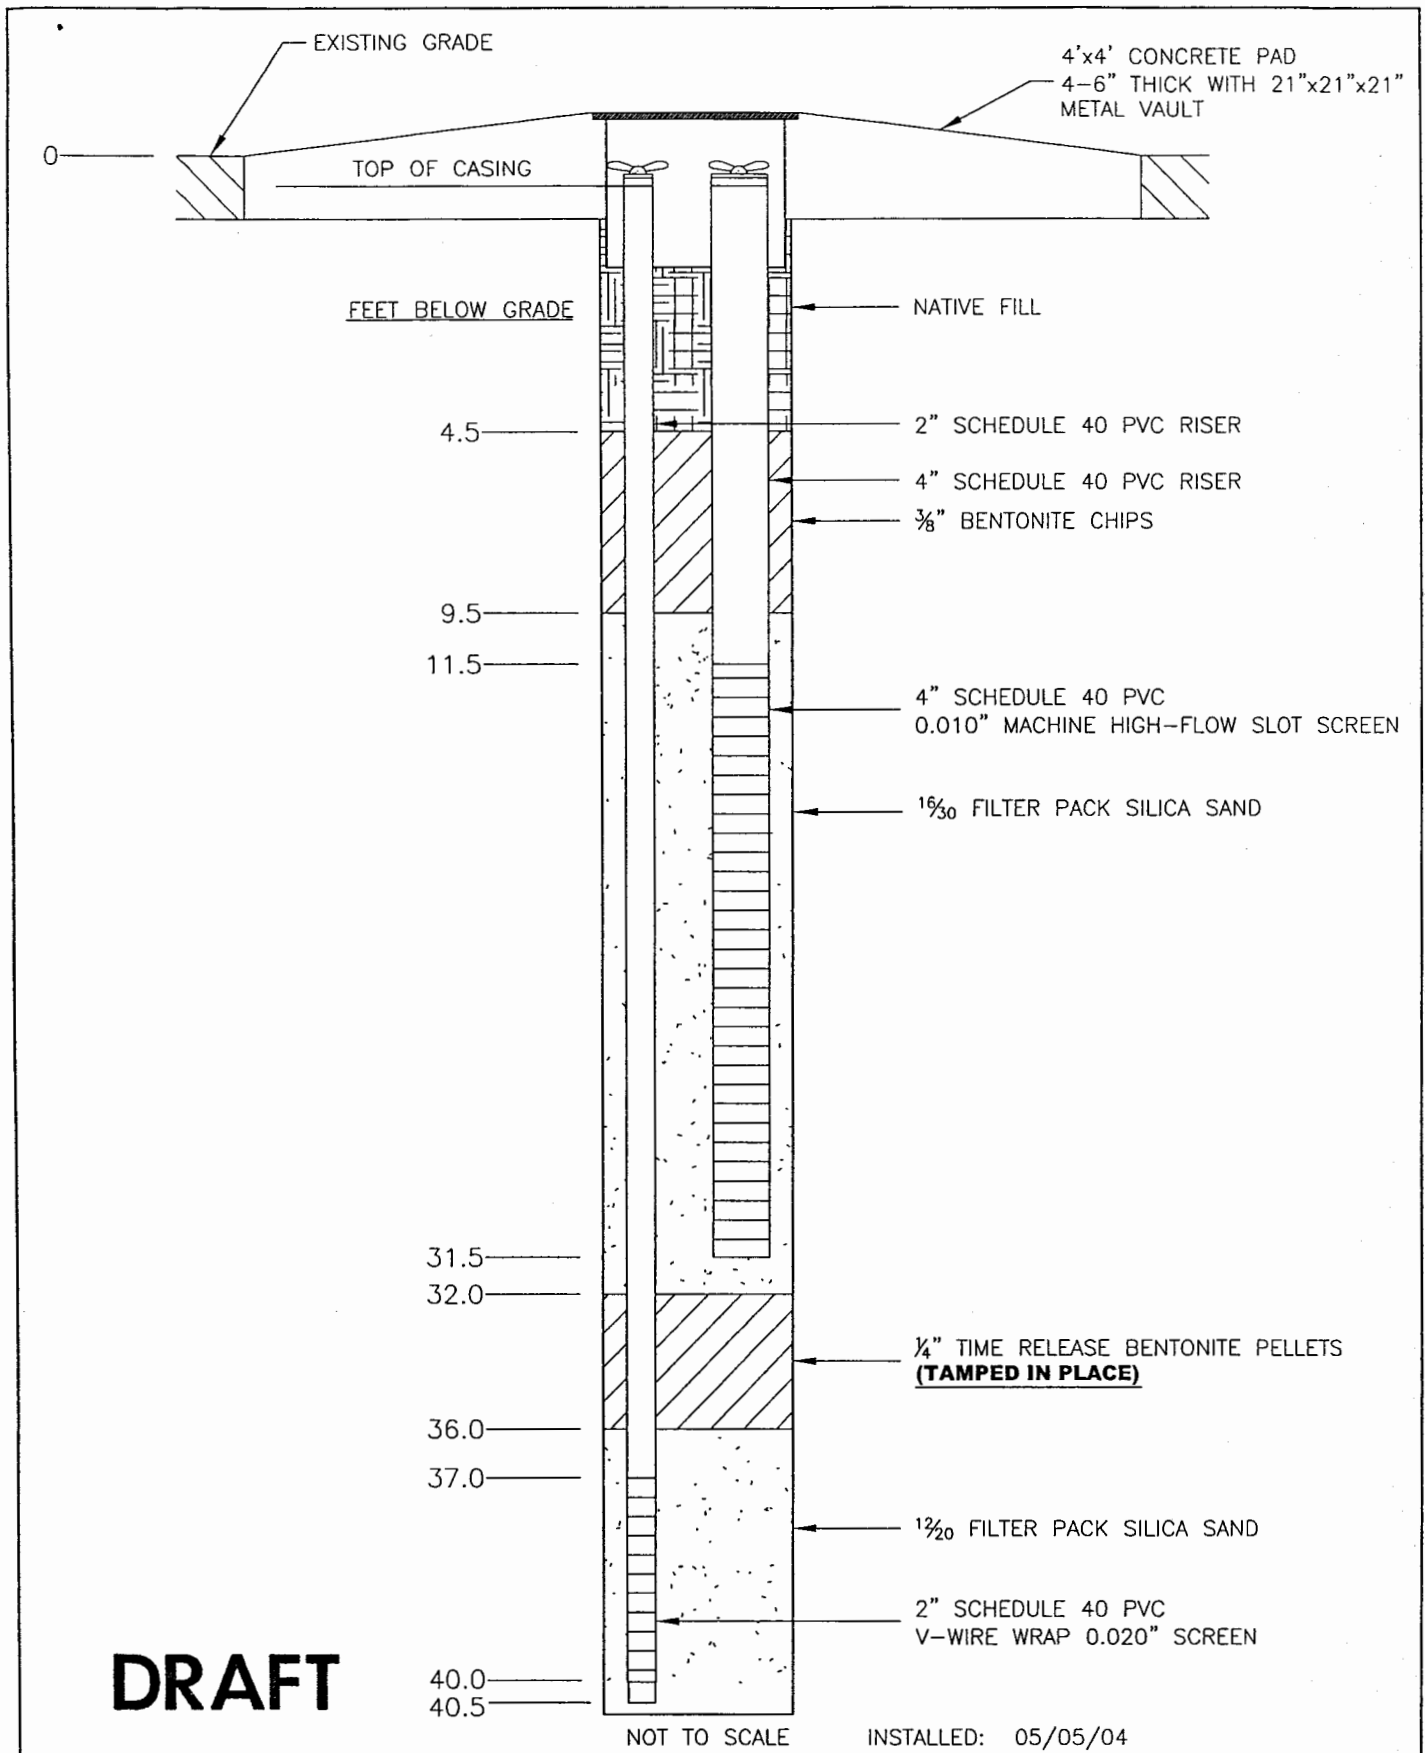

**DRAFT**

DATE	REVISED

Prepared By:  
**LEGGETTE, BRASHEARS & GRAHAM, INC.**  
 Professional Ground-Water and  
 Environmental Engineering Services  
 2103 Burlington Street  
 North Kansas City, Missouri 64116  
 (816) 421-7766

**MAGELLAN PIPELINE COMPANY, LLC**  
 KANSAS CITY TERMINAL  
 KANSAS CITY, KANSAS

MPE/SVE & AS WELL 04  
 CONSTRUCTION DIAGRAM

FILE: MPE\_AS\_04.dwg | DATE: MAY 2004 | FIGURE: 1