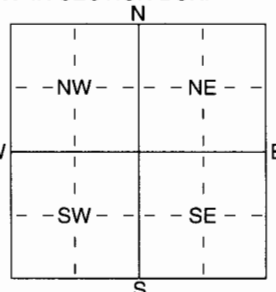


1 LOCATION OF WATER WELL: Fraction NW 1/4 NW 1/4 1/4 Section Number 35 Township Number T -10 S Range Number R 25 (E)N
 County: Wyandotte

Distance and direction from nearest town or city street address of well if located within city?
401 E. Donovan Rd. Kansas City

2 WATER WELL OWNER: Magellan Kansas City Terminal
 RR#, St. Address, Box # : 401 E. Donovan Rd. Board of Agriculture, Division of Water Resources
 City, State, ZIP Code : Kansas City, KS 66115 41 Application Number:


3 LOCATE WELL'S LOCATION WITH AN "X" IN SECTION BOX:

 4 DEPTH OF COMPLETED WELL 41 ft. ELEVATION: 795.3
 Depth(s) Groundwater Encountered 1 ft. 2 ft. 3 ft.
 WELL'S STATIC WATER LEVEL ft. below land surface measured on mo/day/yr
 Pump test data: Well water was ft. after hours pumping gpm
 Est. Yield gpm: Well water was ft. after hours pumping gpm
 WELL WATER TO BE USED AS: 5 Public water supply 8 Air conditioning 11 Injection well
 1 Domestic 3 Feedlot 6 Oil field water supply 9 Dewatering (12) Other (Specify below) Air Sparging / Soil Vapor Extraction Wells
 2 Irrigation 4 Industrial 7 Domestic (lawn & garden) 10 Monitoring well
 Was a chemical/bacteriological sample submitted to Department? Yes No X; If yes, mo/day/yrs sample was submitted
 Water Well Disinfected? Yes No —

5 TYPE OF BLANK CASING USED:
 1 Steel 3 RMP (SR) 5 Wrought iron 8 Concrete tile CASING JOINTS: Glued Clamped
 2 PVC 4 ABS 6 Asbestos-Cement 9 Other (specify below) Welded
 7 Fiberglass Threaded
 Blank casing diameter 2 in. to 37.5 ft., Dia 4 in. to 12.0 ft., Dia in. to ft.
 Casing height above land surface in., weight lbs./ft. Wall thickness or gauge No. Sch. 40
 TYPE OF SCREEN OR PERFORATION MATERIAL:
 1 Steel 3 Stainless Steel 5 Fiberglass 8 RMP (SR) 10 Asbestos-Cement
 2 Brass 4 Galvanized Steel 6 Concrete tile 9 ABS 11 Other (Specify)
 12 None used (open hole)
 SCREEN OR PERFORATION OPENINGS ARE:
 1 Continuous slot 3 Mill slot 5 Gauzed wrapped 8 Saw cut 11 None (open hole)
 2 Louvered shutter 4 Key punched 6 Wire wrapped 9 Drilled holes
 7 Torch cut 10 Other (specify) ft.
 SCREEN-PERFORATED INTERVALS: From 37.5 ft. to 40.5 ft., From 12.0 ft. to 32.0 ft.
 From ft. to ft., From ft. to ft.
 GRAVEL PACK INTERVALS: From 36.5 ft. to 41 ft., From 10.0 ft. to 32.5 ft.
 From ft. to ft., From ft. to ft.

6 GROUT MATERIAL: 1 Neat cement 2 Cement grout 3 Bentonite 4 Other
 Grout Intervals: From 32.5 ft. to 36.5 ft., From 5.0 ft. to 10.0 ft., From ft. to ft.
 What is the nearest source of possible contamination:
 1 Septic tank 4 Lateral lines 7 Pit privy 10 Livestock pens 14 Abandoned water well
 2 Sewer lines 5 Cess pool 8 Sewage lagoon 11 Fuel storage 15 Oil well/Gas well
 3 Watertight sewer lines 6 Seepage pit 9 Feedyard 12 Fertilizer storage 16 Other (specify below)
 13 Insecticide storage
 Direction from well? How many feet?

FROM	TO	LITHOLOGIC LOG	FROM	TO	PLUGGING INTERVALS
		<u>See attached Geologic Log</u>			

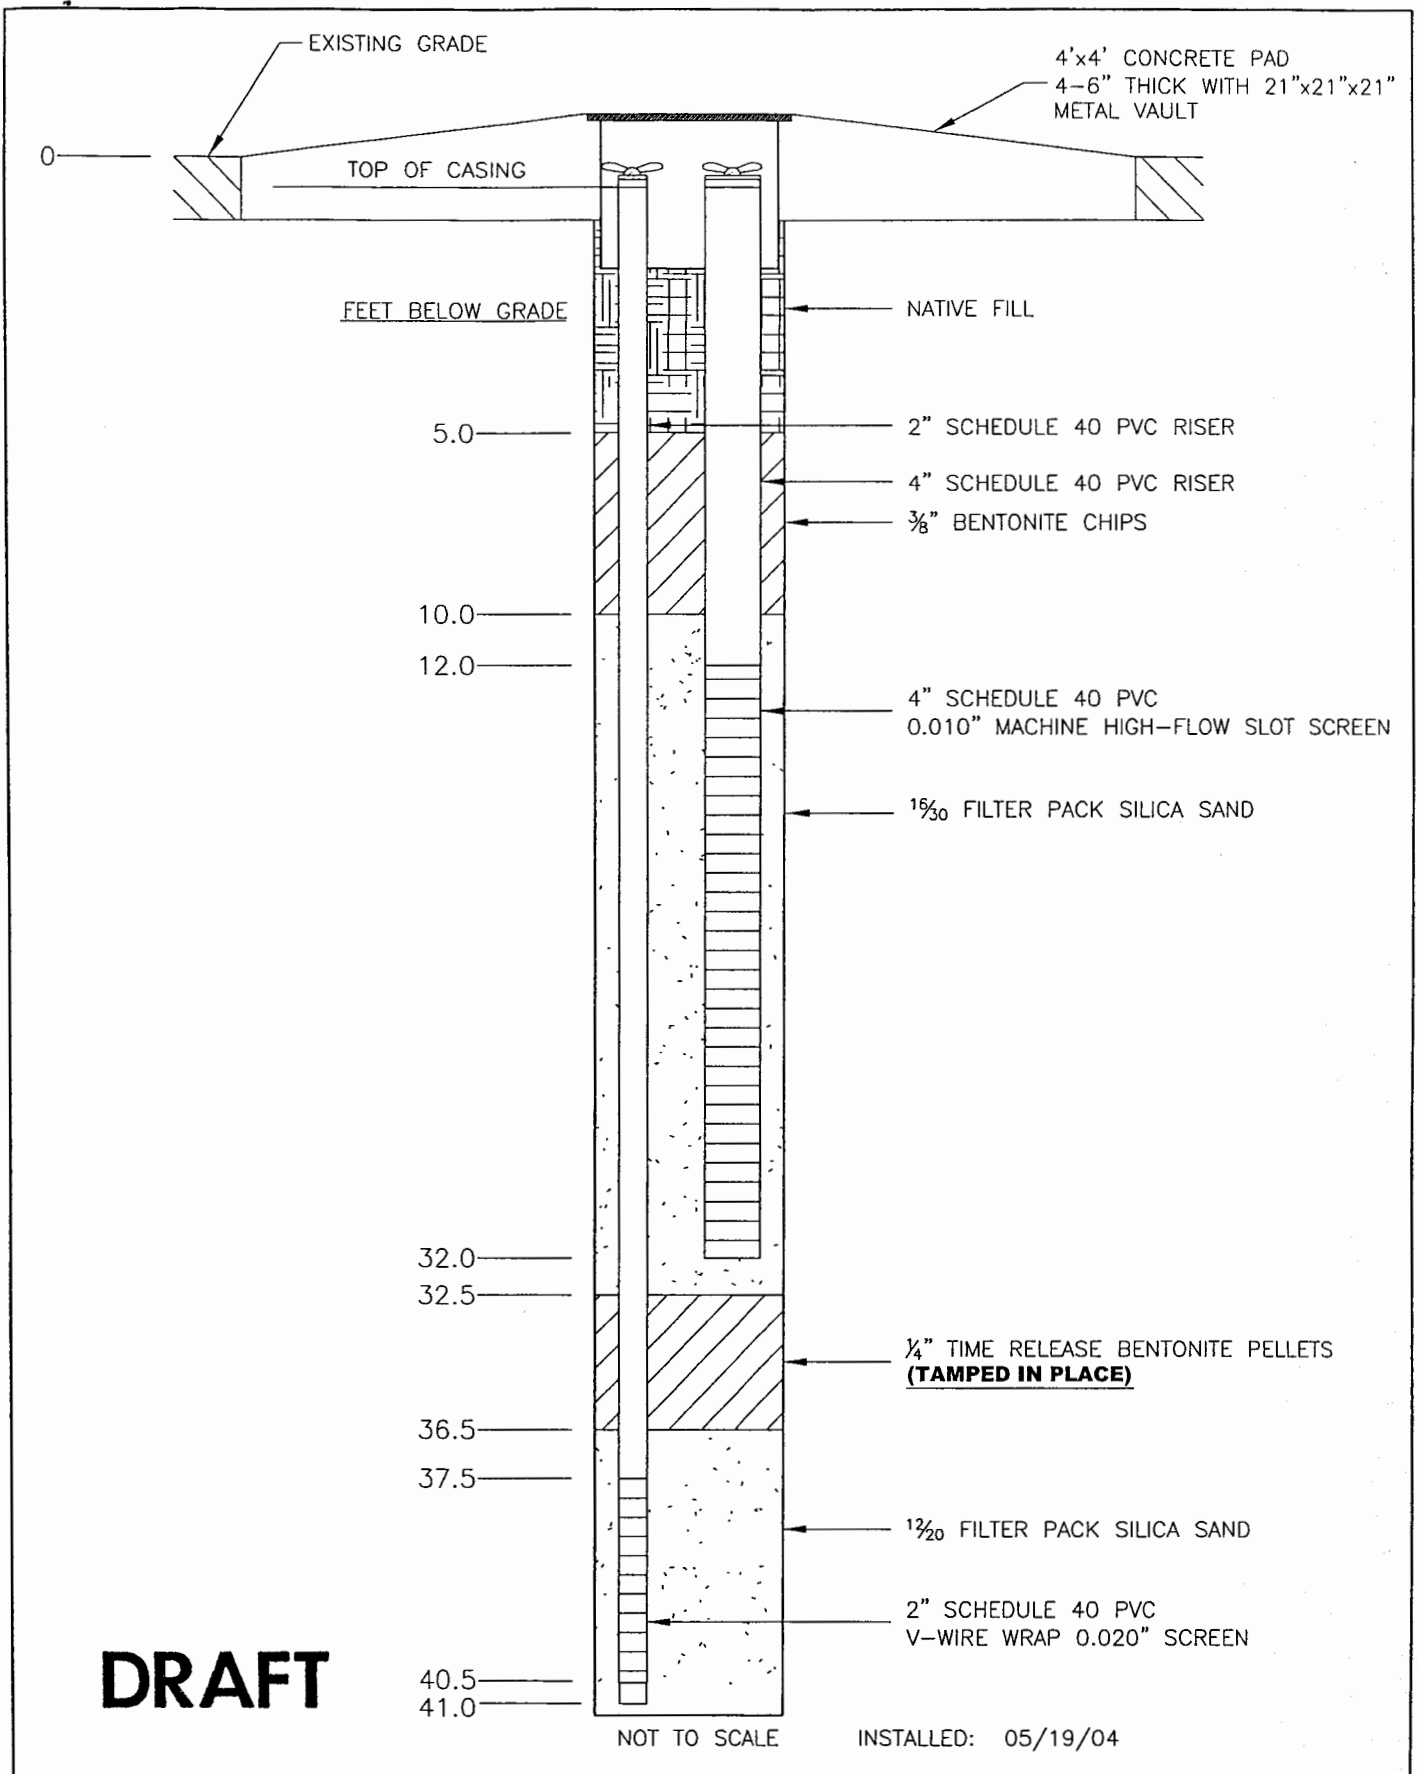7 CONTRACTOR'S OR LANDOWNER'S CERTIFICATION: This water well was (1) constructed, (2) reconstructed, or (3) plugged under my jurisdiction and was completed on (mo/day/year) 5/19/04 and this record is true to the best of my knowledge and belief. Kansas Water Well Contractor's Licence No 658 This Water Well Record was completed on (mo/day/yr) 7/29/04 under the business name of Boart Longyear Env. Dilling Division by (signature) [Signature]



DATE	REVISED	Prepared By:	MAGELLAN PIPELINE COMPANY, LLC
		LEGGETTE, BRASHEARS & GRAHAM, INC.	KANSAS CITY TERMINAL
		Professional Ground-Water and Environmental Engineering Services	KANSAS CITY, KANSAS
		2103 Burlington Street	MPE/SVE & AS WELL 06
		North Kansas City, Missouri 64116	CONSTRUCTION DIAGRAM
		(816) 421-7766	FILE: MPE_AS 06.dwg DATE: MAY 2004 FIGURE: 1