

1 LOCATION OF WATER WELL:	Fraction	Section Number	Township Number	Range Number
County: <u>Wyandotte</u>	<u>NW 1/4 NW 1/4 1/4</u>	<u>35</u>	T <u>-10</u> S	R <u>25</u> (EW)

Distance and direction from nearest town or city street address of well if located within city?  
401 E. Donovan Rd, Kansas City, KS

2 WATER WELL OWNER: Magellan Kansas City Terminal

RR#, St. Address, Box # : 401 E. Donovan Rd.

City, State, ZIP Code : Kansas City, KS 66115

Board of Agriculture, Division of Water Resources  
Application Number:

3 LOCATE WELL'S LOCATION WITH AN "X" IN SECTION BOX:

	<p>4 DEPTH OF COMPLETED WELL: <u>40.5</u> ft. ELEVATION: <u>744.7</u></p> <p>Depth(s) Groundwater Encountered 1 ..... ft. 2 ..... ft. 3 ..... ft.</p> <p>WELL'S STATIC WATER LEVEL ..... ft. below land surface measured on mo/day/yr</p> <p>Pump test data: Well water was ..... ft. after ..... hours pumping ..... gpm</p> <p>Est. Yield ..... gpm: Well water was ..... ft. after ..... hours pumping ..... gpm</p> <p>WELL WATER TO BE USED AS:</p> <table style="width:100%;"> <tr> <td>5 Public water supply</td> <td>8 Air conditioning</td> <td>11 Injection well</td> </tr> <tr> <td>1 Domestic</td> <td>3 Feedlot</td> <td>6 Oil field water supply</td> </tr> <tr> <td>2 Irrigation</td> <td>4 Industrial</td> <td>7 Domestic (lawn &amp; garden)</td> </tr> <tr> <td></td> <td></td> <td>9 Dewatering</td> </tr> <tr> <td></td> <td></td> <td>10 Monitoring well</td> </tr> <tr> <td></td> <td></td> <td>12 Other (Specify below)</td> </tr> </table> <p style="text-align: right;"><u>Air sparge / Soil Vapor Extraction Wells</u></p> <p>Was a chemical/bacteriological sample submitted to Department? Yes ..... No <u>X</u>; If yes, mo/day/yr sample was submitted</p> <p>Water Well Disinfected? Yes ..... No <u>    </u></p>	5 Public water supply	8 Air conditioning	11 Injection well	1 Domestic	3 Feedlot	6 Oil field water supply	2 Irrigation	4 Industrial	7 Domestic (lawn & garden)			9 Dewatering			10 Monitoring well			12 Other (Specify below)
5 Public water supply	8 Air conditioning	11 Injection well																	
1 Domestic	3 Feedlot	6 Oil field water supply																	
2 Irrigation	4 Industrial	7 Domestic (lawn & garden)																	
		9 Dewatering																	
		10 Monitoring well																	
		12 Other (Specify below)																	

5 TYPE OF BLANK CASING USED:

1 Steel	3 RMP (SR)	5 Wrought iron	8 Concrete tile	CASING JOINTS: Glued ..... Clamped .....	
<u>2 PVC</u>	4 ABS	6 Asbestos-Cement	9 Other (specify below)	Welded .....	
		7 Fiberglass		Threaded .....	

Blank casing diameter ..... 2 in. to 37.0 ft., Dia ..... 4 in. to 11.5 ft., Dia ..... in. to ..... ft.

Casing height above land surface ..... in., weight ..... lbs./ft. Wall thickness or gauge No. Sch. 40

TYPE OF SCREEN OR PERFORATION MATERIAL:

1 Steel	3 Stainless Steel	5 Fiberglass	<u>7 PVC</u>	10 Asbestos-Cement
2 Brass	4 Galvanized Steel	6 Concrete tile	8 RMP (SR)	11 Other (Specify) .....
			9 ABS	12 None used (open hole)

SCREEN OR PERFORATION OPENINGS ARE:

<u>1</u> Continuous slot	3 Mill slot	5 Gauzed wrapped	8 Saw cut	11 None (open hole)
2 Louvered shutter	4 Key punched	6 Wire wrapped	9 Drilled holes	
		7 Torch cut	<u>10</u> Other (specify) .....	

SCREEN-PERFORATED INTERVALS: From 37.0 ft. to 40.0 ft., From 11.5 ft. to 31.5 ft.

GRAVEL PACK INTERVALS: From 36.0 ft. to 40.5 ft., From 9.5 ft. to 32.0 ft.

6 GROUT MATERIAL: 1 Neat cement 2 Cement grout 3 Bentonite 4 Other .....

Grout Intervals: From 32.0 ft. to 36.0 ft., From 4.5 ft. to 9.5 ft., From ..... ft. to ..... ft.

What is the nearest source of possible contamination:


1 Septic tank	4 Lateral lines	7 Pit privy	<u>11</u> Fuel storage	14 Abandoned water well
2 Sewer lines	5 Cess pool	8 Sewage lagoon	12 Fertilizer storage	15 Oil well/Gas well
3 Watertight sewer lines	6 Seepage pit	9 Feedyard	13 Insecticide storage	16 Other (specify below)

Direction from well? ..... How many feet? .....

FROM	TO	LITHOLOGIC LOG	FROM	TO	PLUGGING INTERVALS
		<u>See attached Geologic Log</u>			

7 CONTRACTOR'S OR LANDOWNER'S CERTIFICATION: This water well was (1) constructed, (2) reconstructed, or (3) plugged under my jurisdiction and was completed on (mo/day/year) ..... 5/04/04 ..... and this record is true to the best of my knowledge and belief. Kansas Water Well Contractor's Licence No ..... 658 ..... This Water Well Record was completed on (mo/day/yr) ..... 7/29/04 ..... under the business name of Bart Wegman Env. Drilling Division by (signature) [Signature]



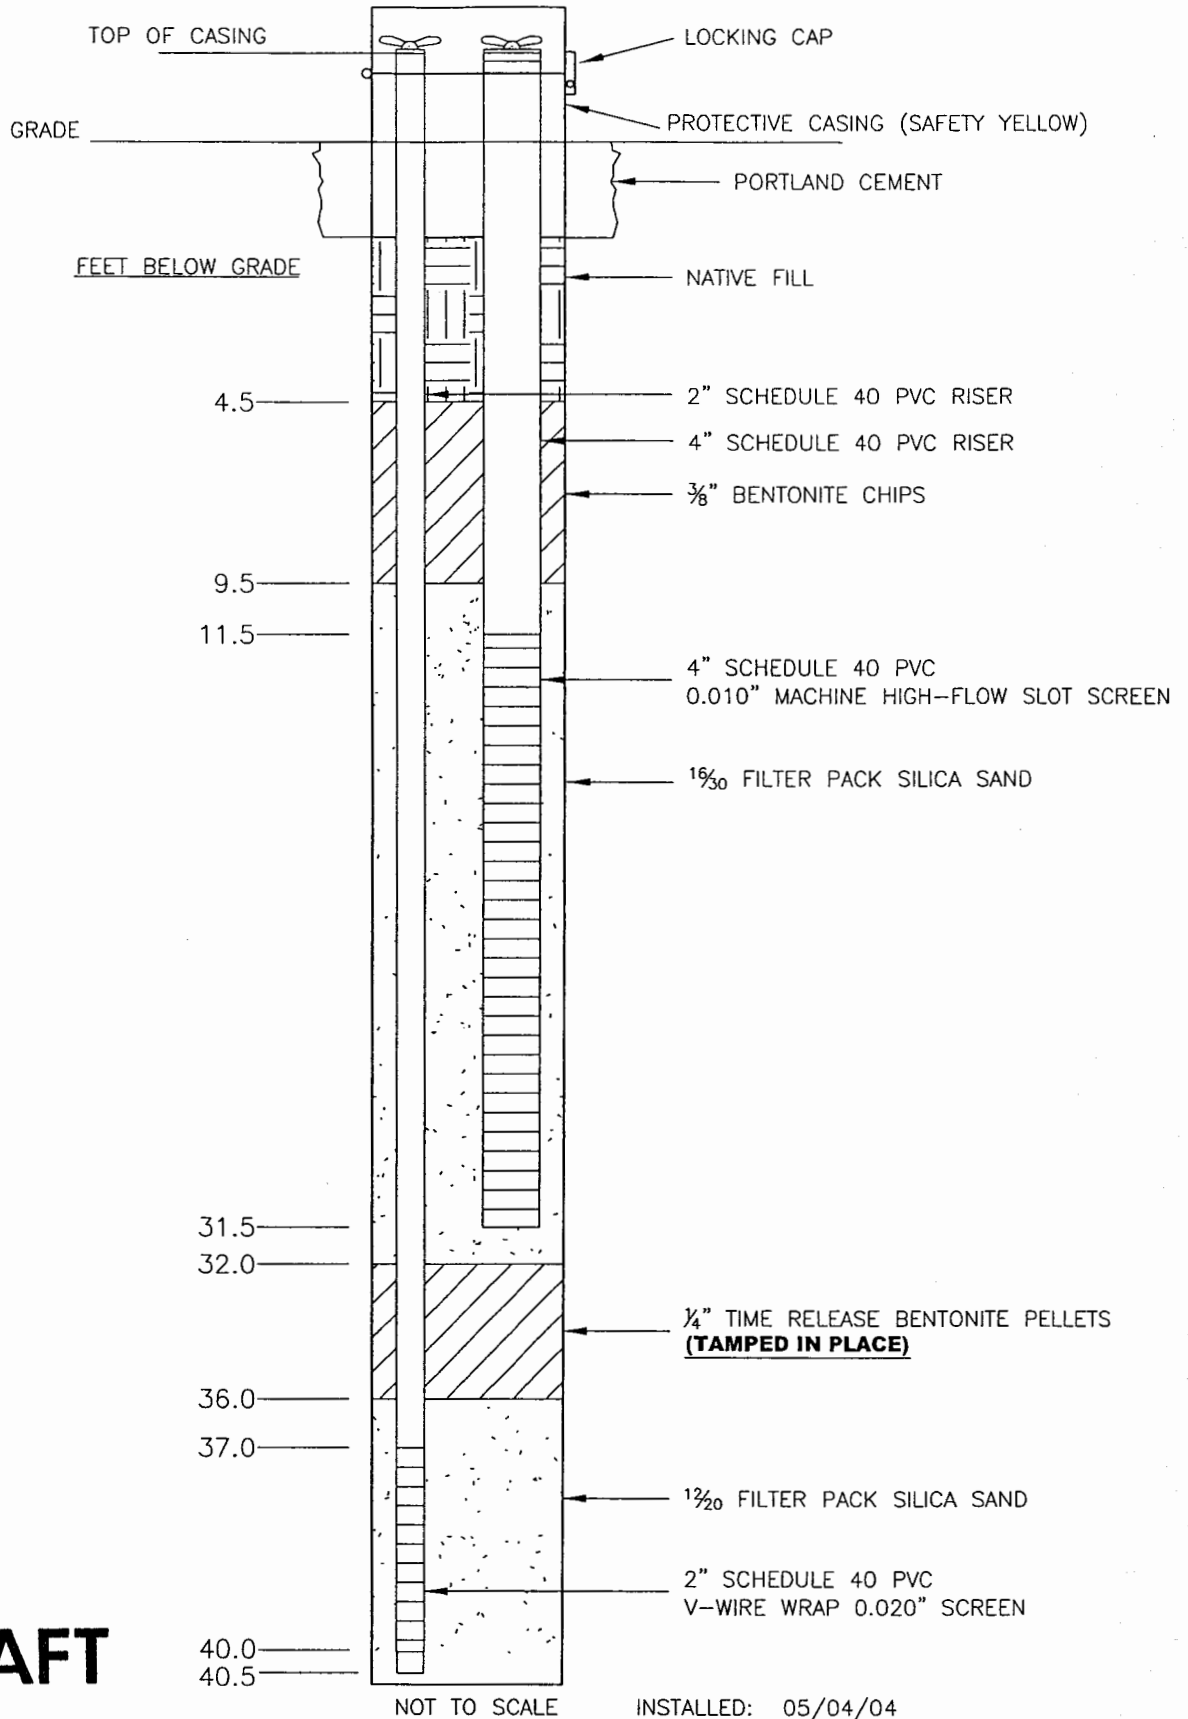

**DRAFT**

NOT TO SCALE

INSTALLED: 05/04/04

DATE	REVISED	Prepared By:	MAGELLAN PIPELINE COMPANY, LLC
		LEGGETTE, BRASHEARS & GRAHAM, INC.	KANSAS CITY TERMINAL
		Professional Ground-Water and	KANSAS CITY, KANSAS
		Environmental Engineering Services	MPE/SVE & AS WELL 12
		2103 Burlington Street	CONSTRUCTION DIAGRAM
		North Kansas City, Missouri 64116	FILE: MPE_AS 12.dwg
		(816) 421-7766	DATE: MAY 2004
			FIGURE: 1