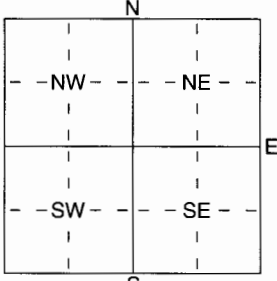


1 LOCATION OF WATER WELL: Fraction NW 1/4 NW 1/4 Section Number 35 Township Number T -10 S Range Number R 25 (EN)
 County: Wyandotte

Distance and direction from nearest town or city street address of well if located within city?
401 E. Donovan Rd. Kansas City

2 WATER WELL OWNER: Magellan Kansas City Terminal
 RR#, St. Address, Box # : 401 E. Donovan Rd. Board of Agriculture, Division of Water Resources
 City, State, ZIP Code : Kansas City, KS 66115 Application Number:

3 LOCATE WELL'S LOCATION WITH AN "X" IN SECTION BOX:

 4 DEPTH OF COMPLETED WELL 39.5 ft. ELEVATION: 743.6
 Depth(s) Groundwater Encountered 1 ft. 2 ft. 3 ft.
 WELL'S STATIC WATER LEVEL ft. below land surface measured on mo/day/yr
 Pump test data: Well water was ft. after hours pumping gpm
 Est. Yield gpm: Well water was ft. after hours pumping gpm
 WELL WATER TO BE USED AS: 5 Public water supply 8 Air conditioning 11 Injection well
 1 Domestic 3 Feedlot 6 Oil field water supply 9 Dewatering (12) Other (Specify below)
 2 Irrigation 4 Industrial 7 Domestic (lawn & garden) 10 Monitoring well Air Sparge / Soil Vapors
Extraction Wells
 Was a chemical/bacteriological sample submitted to Department? Yes No ; If yes, mo/day/yr sample was submitted
 Water Well Disinfected? Yes No


5 TYPE OF BLANK CASING USED:
 1 Steel 3 RMP (SR) 5 Wrought iron 8 Concrete tile CASING JOINTS: Glued Clamped
 2 PVC 4 ABS 6 Asbestos-Cement 9 Other (specify below) Welded
 7 Fiberglass Threaded X
 Blank casing diameter 2 in. to 36.0 ft. Dia 4 in. to 10.5 ft. Dia in. to ft.
 Casing height above land surface in., weight lbs./ft. Wall thickness or gauge No. Sch. 40
 TYPE OF SCREEN OR PERFORATION MATERIAL:
 1 Steel 3 Stainless Steel 5 Fiberglass 7 PVC 10 Asbestos-Cement
 2 Brass 4 Galvanized Steel 6 Concrete tile 8 RMP (SR) 11 Other (Specify)
 9 ABS 12 None used (open hole)
 SCREEN OR PERFORATION OPENINGS ARE:
 1 Continuous slot 3 Mill slot 5 Guazed wrapped 8 Saw cut 11 None (open hole)
 2 Louvered shutter 4 Key punched 6 Wire wrapped 9 Drilled holes
 7 Torch cut 10 Other (specify) ft.
 SCREEN-PERFORATED INTERVALS: From 36.0 (2") ft. to 39.0 ft., From 10.5 ft. to 30.5 ft.
 From ft. to ft., From ft. to ft.
 GRAVEL PACK INTERVALS: From 35.0 ft. to 39.5 ft., From 8.5 ft. to 31.0 ft.
 From ft. to ft., From ft. to ft.

6 GROUT MATERIAL: 1 Neat cement 2 Cement grout 3 Bentonite 4 Other
 Grout Intervals: From 31.0 ft. to 35.0 ft., From 3.5 ft. to 8.5 ft., From ft. to ft.
 What is the nearest source of possible contamination:
 1 Septic tank 4 Lateral lines 7 Pit privy 10 Livestock pens 14 Abandoned water well
 2 Sewer lines 5 Cess pool 8 Sewage lagoon 11 Fuel storage 15 Oil well/Gas well
 3 Watertight sewer lines 6 Seepage pit 9 Feedyard 12 Fertilizer storage 16 Other (specify below)
 13 Insecticide storage
 Direction from well? How many feet?

FROM	TO	LITHOLOGIC LOG	FROM	TO	PLUGGING INTERVALS
		<u>See attached Geologic Log</u>			

7 CONTRACTOR'S OR LANDOWNER'S CERTIFICATION: This water well was (1) constructed, (2) reconstructed, or (3) plugged under my jurisdiction and was completed on (mo/day/year) 5/26/04 and this record is true to the best of my knowledge and belief. Kansas Water Well Contractor's Licence No 058 This Water Well Record was completed on (mo/day/yr) 7/29/04 under the business name of Boat Longyear Env. Drilling Division by (signature) [Signature]

INSTRUCTIONS: Use typewriter or ball point pen. PLEASE PRESS FIRMLY and PRINT clearly. Please fill in blanks, underline or circle the correct answers. Send three copies to Kansas Department of Health and Environment, Bureau of Water, Geology Section, 1000 SW Jackson St., Suite 420, Topeka, Kansas 66612-1367. Telephone 785-296-5522. Send one to WATER WELL OWNER and retain one for your records. Fee of \$5.00 for each constructed well.

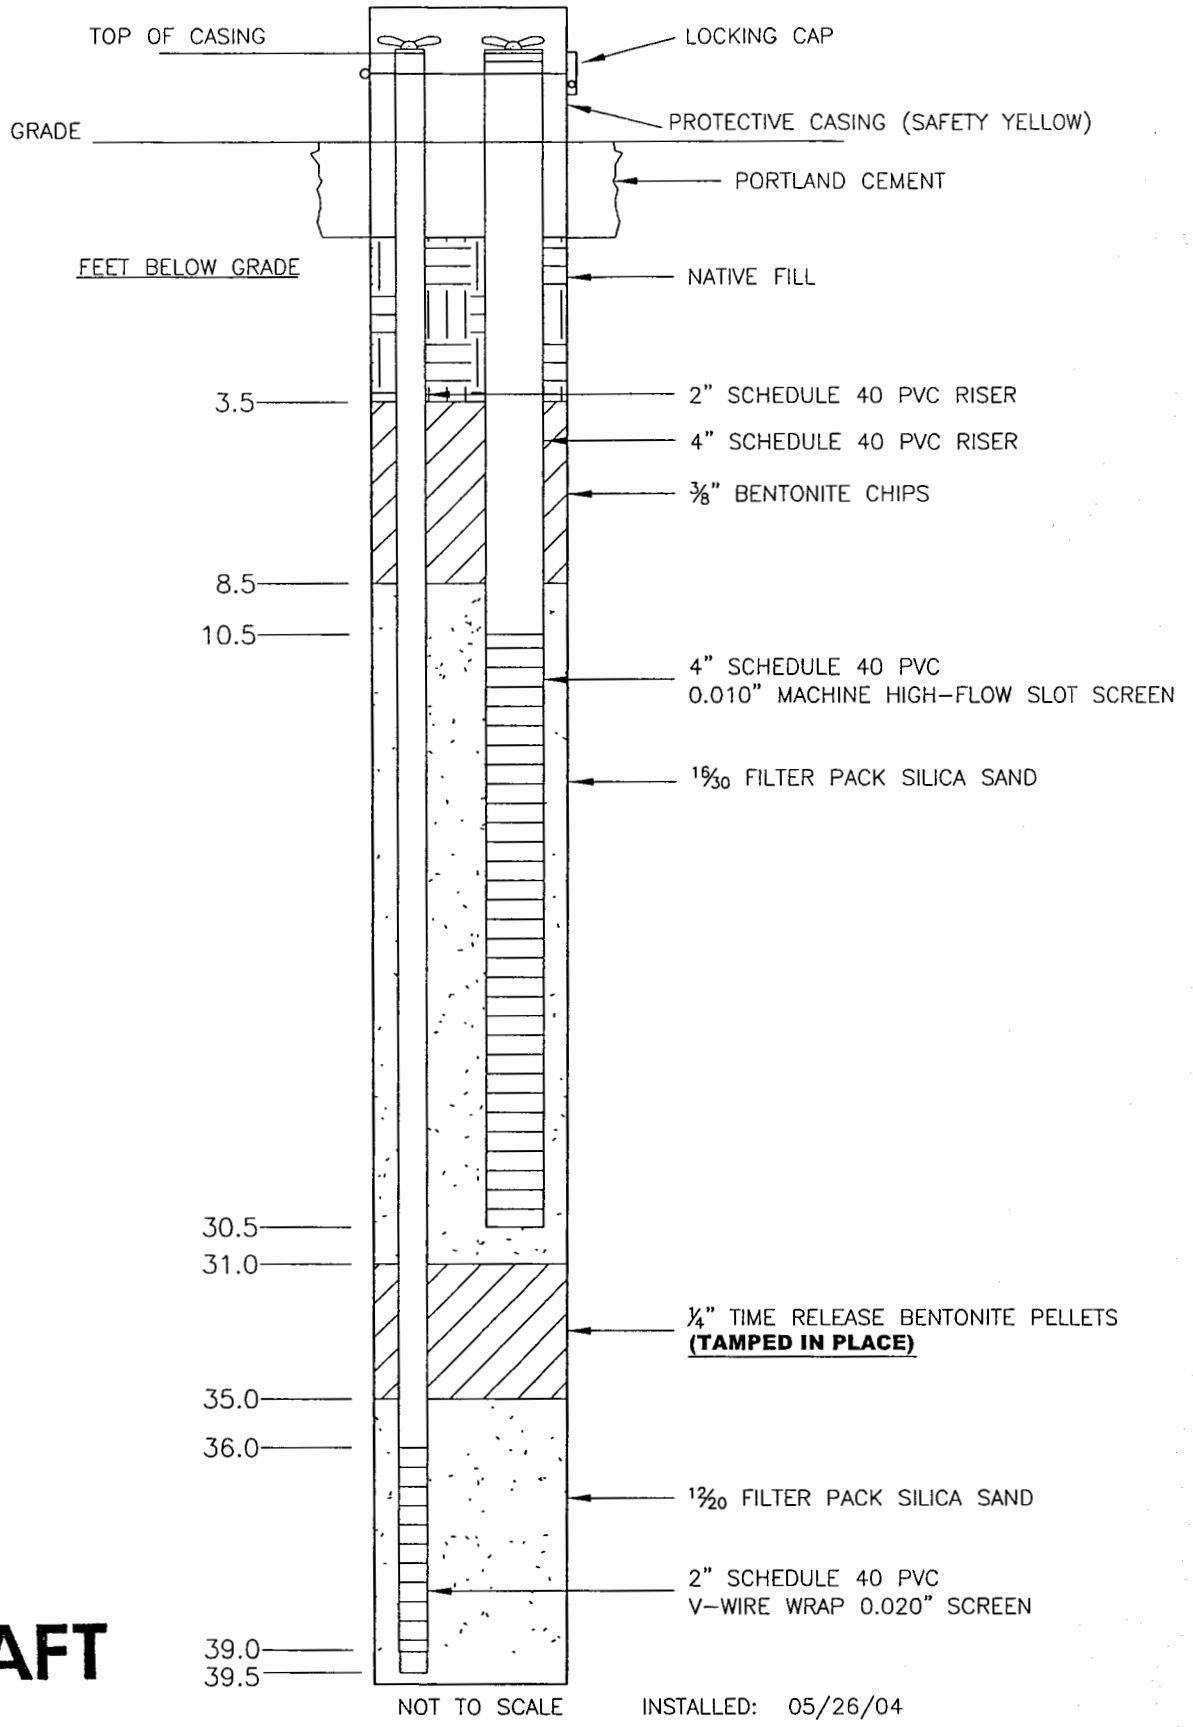

DRAFT

DATE	REVISED	Prepared By:	MAGELLAN PIPELINE COMPANY, LLC
		LEGGETTE, BRASHEARS & GRAHAM, INC.	KANSAS CITY TERMINAL
		Professional Ground-Water and Environmental Engineering Services	KANSAS CITY, KANSAS
		2103 Burlington Street	MPE/SVE & AS WELL 17
		North Kansas City, Missouri 64116	CONSTRUCTION DIAGRAM
		(816) 421-7766	FILE: MPE_AS 17.dwg DATE: MAY 2004 FIGURE: 1