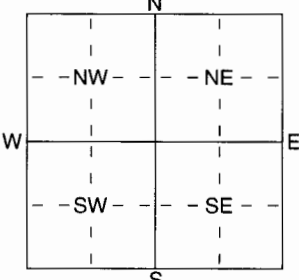


1 LOCATION OF WATER WELL: Fraction NW 1/4 NW 1/4 Section Number 35 Township Number T -10 S Range Number R 25 (E/W)  
 County: Wyandotte

Distance and direction from nearest town or city street address of well if located within city?  
401 E. Donovan Rd., Kansas City, KS

2 WATER WELL OWNER: Magellan Kansas City Terminal  
 RR#, St. Address, Box # : 401 E. Donovan Rd. Board of Agriculture, Division of Water Resources  
 City, State, ZIP Code : Kansas City, KS 66115 Application Number:

3 LOCATE WELL'S LOCATION WITH AN "X" IN SECTION BOX:  
  
 4 DEPTH OF COMPLETED WELL 38 ft. ELEVATION: 742.90  
 Depth(s) Groundwater Encountered 1 ..... ft. 2 ..... ft. 3 ..... ft.  
 WELL'S STATIC WATER LEVEL ..... ft. below land surface measured on mo/day/yr .....  
 Pump test data: Well water was ..... ft. after ..... hours pumping ..... gpm  
 Est. Yield ..... gpm: Well water was ..... ft. after ..... hours pumping ..... gpm  
 WELL WATER TO BE USED AS: 5 Public water supply 8 Air conditioning 11 Injection well  
 1 Domestic 3 Feedlot 6 Oil field water supply 9 Dewatering (12) Other (Specify below) Air Sparge / Soil vapor  
 2 Irrigation 4 Industrial 7 Domestic (lawn & garden) 10 Monitoring well  
 Was a chemical/bacteriological sample submitted to Department? Yes ..... No X .....; If yes, mo/day/yr sample was submitted  
 Water Well Disinfected? Yes ..... No X .....  
Extraction Wells

5 TYPE OF BLANK CASING USED:  
 1 Steel 3 RMP (SR) 5 Wrought iron 8 Concrete tile CASING JOINTS: Glued ..... Clamped .....  
 2 PVC 4 ABS 6 Asbestos-Cement 9 Other (specify below) Welded .....  
 7 Fiberglass Threaded X  
 Blank casing diameter ..... in. to 35.0 ft., Dia 4 in. to 9.5 ft., Dia ..... in. to ..... ft.  
 Casing height above land surface ..... in., weight ..... lbs./ft. Wall thickness or gauge No. Sch. 40  
 TYPE OF SCREEN OR PERFORATION MATERIAL:  
 1 Steel 3 Stainless Steel 5 Fiberglass 7 PVC 10 Asbestos-Cement  
 2 Brass 4 Galvanized Steel 6 Concrete tile 8 RMP (SR) 11 Other (Specify) .....  
 9 ABS 12 None used (open hole)  
 SCREEN OR PERFORATION OPENINGS ARE:  
 1 Continuous slot 3 Mill slot 5 Gauzed wrapped 8 Saw cut 11 None (open hole)  
 2 Louvered shutter 4 Key punched 6 Wire wrapped 9 Drilled holes  
 7 Torch cut 10 Other (specify) ..... ft.  
 SCREEN-PERFORATED INTERVALS: From 35.0 ft. to 38.0 ft., From 9.5 ft. to 29.5 ft.  
 From ..... ft. to ..... ft., From ..... ft. to ..... ft.  
 GRAVEL PACK INTERVALS: From 34.0 ft. to 38.5 ft., From 7.5 ft. to 30.0 ft.  
 From ..... ft. to ..... ft., From ..... ft. to ..... ft.


6 GROUT MATERIAL: 1 Neat cement 2 Cement grout 3 Bentonite 4 Other .....  
 Grout Intervals: From 30.0 ft. to ..... ft., From 34.0 ft. to 2.5 ft., From 7.5 ft. to ..... ft.  
 What is the nearest source of possible contamination:  
 1 Septic tank 4 Lateral lines 7 Pit privy 10 Livestock pens 14 Abandoned water well  
 2 Sewer lines 5 Cess pool 8 Sewage lagoon 11 Fuel storage 15 Oil well/Gas well  
 3 Watertight sewer lines 6 Seepage pit 9 Feedyard 12 Fertilizer storage 16 Other (specify below)  
 13 Insecticide storage .....  
 Direction from well? How many feet?

FROM	TO	LITHOLOGIC LOG	FROM	TO	PLUGGING INTERVALS
		<u>See attached Geologic Log</u>			

7 CONTRACTOR'S OR LANDOWNER'S CERTIFICATION: This water well was (1) constructed, (2) reconstructed, or (3) plugged under my jurisdiction and was completed on (mo/day/year) 5/16/04 and this record is true to the best of my knowledge and belief. Kansas Water Well Contractor's Licence No 058 This Water Well Record was completed on (mo/day/yr) 7/29/04 under the business name of Bart Longyear Env. Drilling Division by (signature) [Signature]

INSTRUCTIONS: Use typewriter or ball point pen. PLEASE PRESS FIRMLY and PRINT clearly. Please fill in blanks, underline or circle the correct answers. Send top three copies to Kansas Department of Health and Environment, Bureau of Water, Geology Section, 1000 SW Jackson St., Suite 420, Topeka, Kansas 66612-1367. Telephone 785-296-5522. Send one to WATER WELL OWNER and retain one for your records. Fee of \$5.00 for each constructed well.



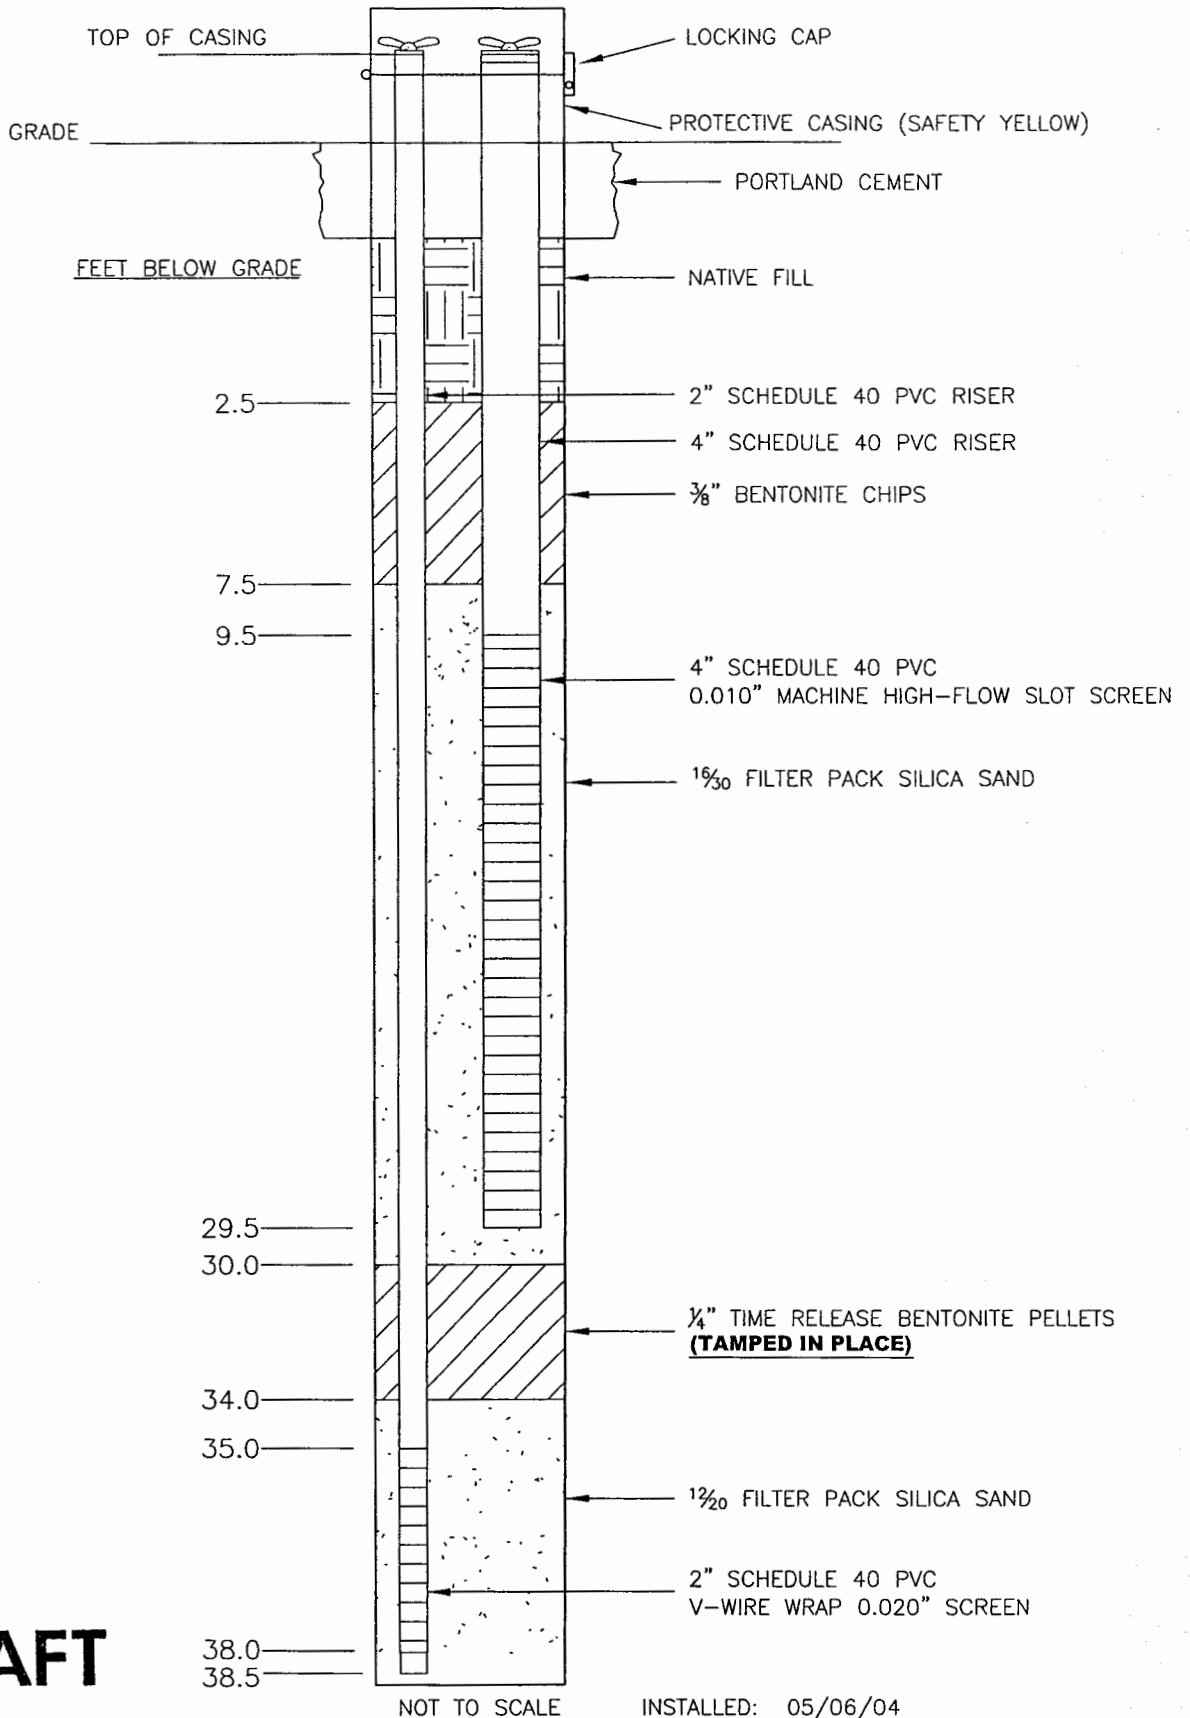

**DRAFT**

DATE	REVISED

Prepared By:  
 LEGGETTE, BRASHEARS & GRAHAM, INC.  
 Professional Ground-Water and  
 Environmental Engineering Services  
 2103 Burlington Street  
 North Kansas City, Missouri 64116  
 (816) 421-7766

MAGELLAN PIPELINE COMPANY, LLC  
 KANSAS CITY TERMINAL  
 KANSAS CITY, KANSAS  
 MPE/SVE & AS WELL 20  
 CONSTRUCTION DIAGRAM

FILE: MPE\_AS 20.dwg | DATE: MAY 2004 | FIGURE: 1