

1 LOCATION OF WATER WELL: County: <u>Wyandotte</u>	Fraction <u>nw 1/4 nw 1/4</u>	Section Number <u>35</u>	Township Number <u>T -10 S</u>	Range Number <u>R 25 (EW)</u>
---	----------------------------------	-----------------------------	-----------------------------------	----------------------------------

Distance and direction from nearest town or city street address of well if located within city?
401 E. Donovan Rd., Kansas City

2 WATER WELL OWNER: Magellan Kansas City Terminal
 RR#, St. Address, Box # : 401 E Donovan Rd.
 City, State, ZIP Code : Kansas City, KS 66115
 Board of Agriculture, Division of Water Resources
 Application Number:

3 LOCATE WELL'S LOCATION WITH AN "X" IN SECTION BOX:

N			
-NW-		-NE-	
-SW-		-SE-	
S			

4 DEPTH OF COMPLETED WELL 38.5 ft. ELEVATION: 742.73

Depth(s) Groundwater Encountered 1 ft. 2 ft. 3 ft.
 WELL'S STATIC WATER LEVEL ft. below land surface measured on mo/day/yr
 Pump test data: Well water was ft. after hours pumping gpm
 Est. Yield gpm: Well water was ft. after hours pumping gpm
 WELL WATER TO BE USED AS:
 1 Domestic 3 Feedlot 6 Oil field water supply 9 Dewatering (12) Other (Specify below)
 2 Irrigation 4 Industrial 7 Domestic (lawn & garden) 10 Monitoring well Air Sparge / Soil Vapors
Extraction Wells

Was a chemical/bacteriological sample submitted to Department? Yes No X; If yes, mo/day/yr sample was submitted
 Water Well Disinfected? Yes No —

5 TYPE OF BLANK CASING USED:
 1 Steel 3 RMP (SR) 5 Wrought iron 8 Concrete tile CASING JOINTS: Glued Clamped
 2 PVC 4 ABS 6 Asbestos-Cement 9 Other (specify below) Welded
 7 Fiberglass Threaded X

Blank casing diameter 2 in. to 35.0 ft. Dia 4 in. to 9.5 ft. Dia in. to ft.
 Casing height above land surface in., weight lbs./ft. Wall thickness or guage No. Sch. 40

TYPE OF SCREEN OR PERFORATION MATERIAL:
 1 Steel 3 Stainless Steel 5 Fiberglass 8 RMP (SR) 10 Asbestos-Cement
 2 Brass 4 Galvanized Steel 6 Concrete tile 9 ABS 11 Other (Specify)
 12 None used (open hole)

SCREEN OR PERFORATION OPENINGS ARE:
 1 Continuous slot 3 Mill slot 5 Gauzed wrapped 8 Saw cut 11 None (open hole)
 2 Louvered shutter 4 Key punched 6 Wire wrapped 9 Drilled holes
 7 Torch cut 10 Other (specify) ft.

SCREEN-PERFORATED INTERVALS: From 35.0 (P") ft. to 38.0 ft., From 9.5 ft. to 29.5 ft.
 From ft. to ft., From ft. to ft.
 GRAVEL PACK INTERVALS: From 34.0 ft. to 38.5 ft., From 7.5 ft. to 30.0 ft.
 From ft. to ft., From ft. to ft.


6 GROUT MATERIAL: 1 Neat cement 2 Cement grout 3 Bentonite 4 Other.....
 Grout Intervals: From 30.0 ft. to 34.0 ft., From 2.5 ft. to 7.5 ft., From ft. to ft.

What is the nearest source of possible contamination:
 1 Septic tank 4 Lateral lines 7 Pit privy 10 Livestock pens 14 Abandoned water well
 2 Sewer lines 5 Cess pool 8 Sewage lagoon 11 Fuel storage 15 Oil well/Gas well
 3 Watertight sewer lines 6 Seepage pit 9 Feedyard 12 Fertilizer storage 16 Other (specify below)
 13 Insecticide storage

Direction from well? How many feet?

FROM	TO	LITHOLOGIC LOG	FROM	TO	PLUGGING INTERVALS
		<u>See attached Geologic Log</u>			

7 CONTRACTOR'S OR LANDOWNER'S CERTIFICATION: This water well was (1) constructed, (2) reconstructed, or (3) plugged under my jurisdiction and was completed on (mo/day/year) 5/12/04 and this record is true to the best of my knowledge and belief. Kansas Water Well Contractor's Licence No 6658 This Water Well Record was completed on (mo/day/yr) 7/29/04 under the business name of Boart Longyear Env. Drilling Division by (signature) [Signature]

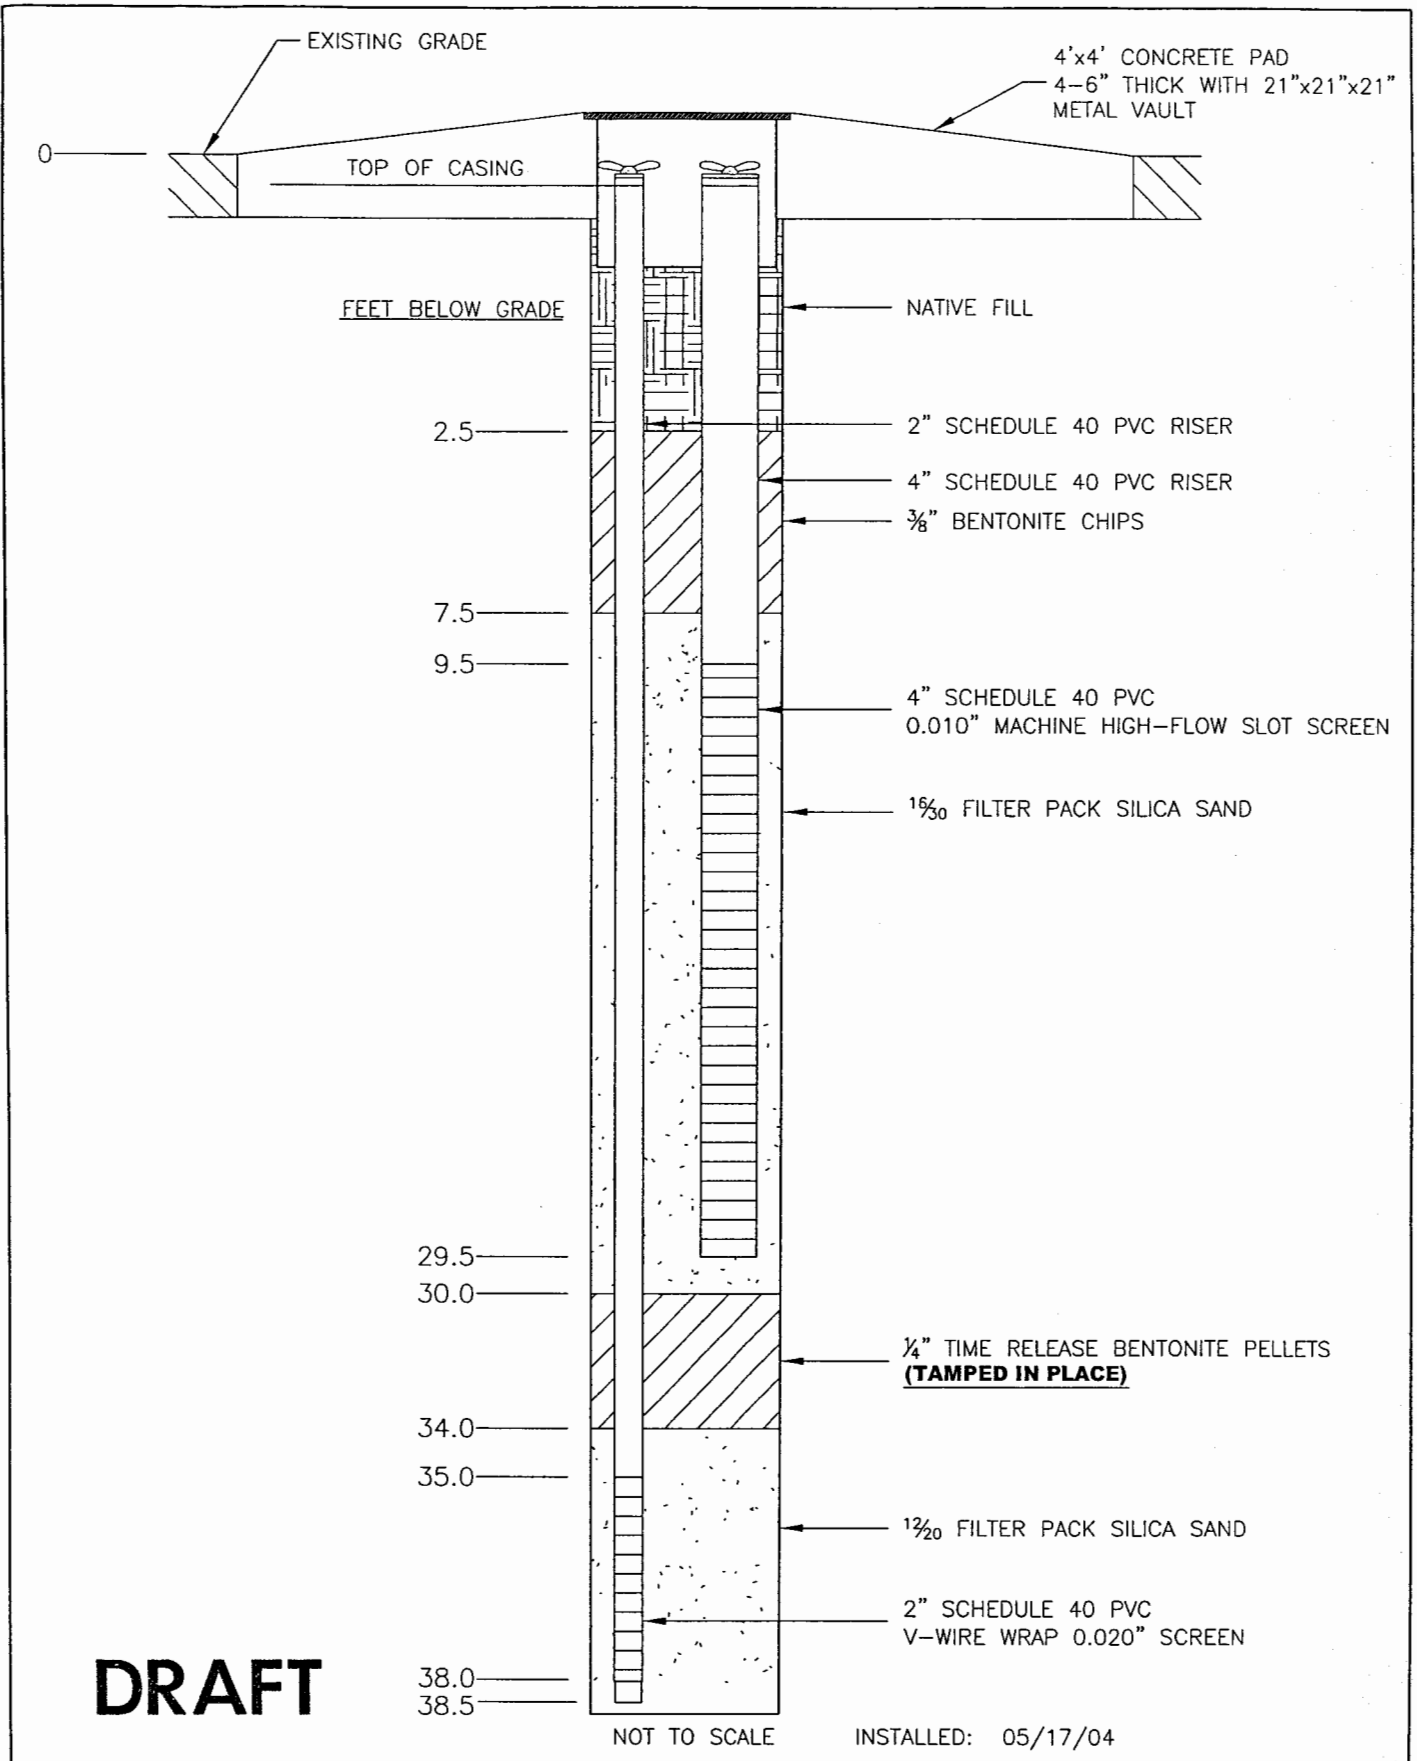

DRAFT

NOT TO SCALE

INSTALLED: 05/17/04

DATE	REVISED	Prepared By:	MAGELLAN PIPELINE COMPANY, LLC
		LEGGETTE, BRASHEARS & GRAHAM, INC.	KANSAS CITY TERMINAL
		Professional Ground-Water and	KANSAS CITY, KANSAS
		Environmental Engineering Services	MPE/SVE & AS WELL 25
		2103 Burlington Street	CONSTRUCTION DIAGRAM
		North Kansas City, Missouri 64116	FILE: MPE_AS 25.dwg
		(816) 421-7766	DATE: MAY 2004
			FIGURE: 1