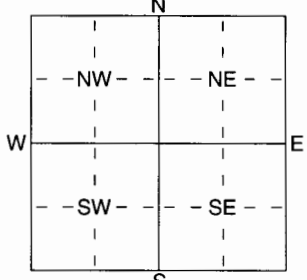


MPE 26

1 LOCATION OF WATER WELL: Fraction NW 1/4 NW 1/4 Section Number 35 Township Number T -10 S Range Number R 25 EW  
 County: Wyandotte

Distance and direction from nearest town or city street address of well if located within city?  
401 E. Donovan Rd., Kansas City

2 WATER WELL OWNER: Magellan Kansas City Terminal  
 RR#, St. Address, Box #: 401 E. Donovan Rd. Board of Agriculture, Division of Water Resources  
 City, State, ZIP Code: Kansas City, KS 64115 Application Number:

3 LOCATE WELL'S LOCATION WITH AN "X" IN SECTION BOX:  
  
 4 DEPTH OF COMPLETED WELL: 39 ft. ELEVATION: 743.25  
 Depth(s) Groundwater Encountered 1 ..... ft. 2 ..... ft. 3 ..... ft.  
 WELL'S STATIC WATER LEVEL ..... ft. below land surface measured on mo/day/yr .....  
 Pump test data: Well water was ..... ft. after ..... hours pumping ..... gpm  
 Est. Yield ..... gpm: Well water was ..... ft. after ..... hours pumping ..... gpm  
 WELL WATER TO BE USED AS:  
 1 Domestic 3 Feedlot 6 Oil field water supply 9 Dewatering 11 Injection well  
 2 Irrigation 4 Industrial 7 Domestic (lawn & garden) 10 Monitoring well  
(12) Other (Specify below)  
Air Sparge / Soil Vapor Extraction Wells  
 Was a chemical/bacteriological sample submitted to Department? Yes ..... No X .....; If yes, mo/day/yr sample was submitted  
 Water Well Disinfected? Yes ..... No X .....


5 TYPE OF BLANK CASING USED:  
 1 Steel 3 RMP (SR) 5 Wrought iron 8 Concrete tile CASING JOINTS: Glued ..... Clamped .....  
 2 PVC 4 ABS 6 Asbestos-Cement 9 Other (specify below) Welded .....  
 7 Fiberglass Threaded X  
 Blank casing diameter 2 in. to 35.5 ft. Dia 4 in. to 10.0 ft. Dia ..... in. to ..... ft.  
 Casing height above land surface ..... in., weight ..... lbs./ft. Wall thickness or gauge No. Sch. 40  
 TYPE OF SCREEN OR PERFORATION MATERIAL:  
 1 Steel 3 Stainless Steel 5 Fiberglass 8 RMP (SR) 10 Asbestos-Cement  
 2 Brass 4 Galvanized Steel 6 Concrete tile 9 ABS 11 Other (Specify) .....  
 12 None used (open hole)  
 SCREEN OR PERFORATION OPENINGS ARE:  
 1 Continuous slot 3 Mill slot 5 Gauzed wrapped 8 Saw cut 11 None (open hole)  
 2 Louvered shutter 4 Key punched 6 Wire wrapped 9 Drilled holes  
 7 Torch cut 10 Other (specify) ..... ft.  
 SCREEN-PERFORATED INTERVALS: From 35.5 (6") ft. to 38.5 ft., From 10.0 ft. to 30.0 ft.  
 From ..... ft. to ..... ft., From ..... ft. to ..... ft.  
 GRAVEL PACK INTERVALS: From 34.5 ft. to 39 ft., From 8.0 ft. to 30.5 ft.  
 From ..... ft. to ..... ft., From ..... ft. to ..... ft.

6 GROUT MATERIAL: 1 Neat cement 2 Cement grout 3 Bentonite 4 Other .....  
 Grout Intervals: From 30.5 ft. to 34.5 ft., From 3.0 ft. to 8.0 ft., From ..... ft. to ..... ft.  
 What is the nearest source of possible contamination:  
 1 Septic tank 4 Lateral lines 7 Pit privy 10 Livestock pens 14 Abandoned water well  
 2 Sewer lines 5 Cess pool 8 Sewage lagoon 11 Fuel storage 15 Oil well/Gas well  
 3 Watertight sewer lines 6 Seepage pit 9 Feedyard 12 Fertilizer storage 16 Other (specify below)  
 13 Insecticide storage .....  
 Direction from well? How many feet?

FROM	TO	LITHOLOGIC LOG	FROM	TO	PLUGGING INTERVALS
		See attached Geologic log			

7 CONTRACTOR'S OR LANDOWNER'S CERTIFICATION: This water well was (1) constructed, (2) reconstructed, or (3) plugged under my jurisdiction and was completed on (mo/day/year) 5/12/04 and this record is true to the best of my knowledge and belief. Kansas Water Well Contractor's Licence No 6058 This Water Well Record was completed on (mo/day/yr) 7/29/04 under the business name of Boat Longyear Env. Drilling Division by (signature) [Signature]



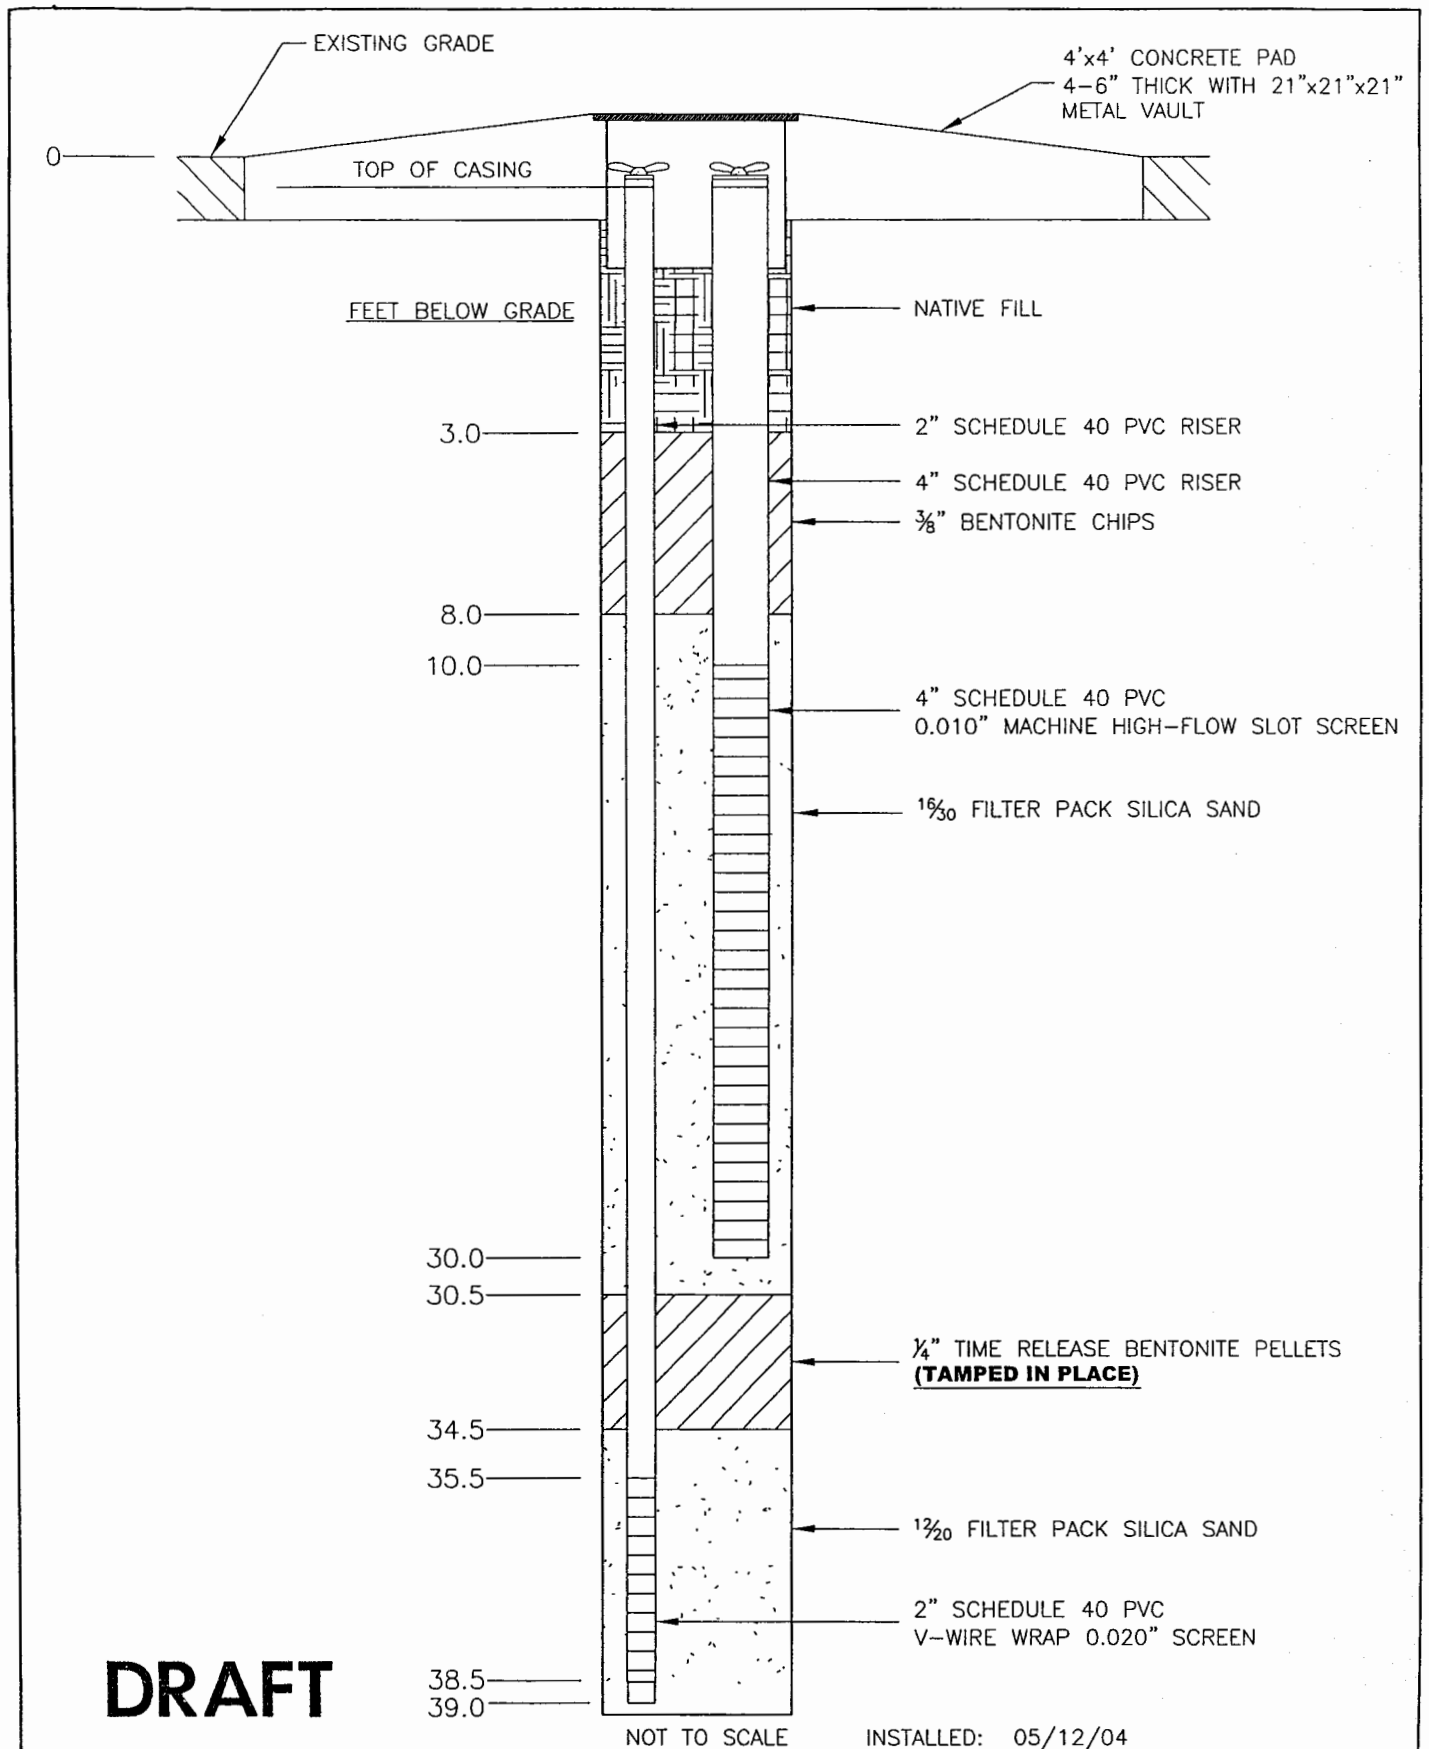

DATE	REVISED	Prepared By:	MAGELLAN PIPELINE COMPANY, LLC
		LEGGETTE, BRASHEARS & GRAHAM, INC.	KANSAS CITY TERMINAL
		Professional Ground-Water and Environmental Engineering Services	KANSAS CITY, KANSAS
		2103 Burlington Street	MPE/SVE & AS WELL 26
		North Kansas City, Missouri 64116	CONSTRUCTION DIAGRAM
		(816) 421-7766	FILE: MPE_AS 26.dwg   DATE: MAY 2004   FIGURE: 1