


1 LOCATION OF WATER WELL: Fraction nw 1/4 nw 1/4 1/4 Section Number 35 Township Number T-10 S Range Number R 25 (E)W  
 County: Wyandotte

Distance and direction from nearest town or city street address of well if located within city?  
401 E. Donovan Rd. Kansas City

2 WATER WELL OWNER: Magellan Kansas City Terminal  
 RR#, St. Address, Box #: 401 E. Donovan Rd. Board of Agriculture, Division of Water Resources  
 City, State, ZIP Code: Kansas City, KS 66115 Application Number:

3 LOCATE WELL'S LOCATION WITH AN "X" IN SECTION BOX: 39.5 DEPTH OF COMPLETED WELL ..... ft. ELEVATION: .....  
 Depth(s) Groundwater Encountered 1 ..... ft. 2 ..... ft. 3 ..... ft.  
 WELL'S STATIC WATER LEVEL ..... ft. below land surface measured on mo/day/yr .....  
 Pump test data: Well water was ..... ft. after ..... hours pumping ..... gpm  
 Est. Yield ..... gpm: Well water was ..... ft. after ..... hours pumping ..... gpm  
 WELL WATER TO BE USED AS: 5 Public water supply 8 Air conditioning 11 Injection well  
 1 Domestic 3 Feedlot 6 Oil field water supply 9 Dewatering (12) Other (Specify below) Air Sparge/Soil Vapors  
 2 Irrigation 4 Industrial 7 Domestic (lawn & garden) 10 Monitoring well Extraction Wells  
 Was a chemical/bacteriological sample submitted to Department? Yes ..... No X .....; If yes, mo/day/yrs sample was submitted  
 Water Well Disinfected? Yes ..... No — .....

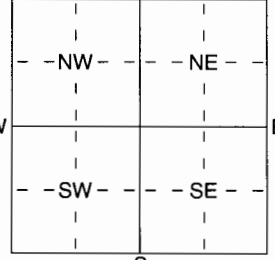


5 TYPE OF BLANK CASING USED: 5 Wrought iron 8 Concrete tile CASING JOINTS: Glued ..... Clamped .....  
 1 Steel 3 RMP (SR) 6 Asbestos-Cement 9 Other (specify below) Welded .....  
 (2) PVC 4 ABS 7 Fiberglass Threaded .....  
 Blank casing diameter ..... 2 in. to 36.0 ft., Dia 4 in. to 30.5 ft., Dia ..... in. to ..... ft.  
 Casing height above land surface ..... in., weight ..... lbs./ft. Wall thickness or gauge No. Sch. 40  
 TYPE OF SCREEN OR PERFORATION MATERIAL: (7) PVC 10 Asbestos-Cement  
 1 Steel 3 Stainless Steel 5 Fiberglass 8 RMP (SR) 11 Other (Specify) .....  
 2 Brass 4 Galvanized Steel 6 Concrete tile 9 ABS 12 None used (open hole)  
 SCREEN OR PERFORATION OPENINGS ARE: 5 Guazed wrapped 8 Saw cut 11 None (open hole)  
 (1) Continuous slot 3 Mill slot 6 Wire wrapped 9 Drilled holes  
 2 Louvered shutter 4 Key punched 7 Torch cut 10 Other (specify) ..... ft.  
 SCREEN-PERFORATED INTERVALS: From 36.0 (2") ft. to 37.0 ft., From 10.5 ft. to 30.5 ft.  
 From ..... ft. to ..... ft., From ..... ft. to ..... ft.  
 GRAVEL PACK INTERVALS: From 35.0 ft. to 39.5 ft., From 8.5 ft. to 31.0 ft.  
 From ..... ft. to ..... ft., From ..... ft. to ..... ft.

6 GROUT MATERIAL: 1 Neat cement 2 Cement grout (3) Bentonite 4 Other .....  
 Grout Intervals: From 31.0 ft. to 35.0 ft., From 3.5 ft. to 8.5 ft., From ..... ft. to ..... ft.  
 What is the nearest source of possible contamination:  
 1 Septic tank 4 Lateral lines 7 Pit privy (11) Fuel storage 14 Abandoned water well  
 2 Sewer lines 5 Cess pool 8 Sewage lagoon 12 Fertilizer storage 15 Oil well/Gas well  
 3 Watertight sewer lines 6 Seepage pit 9 Feedyard 13 Insecticide storage 16 Other (specify below) .....  
 Direction from well? ..... How many feet? .....

| FROM | TO | LITHOLOGIC LOG                   | FROM | TO | PLUGGING INTERVALS |
|------|----|----------------------------------|------|----|--------------------|
|      |    | <u>See attached Geologic Log</u> |      |    |                    |
|      |    |                                  |      |    |                    |
|      |    |                                  |      |    |                    |
7 CONTRACTOR'S OR LANDOWNER'S CERTIFICATION: This water well was (1) constructed, (2) reconstructed, or (3) plugged under my jurisdiction and was completed on (mo/day/year) 5/17/04 and this record is true to the best of my knowledge and belief. Kansas Water Well Contractor's Licence No 658 This Water Well Record was completed on (mo/day/yr) 7/29/04 under the business name of Boart Longyear Env. Drilling Division by (signature) [Signature]



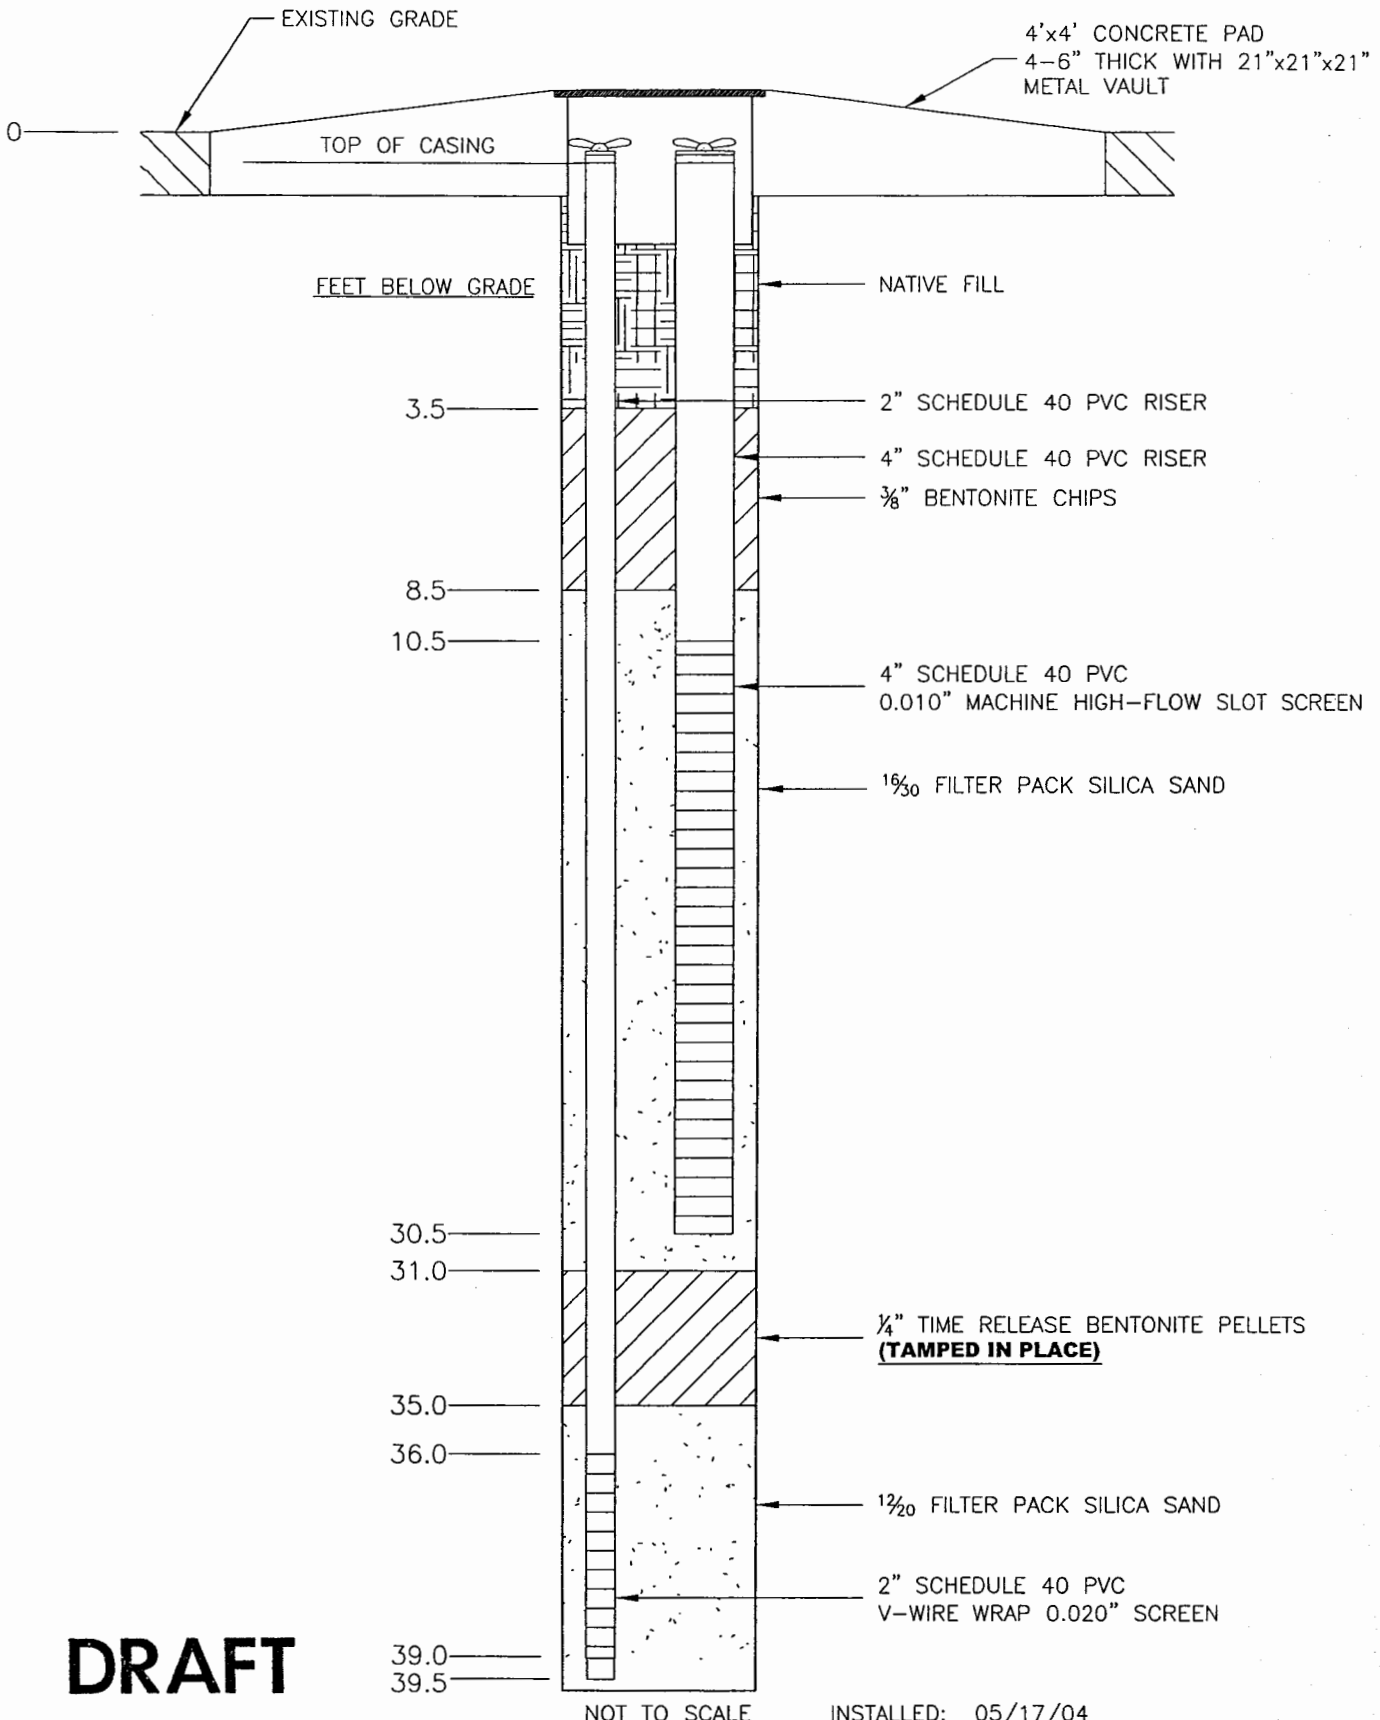

**DRAFT**

NOT TO SCALE INSTALLED: 05/17/04

| DATE | REVISED | Prepared By:   | MAGELLAN PIPELINE COMPANY, LLC               |
|------|---------|--|--|
|      |         | LEGGETTE, BRASHEARS & GRAHAM, INC.                               | KANSAS CITY TERMINAL                         |
|      |         | Professional Ground-Water and Environmental Engineering Services | KANSAS CITY, KANSAS                          |
|      |         | 2103 Burlington Street   | MPE/SVE & AS WELL 27                         |
|      |         | North Kansas City, Missouri 64116                                | CONSTRUCTION DIAGRAM                         |
|      |         | (816) 421-7768   | FILE: MPE_AS 27.dwg DATE: MAY 2004 FIGURE: 1 |