

1 LOCATION OF WATER WELL:	Fraction	Section Number	Township Number	Range Number
County: <u>Wyandotte</u>	<u>NW 1/4 NW 1/4</u>	<u>35</u>	T <u>-10</u> S	R <u>25</u> (EW)

Distance and direction from nearest town or city street address of well if located within city?
401 E. Donovan Rd, Kansas City, KS

2 WATER WELL OWNER: Magellan Kansas City Terminal

RR#, St. Address, Box # : 401 E. Donovan Rd. Board of Agriculture, Division of Water Resources
 City, State, ZIP Code : Kansas City, KS 66115 Application Number:

3 LOCATE WELL'S LOCATION WITH AN "X" IN SECTION BOX:

N			
	NW	NE	
W			E
	SW	SE	
	S		

4 DEPTH OF COMPLETED WELL 40 ft. ELEVATION: 743.09

Depth(s) Groundwater Encountered 1 ft. 2 ft. 3 ft.

WELL'S STATIC WATER LEVEL ft. below land surface measured on mo/day/yr

Pump test data: Well water was ft. after hours pumping gpm

Est. Yield gpm: Well water was ft. after hours pumping gpm

WELL WATER TO BE USED AS:

5 Public water supply	8 Air conditioning	11 Injection well
1 Domestic	3 Feedlot	6 Oil field water supply
2 Irrigation	4 Industrial	7 Domestic (lawn & garden)
		9 Dewatering
		10 Monitoring well
		(12) Other (Specify below)

Air Sparging / Soil Vapor Extraction Wells

Was a chemical/bacteriological sample submitted to Department? Yes No ; If yes, mo/day/yrs sample was submitted

Water Well Disinfected? Yes No

5 TYPE OF BLANK CASING USED:

1 Steel	3 RMP (SR)	5 Wrought iron	8 Concrete tile
(2) PVC	4 ABS	6 Asbestos-Cement	9 Other (specify below)
		7 Fiberglass	

CASING JOINTS: Glued Clamped
 Welded
 Threaded

Blank casing diameter 2 in. to 36.5 ft., Dia 4 in. to 11.0 ft., Dia in. to ft.

Casing height above land surface in., weight lbs./ft. Wall thickness or gauge No. Sch. 40

TYPE OF SCREEN OR PERFORATION MATERIAL:

1 Steel	3 Stainless Steel	5 Fiberglass	(7) PVC	10 Asbestos-Cement
2 Brass	4 Galvanized Steel	6 Concrete tile	8 RMP (SR)	11 Other (Specify)
			9 ABS	12 None used (open hole)

SCREEN OR PERFORATION OPENINGS ARE:

(1) Continuous slot	3 Mill slot	5 Gauzed wrapped	8 Saw cut	11 None (open hole)
2 Louvered shutter	4 Key punched	6 Wire wrapped	9 Drilled holes	
		7 Torch cut	10 Other (specify)	ft.

SCREEN-PERFORATED INTERVALS: From 36.5 (2") ft. to 39.5 (4") ft., From 11.0 ft. to 31.0 ft.

GRAVEL PACK INTERVALS: From 35.5 ft. to 40 ft., From 9.0 ft. to 31.5 ft.

6 GROUT MATERIAL: 1 Neat cement 2 Cement grout (3) Bentonite 4 Other

Grout Intervals: From 31.5 ft. to 35.5 ft., From 4.0 ft. to 9.0 ft., From ft. to ft.

What is the nearest source of possible contamination:


1 Septic tank	4 Lateral lines	7 Pit privy	(1) Fuel storage	15 Oil well/Gas well
2 Sewer lines	5 Cess pool	8 Sewage lagoon	12 Fertilizer storage	16 Other (specify below)
3 Watertight sewer lines	6 Seepage pit	9 Feedyard	13 Insecticide storage	
			10 Livestock pens	14 Abandoned water well

Direction from well? How many feet?

FROM	TO	LITHOLOGIC LOG	FROM	TO	PLUGGING INTERVALS
		<u>See attached Geologic Log</u>			

7 CONTRACTOR'S OR LANDOWNER'S CERTIFICATION: This water well was (1) constructed, (2) reconstructed, or (3) plugged under my jurisdiction and was completed on (mo/day/year) 5/12/04 and this record is true to the best of my knowledge and belief. Kansas Water Well Contractor's Licence No 658 This Water Well Record was completed on (mo/day/yr) 7/29/04 under the business name of Boart Longyear Env. Drilling Division by (signature)

INSTRUCTIONS: Use typewriter or ball point pen. PLEASE PRESS FIRMLY and PRINT clearly. Please fill in blanks, underline or circle the correct answers. Send top three copies to Kansas Department of Health and Environment, Bureau of Water, Geology Section, 1000 SW Jackson St., Suite 420, Topeka, Kansas 66612-1367. Telephone 785-296-5522. Send one to WATER WELL OWNER and retain one for your records. Fee of \$5.00 for each constructed well.

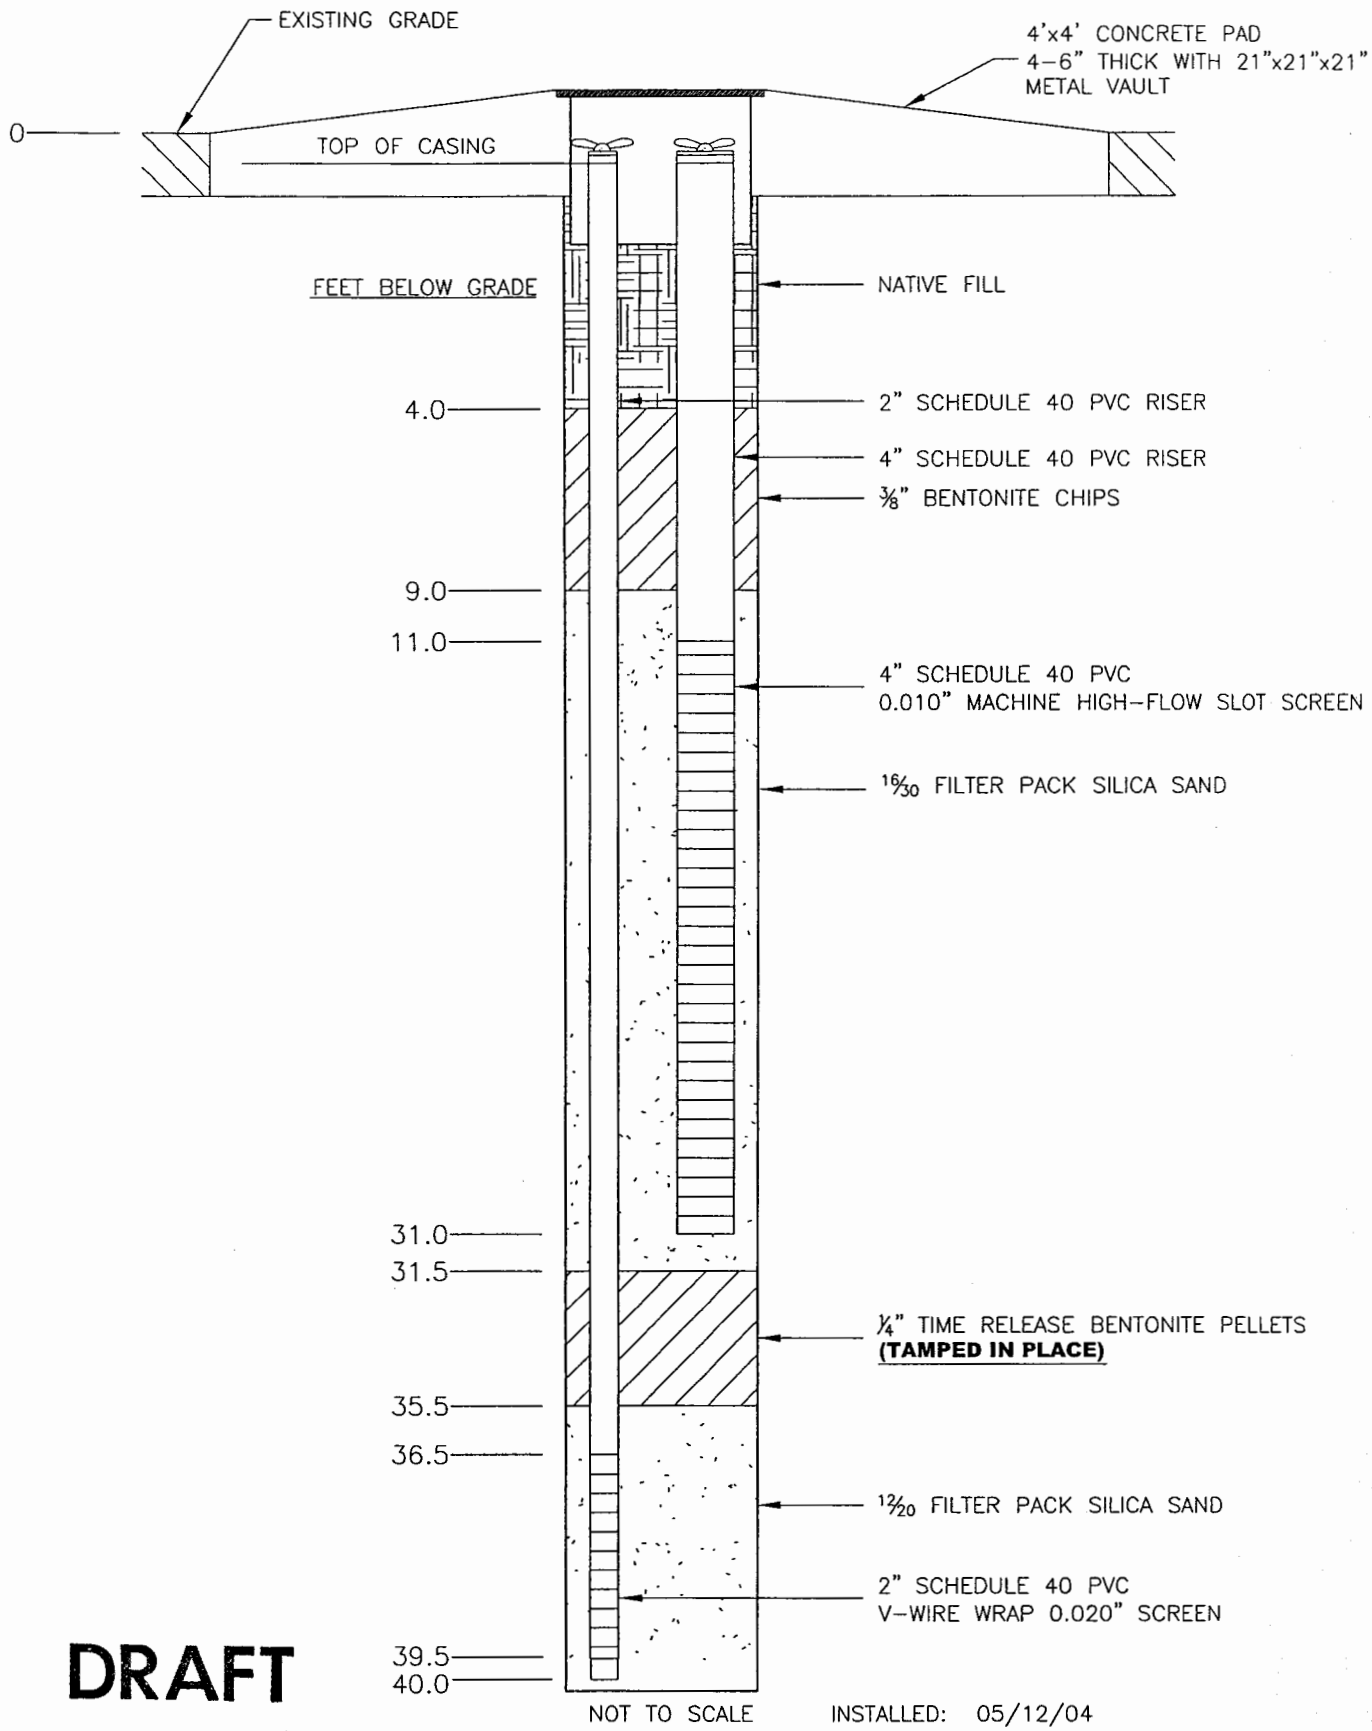

DRAFT

DATE	REVISED

Prepared By:
LEGGETTE, BRASHEARS & GRAHAM, INC.
 Professional Ground-Water and
 Environmental Engineering Services
 2103 Burlington Street
 North Kansas City, Missouri 64116
 (816) 421-7766

MAGELLAN PIPELINE COMPANY, LLC
 KANSAS CITY TERMINAL
 KANSAS CITY, KANSAS
 MPE/SVE & AS WELL 29
 CONSTRUCTION DIAGRAM