251521

WATER WELL RECORD Form WWC-5 KSA 82a-1212 ID No. _____

1 LOCATION OF WATER WELL: County: Wyandotte	Fraction: SE ¼ SE ¼ NW ¼	Section Number: 27	Township Number: T 10 S	Range Number: R 25 (E/W)

Distance and direction from nearest town or city street address of well if located within city? MW-121A

2 WATER WELL OWNER: General Motors - Fairfax
RR#, St. Address, Box #: 100 Kindleberger Road
City, State, ZIP Code: Kansas City, KS 66115

Board of Agriculture, Division of Water Resources Application Number:

3 LOCATE WELL'S LOCATION WITH AN "X" IN SECTION BOX:

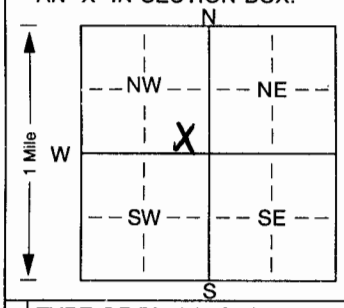

4 DEPTH OF COMPLETED WELL: 35' ft. ELEVATION: _____

Depth(s) Groundwater Encountered 1. 26' ft. 2. _____ ft. 3. _____ ft.

WELL'S STATIC WATER LEVEL NA ft. below land surface measured on mo/day/yr NA

Pump test data: Well water was NA ft. after NA hours pumping NA gpm

Est. Yield NA gpm: Well water was NA ft. after NA hours pumping NA gpm

Bore Hole Diameter 9" in. to 35' w/ 4¼" ~~ft. and in. to~~ ID HSA ~~in. to~~ ft.

WELL WATER TO BE USED AS: 5 Public water supply; 8 Air conditioning; 11 Injection well; 1 Domestic; 3 Feedlot; 6 Oil field water supply; 9 Dewatering; 12 Other (Specify below); 2 Irrigation; 4 Industrial; 7 Domestic (lawn & garden); 10 Monitoring well

Was a chemical/bacteriological sample submitted to Department? Yes. ~~No~~ NA; If yes, mo/day/yrs sample was submitted

Water Well Disinfected? Yes ~~No~~ NA

5 TYPE OF BLANK CASING USED: 5 Wrought iron; 8 Concrete tile; CASING JOINTS: Glued. Clamped.
1 Steel; 3 RMP (SR); 6 Asbestos-Cement; 9 Other (specify below); Welded
2 PVC; 4 ABS; 7 Fiberglass; Threaded

RISER

Blank ~~casing~~ diameter 2" PVC in. to 3' ABGS ~~ft., Dia~~ TO 25' BLGS ~~in. to~~ 2" PVC ft., Dia ~~in. to~~ ft.

~~Casing~~ height above land surface 3' in., ~~weight~~ 2" PVC ~~lbs./ft. Wall thickness or gauge No.~~

TYPE OF SCREEN OR PERFORATION MATERIAL: 7 PVC; 10 Asbestos-cement
1 Steel; 3 Stainless steel; 5 Fiberglass; 8 RMP (SR); 11 Other (specify)
2 Brass; 4 Galvanized steel; 6 Concrete tile; 9 ABS; 12 None used (open hole)

SCREEN OR PERFORATION OPENINGS ARE: 5 Gauzed wrapped; 8 Saw cut; 11 None (open hole)
1 Continuous slot; 3 Mill slot; 6 Wire wrapped; 9 Drilled holes
2 Louvered shutter; 4 Key punched; 7 Torch cut; 10 Other (specify) ft.

SCREEN-PERFORATED INTERVALS: From 25' ft. to 35' ft., From .010 SLOT ft. to ft.
From ft. to ft., From ft. to ft.

GRAVEL PACK INTERVALS: From 23' ft. to 35' ft., From ft. to ft.
BENT. CHIPS SEAL From 21' ft. to 23' ft., ~~From~~ ft. to ft.

6 GROUT MATERIAL: 1 Neat cement; 2 Cement grout; 3 Bentonite; 4 Other

Grout Intervals: From 2' ft. to 21' ft., From ft. to CONCRETE ft., From 0 ft. to 2' ft.

What is the nearest source of possible contamination: 10 Livestock pens; 14 Abandoned water well
1 Septic tank; 4 Lateral lines; 7 Pit privy; 11 Fuel storage; 15 Oil well/Gas well
2 Sewer lines; 5 Cess pool; 8 Sewage lagoon; 12 Fertilizer storage; 16 Other (specify below)
3 Watertight sewer lines; 6 Seepage pit; 9 Feedyard; 13 Insecticide storage

Direction from well? How many feet?

FROM	TO	LITHOLOGIC LOG	FROM	TO	PLUGGING INTERVALS
0	2'	CRUSHED STONE + FILL			
2	10'	BR. CLAY w/ FI. SAND			
10'	35'	BR. + GRAY FI. + MED SAND			NA
		TD @ 35'			

7 CONTRACTOR'S OR LANDOWNER'S CERTIFICATION: This water well was (1) constructed, (2) reconstructed, or (3) plugged under my jurisdiction and was completed on (mo/day/year) 12-22-05 and this record is true to the best of my knowledge and belief. Kansas Water Well Contractor's Licence No. 637 This Water Well Record was completed on (mo/day/yr) 2/9/06 under the business name of Harriss Drilling Services, Inc. by (signature) Cecil A. Harris

INSTRUCTIONS: Use typewriter or ball point pen. *PLEASE PRESS FIRMLY and PRINT* clearly. Please fill in blanks, underline or circle the correct answers. Send top three copies to Kansas Department of Health and Environment, Bureau of Water, Topeka, Kansas 66620-0001. Telephone 785-296-5524. Send one to WATER WELL OWNER and retain one for your records. Fee of $5.00 for each constructed well.