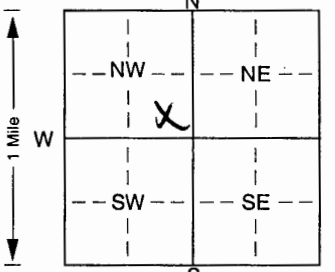


1 LOCATION OF WATER WELL: Fraction SE 1/4 SE 1/4 NW 1/4 Section Number 27 Township Number T 10 S Range Number R 25 E  
 County: Wyandotte Distance and direction from nearest town or city street address of well if located within city? MW-121B

2 WATER WELL OWNER: General Motors - Fairfax  
 RR#, St. Address, Box #: 100 Kindleberger Road Board of Agriculture, Division of Water Resources  
 City, State, ZIP Code: Kansas City, KS 66115 Application Number:

3 LOCATE WELL'S LOCATION WITH AN "X" IN SECTION BOX:  4 DEPTH OF COMPLETED WELL: 60 ft. ELEVATION: \_\_\_\_\_  
 Depth(s) Groundwater Encountered 1. 26' ft. 2. \_\_\_\_\_ ft. 3. \_\_\_\_\_ ft.  
 WELL'S STATIC WATER LEVEL: NA ft. below land surface measured on mo/day/yr NA  
 Pump test data: Well water was \_\_\_\_\_ ft. after \_\_\_\_\_ hours pumping \_\_\_\_\_ gpm  
 Est. Yield: NA gpm; Well water was \_\_\_\_\_ ft. after \_\_\_\_\_ hours pumping \_\_\_\_\_ gpm  
 Bore Hole Diameter: 9 1/4" ID to 4 1/4" ID HSA in. to \_\_\_\_\_ in.  
 WELL WATER TO BE USED AS:  
 5 Public water supply 8 Air conditioning 11 Injection well  
 1 Domestic 3 Feedlot 6 Oil field water supply 9 Dewatering 12 Other (Specify below)  
 2 Irrigation 4 Industrial 7 Domestic (lawn & garden) 10 Monitoring well  
 Was a chemical/bacteriological sample submitted to Department? Yes NA; If yes, mo/day/yr sample was submitted  
 Water Well Disinfected? Yes NA

5 TYPE OF BLANK CASING USED:  
 1 Steel 3 RMP (SR) 5 Wrought iron 8 Concrete tile CASING JOINTS: Glued \_\_\_\_\_ Clamped \_\_\_\_\_  
 2 PVC RISER 4 ABS 6 Asbestos-Cement 9 Other (specify below) Welded \_\_\_\_\_  
 Blank casing diameter: 2" PVC in. to 3.2" ABS TO 48.5" ABS in. to 2" PVC in. to \_\_\_\_\_ in.  
 Casing height above land surface: 3.2' in. weight 2" PVC lbs./ft. Wall thickness or gauge No. \_\_\_\_\_  
 TYPE OF SCREEN OR PERFORATION MATERIAL:  
 1 Steel 3 Stainless steel 5 Fiberglass 7 PVC 10 Asbestos-cement  
 2 Brass 4 Galvanized steel 6 Concrete tile 8 RMP (SR) 11 Other (specify) \_\_\_\_\_  
 9 ABS 12 None used (open hole)  
 SCREEN OR PERFORATION OPENINGS ARE:  
 1 Continuous slot 3 Mill slot 5 Gauzed wrapped 8 Saw cut 11 None (open hole)  
 2 Louvered shutter 4 Key punched 6 Wire wrapped 9 Drilled holes  
 7 Torch cut 10 Other (specify) \_\_\_\_\_ ft.  
 SCREEN-PERFORATED INTERVALS: From 48.5' ft. to 58.5' ft. From 1010 SLOT ft. to \_\_\_\_\_ ft.  
 GRAVEL PACK INTERVALS: From 46.5' ft. to 60' ft. From \_\_\_\_\_ ft. to \_\_\_\_\_ ft.  
DENT CHIP SEAL From 44.5' ft. to 46.5' ft. From \_\_\_\_\_ ft. to \_\_\_\_\_ ft.

6 GROUT MATERIAL: 1 Neat cement 2 Cement grout 3 Bentonite 4 Other \_\_\_\_\_  
 Grout Intervals: From 2' ft. to 44.5' ft. From \_\_\_\_\_ ft. to CONCRETE ft. From 0 ft. to 2' ft.  
 What is the nearest source of possible contamination:  
 1 Septic tank 4 Lateral lines 7 Pit privy 10 Livestock pens 14 Abandoned water well  
 2 Sewer lines 5 Cess pool 8 Sewage lagoon 11 Fuel storage 15 Oil well/Gas well  
 3 Watertight sewer lines 6 Seepage pit 9 Feedyard 12 Fertilizer storage 16 Other (specify below)  
 13 Insecticide storage \_\_\_\_\_  
 Direction from well? \_\_\_\_\_ How many feet? \_\_\_\_\_

FROM	TO	LITHOLOGIC LOG	FROM	TO	PLUGGING INTERVALS
0	2'	<del>CRUSHED STONE</del> CRUSHED STONE + FILL			
2'	10'	BR. CLAY w/ FI SAND			
10'	45'	BR. + GRAY FI TO MED SAND			
45	60'	BR. + GRAY FI TO COARSE SAND			
<u>TOP @ 60'</u>					

7 CONTRACTOR'S OR LANDOWNER'S CERTIFICATION: This water well was (1) constructed, (2) reconstructed, or (3) plugged under my jurisdiction and was completed on (mo/day/year) 12-21-05 and this record is true to the best of my knowledge and belief. Kansas Water Well Contractor's Licence No. 637 This Water Well Record was completed on (mo/day/yr) 2/9/06 under the business name of Harriss Drilling Services, Inc. by (signature) Cecil D. Harriss