

WATER WELL RECORD

Form WWC-5

Division of Water Resources; App. No.


128



**1 LOCATION OF WATER WELL:** Fraction NE 1/4 NW 1/4 NE 1/4 Section Number 27 Township Number T 10 S Range Number R 25 E  
 County: Wyandotte  
 Distance and direction from nearest town or city street address of well if located within city? \_\_\_\_\_

**Global Positioning Systems** (decimal degrees, min. of 4 digits)  
 Latitude: 39 09 217  
 Longitude: 094 36 589  
 Elevation: 731  
 Datum: \_\_\_\_\_  
 Data Collection Method: GPS

**2 WATER WELL OWNER:** GM Corp. Fairfax Plant  
 RR#, St. Address, Box # : 100 Kindelberger Rd.  
 City, State, ZIP Code : Kansas City, KS.

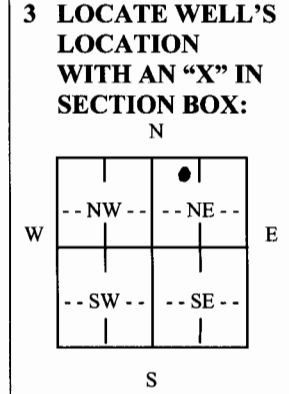

**4 DEPTH OF COMPLETED WELL** 35' ft.  
 Depth(s) Groundwater Encountered (1)..... ft. (2)..... ft. (3)..... ft.  
 WELL'S STATIC WATER LEVEL 28.70 ft. below land surface measured on mo/day/yr. 11/30/06  
 Pump test data: Well water was.....ft. after..... hours pumping..... gpm  
 Est. Yield.....gpm: Well water was.....ft. after..... hours pumping..... gpm  
 WELL WATER TO BE USED AS: 5 Public water supply 8 Air conditioning 11 Injection well  
 1 Domestic 3 Feedlot 6 Oil field water supply 9 Dewatering 12 Other (Specify below)  
 2 Irrigation 4 Industrial 7 Domestic (lawn & garden) 10 Monitoring well  
 Was a chemical/bacteriological sample submitted to Department? Yes..... No X If yes, mo/day/yr  
 Sample was submitted..... Water well disinfected? Yes..... No X

**5 TYPE OF CASING USED:** 5 Wrought Iron 8 Concrete tile CASING JOINTS: Glued..... Clamped.....  
 1 Steel 3 RMP (SR) 6 Asbestos-Cement 9 Other (specify below) Welded.....  
2 PVC 4 ABS 7 Fiberglass Threaded X  
 Blank casing diameter 2.0" in. to 2.5 ft., Diameter..... in. to..... ft., Diameter..... in. to..... ft.  
 Casing height above land surface 2.76 in., weight..... lbs./ft. Wall thickness or guage No. Sch 4.0

**TYPE OF SCREEN OR PERFORATION MATERIAL:**  
 1 Steel 3 Stainless Steel 5 Fiberglass 7 PVC 9 ABS 11 Other (Specify).....  
 2 Brass 4 Galvanized Steel 6 Concrete tile 8 RM (SR) 10 Asbestos-Cement 12 None used (open hole)  
**SCREEN OR PERFORATION OPENINGS ARE:**  
 1 Continuous slot 3 Mill slot 5. Guazed wrapped 7 Torch cut 9 Drilled holes 11 None (open hole)  
 2 Louvered shutter 4 Key punched 6 Wire wrapped 8 Saw Gut 10 Other (specify).....  
**SCREEN-PERFORATED INTERVALS:** From 35' ft. to 25' ft., From..... ft. to..... ft.  
 From..... ft. to..... ft., From..... ft. to..... ft.  
**GRAVEL PACK INTERVALS:** From 35' ft. to 23' ft., From..... ft. to..... ft.  
 From..... ft. to..... ft., From..... ft. to..... ft.

**6 GROUT MATERIAL:** 1 Neat cement 2 Cement grout 3 Bentonite 4 Other.....  
 Grout Intervals: From 23' ft. to 0' ft., From..... ft. to..... ft., From..... ft. to..... ft.  
 What is the nearest source of possible contamination:  
 1 Septic tank 4 Lateral lines 7 Pit privy 10 Livestock pens 13 Insecticide Storage 16 Other (specify below)  
 2 Sewer lines 5 Cess pool 8 Sewage lagoon 11 Fuel storage 14 Abandoned water well  
 3 Watertight sewer lines 6 Seepage pit 9 Feedyard 12 Fertilizer Storage 15 Oil wll/gas well  
 Direction from well?..... How many feet?.....  
FARMER GM PLANT

FROM	TO	LITHOLOGIC LOG	FROM	TO	PLUGGING INTERVALS
0	4	Brn silty clay w/root frag. moist, soft, no odor.			
4	12	Brn silty sandy clay, moist, friable, no odor.			
12	27	Brn-lt brn sand, fine-coarse grained, moist, no odor.			
27	35	Lt pale gray fine-coarse sand, wet, no odor.			

**7 CONTRACTOR'S OR LANDOWNER'S CERTIFICATION:** This water well was (1) constructed, (2) reconstructed, or (3) plugged under my jurisdiction and was completed on (mo/day/year)..... and this record is true to the best of my knowledge and belief.  
 Kansas Water Well Contractor's License No. 732 This Water Well Recorded was completed on (mo/day/year) 11/27/06  
 Under the business name of JB Environmental by (signature) James Beebe

INSTRUCTIONS: Use typewriter or ball point pen. PLEASE PRESS FIRMLY and PRINT clearly. Please fill in blanks, underline or circle the correct answers. Send top three copies to Kansas Department of Health and Environment, Bureau of Water, Geology Section, 1000 SW Jackson St., Suite 420, Topeka, Kansas 66612-1367. Telephone 785-296-5522. Send one to WATER WELL OWNER and retain one for your records. Fee of \$5.00 for each constructed well.