


1 LOCATION OF WATER WELL: Fraction NE 1/4 SW 1/4 NE 1/4 Section Number 27 Township Number 10 Range Number 25 (EW)
 County: **Wyandotte**

Distance and direction from nearest town or city street address of well if located within city? (131)

2 WATER WELL OWNER: **GM Corp. Fairfax Plant**
 RR #, St. Address, Box #: **100 Kindelberger Rd.**
 City, State, ZIP Code : **Kansas City, KS.** Board of Agriculture, Division of Water Resources
 Application Number: _____

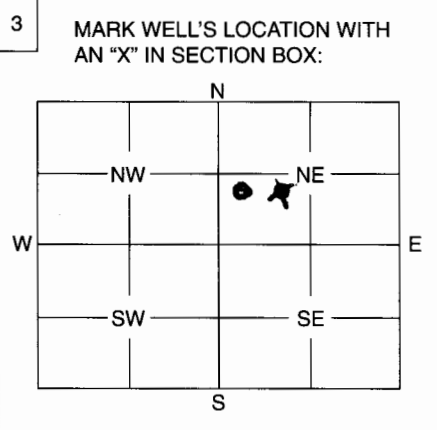

4 DEPTH OF WELL 35' ft.
 WELL'S STATIC WATER LEVEL 27.78 ft.
 WELL WAS USED AS:
 1 Domestic 5 Public Water Supply 9 Dewatering
 2 Irrigation 6 Oil Field Water Supply 10 Monitoring Well
 3 Feedlot 7 Domestic (Lawn & Garden) 11 Injection Well
 4 Industrial 8 Air Conditioning 12 Other _____
 Was a chemical / bacteriological sample submitted to Department? Yes _____ No X
 If yes, mo/day/yr sample was submitted _____
 Water Well Disinfected: Yes _____ No X

5 TYPE OF BLANK CASING USED:
 1 Steel 3 RMP (SR) 5 Wrought 7 Fiberglass 9 Other (Specify below)
2 PVC 4 ABS 6 Asbestos-Cement 8 Concrete Tile _____
 Blank casing diameter 2" in. Was casing pulled? Yes X No _____ If yes, how much 7'
 Casing height above or below land surface 5ft in.

6 GROUT PLUG MATERIAL: 1 Neat cement 2 Cement grout 3 Bentonite 4 Other Cement
 Grout Plug Intervals: From 35' ft. to 2' ft., From 2' ft. to 0' ft., From _____ to _____ ft.
 What is the nearest source of possible contamination:
 1 Septic tank 6 Seepage pit 11 Fuel storage 16 Other (specify below)
 2 Sewer lines 7 Pit privy 12 Fertilizer storage Former GM plant
 3 Watertight sewer lines 8 Sewage lagoon 13 Insecticide storage
 4 Lateral lines 9 Feedyard 14 Abandoned water well
 5 Cess pool 10 Livestock pens 15 Oil well/Gas well
 Direction from well? _____ How many feet? _____

FROM	TO	PLUGGING MATERIALS
		Bentonite from: 35'-2'
		Cement from: 2' 0'

Above ground well protector removed. 2" well

7 CONTRACTOR'S OF LANDOWNER'S CERTIFICATION: This water well was plugged under my jurisdiction and was completed on (mo/day/year) 3/26/07 732 and this record is true to the best of my knowledge and belief. Kansas Water Well Contractor's License No. _____ This Water Well Record was completed on (mo/day/year) _____ under the business name of JB Environmental by (signature) James Becker

INSTRUCTIONS: Use typewriter or ball point pen. Please press firmly and print clearly. Please fill in blanks, underline or circle the correct answers. Send top three copies to Kansas Department of Health and Environment, Bureau of Water, Geology Section, 1000 SW Jackson St., Ste. 420, Topeka, Kansas 66612-1367. Telephone: 785/296-5522. Send one to Water Well Owner and retain one for your records.