


1 LOCATION OF WATER WELL: Fraction NW 1/4 SE 1/4 NW 1/4 Section Number 27 Township Number 10 Range Number 25 E/W

County: **Wyandotte**

Distance and direction from nearest town or city street address of well if located within city? 133

2 WATER WELL OWNER: **GM Corp. Fairfax Plant**
 RR #, St. Address, Box #: **100 Kindelberger Rd.**
 City, State, ZIP Code: **Kansas City, KS.**

Board of Agriculture, Division of Water Resources
 Application Number: _____

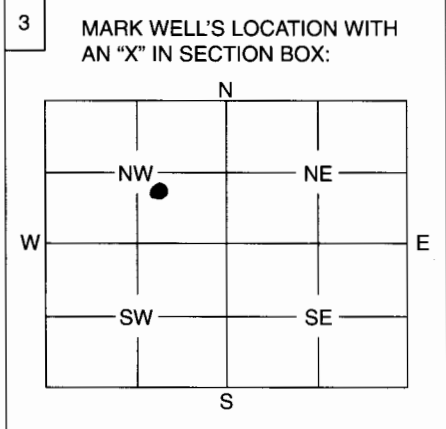

4 DEPTH OF WELL 35' ft.
 WELL'S STATIC WATER LEVEL 29.75 ft.

WELL WAS USED AS:

1 Domestic	5 Public Water Supply	9 Dewatering
2 Irrigation	6 Oil Field Water Supply	10 Monitoring Well
3 Feedlot	7 Domestic (Lawn & Garden)	11 Injection Well
4 Industrial	8 Air Conditioning	12 Other

Was a chemical / bacteriological sample submitted to Department? Yes No

If yes, mo/day/yr sample was submitted

Water Well Disinfected: Yes No

5 TYPE OF BLANK CASING USED:

<input checked="" type="checkbox"/> 1 Steel	3 RMP (SR)	5 Wrought	7 Fiberglass	9 Other (Specify below)
<input checked="" type="checkbox"/> 2 PVC	4 ABS	6 Asbestos-Cement	8 Concrete Tile	

Blank casing diameter 2" in. Was casing pulled? Yes No If yes, how much 7 ft

Casing height above or below land surface 5 ft in.

6 GROUT PLUG MATERIAL: 1 Neat cement 2 Cement grout 3 Bentonite 4 Other cement

Grout Plug Intervals: From 35' to 2' ft., From 2' ft. to 0' ft., From to ft.

What is the nearest source of possible contamination:

1 Septic tank	6 Seepage pit	11 Fuel storage
2 Sewer lines	7 Pit privy	12 Fertilizer storage
3 Watertight sewer lines	8 Sewage lagoon	13 Insecticide storage
4 Lateral lines	9 Feedyard	14 Abandoned water well
5 Cess pool	10 Livestock pens	15 Oil well/Gas well

16 Other (specify below) FOUR GM plant

Direction from well? How many feet?

FROM	TO	PLUGGING MATERIALS
		Bentonite from: 35'-2'
		Cement from: 2'-0'

Above ground well protector removed. 2" well

7 CONTRACTOR'S OF LANDOWNER'S CERTIFICATION: This water well was plugged under my jurisdiction and was completed on (mo/day/year) 3/26/07 and this record is true to the best of my knowledge and belief. Kansas Water Well Contractor's License No. 732 This Water Well Record was completed on (mo/day/year) under the business name of JB Environmental by (signature) James Becker

INSTRUCTIONS: Use typewriter or ball point pen. Please press firmly and print clearly. Please fill in blanks, underline or circle the correct answers. Send top three copies to Kansas Department of Health and Environment, Bureau of Water, Geology Section, 1000 SW Jackson St., Ste. 420, Topeka, Kansas 66612-1367. Telephone: 785/296-5522. Send one to Water Well Owner and retain one for your records.