


1 LOCATION OF WATER WELL: Fraction Section Number Township Number Range Number
 County: **Wyandotte** *SE 1/4 SE 1/4 DW 1/4* **27** **10** **25** **(E)**

Distance and direction from nearest town or city street address of well if located within city? **136**

2 WATER WELL OWNER: **GM Corp. Fairfax Plant**
 RR #, St. Address, Box #: **100 Kindelberger Rd.** Board of Agriculture, Division of Water Resources
 City, State, ZIP Code : **Kansas City, KS.** Application Number:

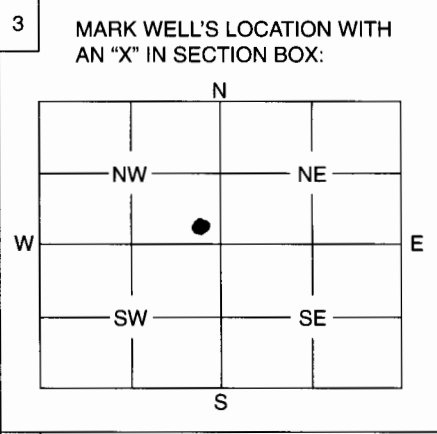

4 DEPTH OF WELL **35'** ft.
 WELL'S STATIC WATER LEVEL **29.15** ft.
 WELL WAS USED AS:
 1 Domestic 5 Public Water Supply 9 Dewatering
 2 Irrigation 6 Oil Field Water Supply 10 **(Monitoring Well)**
 3 Feedlot 7 Domestic (Lawn & Garden) 11 Injection Well
 4 Industrial 8 Air Conditioning 12 Other

Was a chemical / bacteriological sample submitted to Department? Yes No **(X)**
 If yes, mo/day/yr sample was submitted

Water Well Disinfected: Yes No **(X)**

5 TYPE OF BLANK CASING USED:
 1 Steel 3 RMP (SR) 5 Wrought 7 Fiberglass 9 Other (Specify below)
(2 PVC) 4 ABS 6 Asbestos-Cement 8 Concrete Tile

Blank casing diameter **2"** in. Was casing pulled? Yes **(X)** No If yes, how much **7ft**
 Casing height above or below land surface **5ft** in.

6 GROUT PLUG MATERIAL: 1 Neat cement 2 Cement grout **(3) Bentonite** **(4) Other Cement**
 Grout Plug Intervals: From **35'** ft. to **2'** ft., From **2'** ft. to **0'** ft., From to ft.

What is the nearest source of possible contamination:
 1 Septic tank 6 Seepage pit 11 Fuel storage **(16) Other (specify below)**
 2 Sewer lines 7 Pit privy 12 Fertilizer storage **(Farmer GM plant)**
 3 Watertight sewer lines 8 Sewage lagoon 13 Insecticide storage
 4 Lateral lines 9 Feedyard 14 Abandoned water well
 5 Cess pool 10 Livestock pens 15 Oil well/Gas well

Direction from well? How many feet?

FROM	TO	PLUGGING MATERIALS
		Bentonite from: 35' - 2'
		Cement from: 2' - 0'

Above ground well protector removed. 2" well

7 CONTRACTOR'S OF LANDOWNER'S CERTIFICATION: This water well was plugged under my jurisdiction and was completed on (mo/day/year) **3/26/07** and this record is true to the best of my knowledge and belief. Kansas Water Well Contractor's License No. **732**. This Water Well Record was completed on (mo/day/year) under the business name of **JB Environmental** by (signature) **James Beeber**

INSTRUCTIONS: Use typewriter or ball point pen. Please press firmly and print clearly. Please fill in blanks, underline or circle the correct answers. Send top three copies to Kansas Department of Health and Environment, Bureau of Water, Geology Section, 1000 SW Jackson St., Ste. 420, Topeka, Kansas 66612-1367. Telephone: 785/296-5522. Send one to Water Well Owner and retain one for your records.