

CORRECTION(S) TO WATER WELL RECORD (WWC-5)

(to rectify lacking or incorrect information)

County: Wyandotte

Location listed as:

Location changed to:

Section-Township-Range: 34-105-25E

34-105-25E

Fraction (  $\frac{1}{4}$   $\frac{1}{4}$   $\frac{1}{4}$ ): SE SE NE

W2 E2 E2 SE

Other changes: Initial statements: \_\_\_\_\_

Changed to: \_\_\_\_\_

Comments: \_\_\_\_\_

verification method: Map from owner showing well locations,  
and North Kansas City 1:24,000 topo. map.

initials: DRJ date: 12/18/2007


submitted by: Kansas Geological Survey, Data Resources Library, 1930 Constant Ave., Lawrence, KS 66047-3726  
to: Kansas Dept of Health & Environment, Bureau of Water, 1000 SW Jackson, Suite 420, Topeka, KS 66612-1367.

**1 LOCATION OF WATER WELL:** County: Wyandotte Fraction: SE 1/4 SE 1/4 NE 1/4 Section Number: 34 Township Number: T10S Range Number: R250W

Distance and direction from nearest town or city street address of well if located within city?  
Fairfax

**2 WATER WELL OWNER:** Conoco Phillips  
RR#, St. Address, Box #: 2029 Fairfax Trafficway  
City, State ZIP Code: KCKS 66115

**Global Positioning Systems** (decimal degrees, min. of 4 digits)  
Latitude: \_\_\_\_\_  
Longitude: \_\_\_\_\_  
Elevation: \_\_\_\_\_  
Datum: \_\_\_\_\_  
Data Collection Method: \_\_\_\_\_

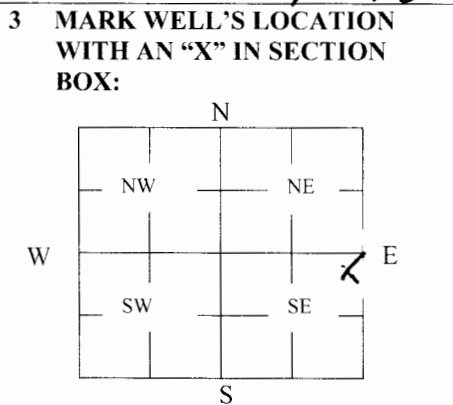

**4 DEPTH OF WELL** 36.67 ft.  
WELL'S STATIC WATER LEVEL 23.78 ft. P2443

WELL WAS USED AS:

1 Domestic	5 Public Water Supply	9 Dewatering
2 Irrigation	6 Oil Field Water Supply	10 Monitoring
3 Feedlot	7 Domestic (Lawn & Garden)	11 Injection Well
4 Industrial	8 Air Conditioning	<input checked="" type="checkbox"/> Other <u>Piezometer</u>

Was a chemical/bacteriological sample submitted to Department? Yes \_\_\_\_\_ No \_\_\_\_\_

**5 TYPE OF BLANK CASING USED:**

1 Steel	3 RMP (SR)	5 Wrought	7 Fiberglass	9 Other (Specify below)
<input checked="" type="checkbox"/> PVC	4 ABS	6 Asbestos-Cement	8 Concrete Tile	

Blank casing diameter 2 in. Was casing pulled? Yes  No \_\_\_\_\_ If yes, how much 36.67  
Casing height above or below land surface 24 in.

**6 GROUT PLUG MATERIAL:** 1 Neat cement 2 Cement grout  Bentonite 4 Other \_\_\_\_\_

Grout Plug Intervals: From 36.67 ft. to 1 ft., From \_\_\_\_\_ ft. to \_\_\_\_\_ ft., From \_\_\_\_\_ to \_\_\_\_\_ ft.

What is the nearest source of possible contamination:

1 Septic tank	6 Seepage pit	11 Fuel Storage	16 Other (specify below)
2 Sewer lines	7 Pit privy	12 Fertilizer storage	
3 Watertight sewer lines	8 Sewage lagoon	13 Insecticide storage	
4 Lateral lines	9 Feedyard	14 Abandoned water well	Direction from well? _____
5 Cess pool	10 Livestock pens	15 Oil well/Gas well	How many feet? _____

FROM	TO	PLUGGING MATERIALS	FROM	TO	PLUGGING MATERIALS
<u>36.67</u>	<u>1</u>	<u>Bentonite</u>			

**7 CONTRACTOR'S OR LANDOWNER'S CERTIFICATION:** This water well was plugged under my jurisdiction and was completed on (mo/day/year) 9/27/07 and this record is true to the best of my knowledge and belief. Kansas Water Well Contractor's License No. 204. This Water Well Record was completed on (mo/day/year) 11-18-07 under the business name of MAXS by (signature) David Smith

**INSTRUCTIONS:** Use typewriter or ballpoint pen. Please press firmly and print clearly. Please fill in blanks, underline or circle the correct answers. Send top three copies to Kansas Department of Health and Environment, Bureau of Water, Geology Section, 1000 SW Jackson St., Ste. 420, Topeka, Kansas 66612-1367. Telephone: 785/296-5522. Send one to Water Well Owner and retain one for your records. Visit us at <http://www.kdheks.gov/geo/waterwells>.