

CORRECTION(S) TO WATER WELL RECORD (WWC-5)

(to rectify lacking or incorrect information)

County: Wyandotte

Location listed as:

Location changed to:

Section-Township-Range: 15-50N-33W

35-10S-25E

Fraction (  $\frac{1}{4}$   $\frac{1}{4}$   $\frac{1}{4}$ ): SW SE SW

NE SE NW

Other changes: Initial statements: \_\_\_\_\_

Changed to: \_\_\_\_\_

Comments: \_\_\_\_\_

verification method: Location of original constructed well,  
and ~~the~~ North Kansas City 1:24,000 topo map.

initials: ARL date: 12/18/2007

**1 LOCATION OF WATER WELL:** County: Wyandotte Fraction SW<sub>4</sub> SE<sub>1/4</sub> SW<sub>1/4</sub> Section Number 15 Township Number T50N Range Number R33 E<sup>W</sup>


Distance and direction from nearest town or city street address of well if located within city?

fairfax

**2 WATER WELL OWNER:** Lonolo Phillips  
 RR#, St. Address, Box #: 2029 Fairfax Northway  
 City, State ZIP Code: KCKS 66115

**Global Positioning Systems** (decimal degrees, min. of 4 digits)  
 Latitude: \_\_\_\_\_  
 Longitude: \_\_\_\_\_  
 Elevation: \_\_\_\_\_  
 Datum: \_\_\_\_\_  
 Data Collection Method: \_\_\_\_\_

**3 MARK WELL'S LOCATION WITH AN "X" IN SECTION BOX:**

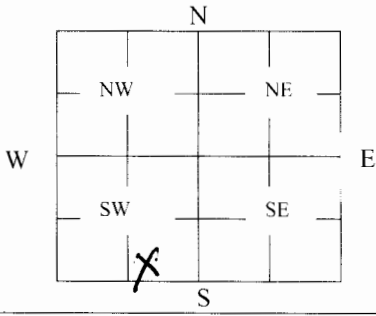

**4 DEPTH OF WELL** 25.72 ft. MW 3

WELL'S STATIC WATER LEVEL 24.97 ft.

WELL WAS USED AS:

- |              |                            |                   |
|--------------|----------------------------|-------------------|
| 1 Domestic   | 5 Public Water Supply      | 9 Dewatering      |
| 2 Irrigation | 6 Oil Field Water Supply   | 10 Monitoring     |
| 3 Feedlot    | 7 Domestic (Lawn & Garden) | 11 Injection Well |
| 4 Industrial | 8 Air Conditioning         | 12 Other _____    |

Was a chemical/bacteriological sample submitted to Department? Yes \_\_\_\_\_ No X

**5 TYPE OF BLANK CASING USED:**

- |              |            |                   |                 |                         |
|--------------|------------|-------------------|-----------------|-------------------------|
| 1 Steel      | 3 RMP (SR) | 5 Wrought         | 7 Fiberglass    | 9 Other (Specify below) |
| <u>2</u> PVC | 4 ABS      | 6 Asbestos-Cement | 8 Concrete Tile |                         |

Blank casing diameter 2 in. Was casing pulled? Yes X No \_\_\_\_\_ If yes, how much 6'5  
 Casing height above or below land surface 29 in.

**6 GROUT PLUG MATERIAL:** 1 Neat cement    2 Cement grout    3 Bentonite    4 Other \_\_\_\_\_

Grout Plug Intervals: From 25.72 to 1 ft., From \_\_\_\_\_ ft. to \_\_\_\_\_ ft., From \_\_\_\_\_ to \_\_\_\_\_ ft.

What is the nearest source of possible contamination:

- |                          |                   |                         |                            |
|--------------------------|-------------------|-------------------------|----------------------------|
| 1 Septic tank            | 6 Seepage pit     | <u>10</u> Fuel Storage  | 16 Other (specify below)   |
| 2 Sewer lines            | 7 Pit privy       | 12 Fertilizer storage   |                            |
| 3 Watertight sewer lines | 8 Sewage lagoon   | 13 Insecticide storage  |                            |
| 4 Lateral lines          | 9 Feedyard        | 14 Abandoned water well | Direction from well? _____ |
| 5 Cess pool              | 10 Livestock pens | 15 Oil well/Gas well    | How many feet? _____       |

FROM	TO	PLUGGING MATERIALS	FROM	TO	PLUGGING MATERIALS
<u>25.72</u>	<u>1</u>	<u>Neat Cement</u>			

**7 CONTRACTOR'S OR LANDOWNER'S CERTIFICATION:** This water well was plugged under my jurisdiction and was completed on (mo/day/year) 9/26/07 and this record is true to the best of my knowledge and belief. Kansas Water Well Contractor's License No. 704. This Water Well Record was completed on (mo/day/year) 11-19-07 under the business name of MAXS by (signature) David Heryto

**INSTRUCTIONS:** Use typewriter or ballpoint pen. Please press firmly and print clearly. Please fill in blanks, underline or circle the correct answers. Send top three copies to Kansas Department of Health and Environment, Bureau of Water, Geology Section, 1000 SW Jackson St., Ste. 420, Topeka, Kansas 66612-1367. Telephone: 785/296-5522. Send one to Water Well Owner and retain one for your records. Visit us at <http://www.kdheks.gov/geo/waterwells>.