

**CORRECTION(S) TO WATER WELL RECORD (WWC-5)**

(to rectify lacking or incorrect information)

County: Wyandotte

**Location listed as:**

**Location changed to:**

Section-Township-Range: 22-50 N-33 W

35-105-25 E

Fraction (  $\frac{1}{4}$   $\frac{1}{4}$   $\frac{1}{4}$ ): NW NW NW

NW SW SW NW

**Other changes:** Initial statements: \_\_\_\_\_

Changed to: \_\_\_\_\_

Comments: \_\_\_\_\_

verification method: Projection of legal description (Missouri system)  
onto Kansas survey system, and North Kansas City  
1:24,000 topo. map. initials: DRB date: 4/28/2003

submitted by: Kansas Geological Survey, Data Resources Library, 1930 Constant Ave., Lawrence, KS 66047-3726  
to: Kansas Dept of Health & Environment, Bureau of Water, 1000 SW Jackson, Suite 420, Topeka, KS 66612-1367.


1 LOCATION OF WATER WELL: County: Wyandotte Fraction: NW 1/4 NW 1/4 NW 1/4 Section Number: 22 Township Number: T50N Range Number: R33 E/W: (E)

Distance and direction from nearest town or city street address of well if located within city?

fairfax

2 WATER WELL OWNER: Conoco Phillips  
 RR#, St. Address, Box #: 2029 Fairfax Trafficway  
 City, State ZIP Code: KCKS 66115  
 Global Positioning Systems (decimal degrees, min. of 4 digits)  
 Latitude: \_\_\_\_\_  
 Longitude: \_\_\_\_\_  
 Elevation: \_\_\_\_\_  
 Datum: \_\_\_\_\_  
 Data Collection Method: \_\_\_\_\_

3 MARK WELL'S LOCATION WITH AN "X" IN SECTION BOX:

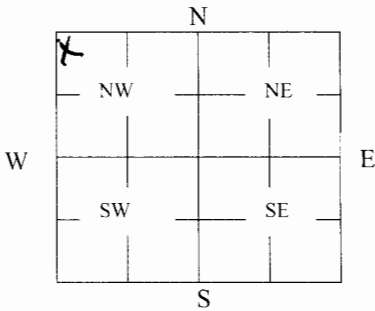

4 DEPTH OF WELL 26.70 ft.  
 WELL'S STATIC WATER LEVEL 24.62 ft MW 14

WELL WAS USED AS:

- 1 Domestic
- 2 Irrigation
- 3 Feedlot
- 4 Industrial
- 5 Public Water Supply
- 6 Oil Field Water Supply
- 7 Domestic (Lawn & Garden)
- 8 Air Conditioning
- 9 Dewatering
- 10  Monitoring
- 11 Injection Well
- 12 Other \_\_\_\_\_

Was a chemical/bacteriological sample submitted to Department? Yes \_\_\_\_\_ No

5 TYPE OF BLANK CASING USED:  
 1 Steel    3 RMP (SR)    5 Wrought    7 Fiberglass    9 Other (Specify below)  
 2 PVC    4 ABS    6 Asbestos-Cement    8 Concrete Tile

Blank casing diameter \_\_\_\_\_ in. Was casing pulled? Yes  No \_\_\_\_\_ If yes, how much 26.70  
 Casing height above or below land surface 29 in.

6 GROUT PLUG MATERIAL: 1 Neat cement    2 Cement grout     Bentonite    4 Other \_\_\_\_\_

Grout Plug Intervals: From 26.70 ft. to 1 ft., From \_\_\_\_\_ ft. to \_\_\_\_\_ ft., From \_\_\_\_\_ to \_\_\_\_\_ ft.

What is the nearest source of possible contamination:

- 1 Septic tank
  - 2 Sewer lines
  - 3 Watertight sewer lines
  - 4 Lateral lines
  - 5 Cess pool
  - 6 Seepage pit
  - 7 Pit privy
  - 8 Sewage lagoon
  - 9 Feedyard
  - 10 Livestock pens
  - 11 Fuel Storage
  - 12 Fertilizer storage
  - 13 Insecticide storage
  - 14 Abandoned water well
  - 15 Oil well/Gas well
  - 16 Other (specify below) \_\_\_\_\_
- Direction from well? \_\_\_\_\_  
 How many feet? \_\_\_\_\_

FROM	TO	PLUGGING MATERIALS	FROM	TO	PLUGGING MATERIALS
<u>26.70</u>	<u>1</u>	<u>Bentonite Chips</u>			

7 CONTRACTOR'S OR LANDOWNER'S CERTIFICATION: This water well was plugged under my jurisdiction and was completed on (mo/day/year) 9/24/07 and this record is true to the best of my knowledge and belief. Kansas Water Well Contractor's License No. 709. This Water Well Record was completed on (mo/day/year) 11-18-07 under the business name of maxs by (signature) David Huxley

INSTRUCTIONS: Use typewriter or ballpoint pen. Please press firmly and print clearly. Please fill in blanks, underline or circle the correct answers. Send top three copies to Kansas Department of Health and Environment, Bureau of Water, Geology Section, 1000 SW Jackson St., Ste. 420, Topeka, Kansas 66612-1367. Telephone: 785/296-5522. Send one to Water Well Owner and retain one for your records. Visit us at <http://www.kdheks.gov/geo/waterwells>.