

CORRECTION(S) TO WATER WELL RECORD (WWC-5)

(to rectify lacking or incorrect information)

County: Wyandotte

Location listed as:

Location changed to:

Section-Township-Range: 34-10S-25E

34-10S-25E

Fraction ($\frac{1}{4}$ $\frac{1}{4}$ $\frac{1}{4}$): SE SE SW

SW SE SE

Other changes: Initial statements: _____

Changed to: _____

Comments: _____

verification method: Legal description, position on plat map,
and North Kansas City 1:24,000 topo. map.

initials: DRL date: 1/28/2008


1 LOCATION OF WATER WELL: Fraction SE 1/4 SE 1/4 SW 4 Section Number 34 Township Number T10S Range Number R250E
 County: Wyandotte

Distance and direction from nearest town or city street address of well if located within city?

Fairfax

2 WATER WELL OWNER: Conoco Phillips **Global Positioning Systems** (decimal degrees, min. of 4 digits)
 RR#, St. Address, Box #: 2029 Fairfax Trafficway Latitude: _____
 City, State ZIP Code: KC KS 66115 Longitude: _____
 Elevation: _____
 Datum: _____
 Data Collection Method: _____

3 MARK WELL'S LOCATION WITH AN "X" IN SECTION BOX:

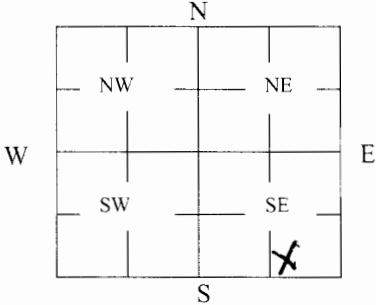

4 DEPTH OF WELL 20.39 ft.
 WELL'S STATIC WATER LEVEL 18.53 ft MW 66

- WELL WAS USED AS:
- | | | |
|--------------|----------------------------|----------------------------|
| 1 Domestic | 5 Public Water Supply | 9 Dewatering |
| 2 Irrigation | 6 Oil Field Water Supply | 10 Monitoring |
| 3 Feedlot | 7 Domestic (Lawn & Garden) | 11 Injection Well |
| 4 Industrial | 8 Air Conditioning | 12 Other <u>piezometer</u> |

Was a chemical/bacteriological sample submitted to Department? Yes _____ No

5 TYPE OF BLANK CASING USED:

1 Steel	3 RMP (SR)	5 Wrought	7 Fiberglass	9 Other (Specify below)
<input checked="" type="radio"/> PVC	4 ABS	6 Asbestos-Cement	8 Concrete Tile	

Blank casing diameter 2 in. Was casing pulled? Yes No _____ If yes, how much 20.39
 Casing height above or below land surface 29 in.

6 GROUT PLUG MATERIAL: 1 Neat cement 2 Cement grout Bentonite 4 Other _____

Grout Plug Intervals: From 20.39 ft. to 1 ft., From _____ ft. to _____ ft., From _____ to _____ ft.

- What is the nearest source of possible contamination:
- | | | | |
|--------------------------|-------------------|---|----------------------------|
| 1 Septic tank | 6 Seepage pit | <input checked="" type="radio"/> Fuel Storage | 16 Other (specify below) |
| 2 Sewer lines | 7 Pit privy | 12 Fertilizer storage | |
| 3 Watertight sewer lines | 8 Sewage lagoon | 13 Insecticide storage | |
| 4 Lateral lines | 9 Feedyard | 14 Abandoned water well | Direction from well? _____ |
| 5 Cess pool | 10 Livestock pens | 15 Oil well/Gas well | How many feet? _____ |

FROM	TO	PLUGGING MATERIALS	FROM	TO	PLUGGING MATERIALS
<u>20.39</u>	<u>1</u>	<u>Bentonite chips</u>			

7 CONTRACTOR'S OR LANDOWNER'S CERTIFICATION: This water well was plugged under my jurisdiction and was completed on (mo/day/year) 9/28/07 and this record is true to the best of my knowledge and belief. Kansas Water Well Contractor's License No. 704. This Water Well Record was completed on (mo/day/year) 11/18-07 under the business name of Max's by (signature) David Nuyh

INSTRUCTIONS: Use typewriter or ballpoint pen. Please press firmly and print clearly. Please fill in blanks, underline or circle the correct answers. Send top three copies to Kansas Department of Health and Environment, Bureau of Water, Geology Section, 1000 SW Jackson St., Ste. 420, Topeka, Kansas 66612-1367. Telephone: 785/296-5522. Send one to Water Well Owner and retain one for your records. Visit us at <http://www.kdheks.gov/geo/waterwells>.