


WATER WELL RECORD Form WWC-5 KSA 82a-1212

1 LOCATION OF WATER WELL: County: Wyandotte	Fraction NE ¼ NW ¼ SE ¼	Section Number 34	Township Number T 10 S	Range Number R 25 (E/W)
---	-----------------------------------	-----------------------------	----------------------------------	--

Distance and direction from nearest town or city street address of well if located within city?
~425' S of Donovan & 175' W of Fairfax, Kans. City

2 WATER WELL OWNER: RR#, St. Address, Box # : City, State, ZIP Code :	Magellan Midstream Partners LP One Williams Center MD-30-8 Tulsa, OK 74172	Board of Agriculture, Division of Water Resources Application Number:
---	---	--

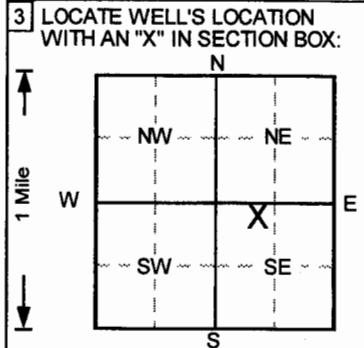

4 DEPTH OF COMPLETED WELL 35 ft. ELEVATION:
Depth(s) Groundwater Encountered 1. ft. 2. ft. 3. ft.
WELL'S STATIC WATER LEVEL ft. below land surface measured on mo/day/yr
Pump test data: Well water was NA ft. after hours pumping gpm
Est. Yield NA gpm: Well water was ft. after hours pumping gpm
Bore Hole Diameter 8 in. to 35 ft., and in. to ft.
WELL WATER TO BE USED AS:
5 Public water supply 8 Air conditioning 11 Injection well
1 Domestic 3 Feedlot 6 Oil field water supply 9 Dewatering 12 Other (Specify below)
2 Irrigation 4 Industrial 7 Lawn and garden only 10 Monitoring well
Was a chemical/bacteriological sample submitted to Department? Yes.....No <input checked="" type="checkbox"/> ..; If yes, mo/day/yr sample was submitted
Water Well Disinfected? Yes No <input checked="" type="checkbox"/>

5 TYPE OF BLANK CASING USED:	5 Wrought iron	8 Concrete tile	CASING JOINTS: Glued Clamped
1 Steel	3 RMP (SR)	6 Asbestos-Cement	9 Other (specify below) Welded
2 PVC	4 ABS	7 Fiberglass Threaded. <input checked="" type="checkbox"/>
Blank casing diameter 2 in. to 15 ft., Dia in. to ft., Dia in. to ft.			
Casing height above land surface 5 in., weight lbs./ft. Wall thickness or gauge No. Sch. 40			
TYPE OF SCREEN OR PERFORATION MATERIAL	7 PVC	10 Asbestos-cement	
1 Steel	3 Stainless steel	5 Fiberglass	8 RMP (SR)
2 Brass	4 Galvanized steel	6 Concrete tile	9 ABS
11 Other (specify)			12 None used (open hole)
SCREEN OR PERFORATION OPENINGS ARE:	5 Gauzed wrapped	8 Saw cut	11 None (open hole)
1 Continuous slot	3 Mill slot	6 Wire wrapped	9 Drilled holes
2 Louvered shutter	4 Key punched	7 Torch cut	10 Other (specify)
SCREEN-PERFORATED INTERVALS: From 15 ft. to 35 ft., From ft. to ft.			
GRAVEL PACK INTERVALS: From 13 ft. to 35 ft., From ft. to ft.			

6 GROUT MATERIAL:	1 Neat cement	2 Cement grout	3 Bentonite	4 Other Concrete
Grout Intervals: From 0 ft. to 1 ft., From 1 ft. to 15 ft., From ft. to ft.				
What is the nearest source of possible contamination:	1 Septic tank	4 Lateral lines	7 Pit privy	10 Livestock pens
	2 Sewer lines	5 Cess pool	8 Sewage lagoon	11 Fuel storage
	3 Watertight sewer lines	6 Seepage pit	9 Feedyard	12 Fertilizer storage
				13 Insecticide storage
Direction from well?				14 Abandoned water well
				15 Oil well/Gas well
				16 Other (specify below)
				How many feet?

FROM	TO	LITHOLOGIC LOG	FROM	TO	PLUGGING INTERVALS
0	0.5	Gravel,			
0.5	7.5	Clay, some silt, Very Dark Gray			
7.5	35	Sand, some silt, Very Dark Gray			
					OBS-1, Flushmount
					Project Name: BM - Mile Marker #1
					GeoCore # 1040 , #

7 CONTRACTOR'S OR LANDOWNER'S CERTIFICATION: This water well was **(1)** constructed, (2) reconstructed, or (3) plugged under my jurisdiction and was completed on (mo/day/year) **9/19/2007** and this record is true to the best of my knowledge and belief.
Kansas Water Well Contractor's License No. **527** This Water Well Record was completed on (mo/day/yr) **9/19/07**
under the business name of **GeoCore, Inc.** by (signature) *Joe Bell*

INSTRUCTIONS: Use typewriter or ball point pen. **PLEASE PRESS FIRMLY and PRINT** clearly. Please fill in blanks, underline or circle the correct answers. Send top three copies to Kansas Department of Health and Environment, Bureau of Water, Topeka, Kansas 66620-0001. Telephone: 913-296-5545. Send one to WATER WELL OWNER and retain one for your records.