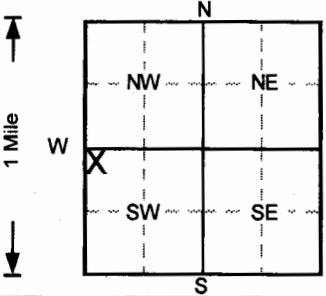


1 LOCATION OF WATER WELL: County: Wyandotte	Fraction NW ¼ NW ¼ SW ¼	Section Number 28	Township Number T 10 S	Range Number R 25 (E/W)
---	-----------------------------------	-----------------------------	----------------------------------	--

Distance and direction from nearest town or city street address of well if located within city?

3601 N. 12th Street, Kansas City

2 WATER WELL OWNER: Magellan Midstream Partners LP RR#, St. Address, Box # : One Williams Center MD-30-8 City, State, ZIP Code : Tulsa, OK 74172	Board of Agriculture, Division of Water Resources Application Number:
---	--

3 LOCATE WELL'S LOCATION WITH AN "X" IN SECTION BOX: 	4 DEPTH OF COMPLETED WELL: 30 ft. ELEVATION: Depth(s) Groundwater Encountered 1: ft. 2: ft. 3: ft. WELL'S STATIC WATER LEVEL ft. below land surface measured on mo/day/yr Pump test data: Well water was NA ft. after hours pumping gpm Est. Yield NA gpm: Well water was ft. after hours pumping gpm Bore Hole Diameter 8 in. to 30.5 ft., and in. to ft. WELL WATER TO BE USED AS: 5 Public water supply 8 Air conditioning 11 Injection well 1 Domestic 3 Feedlot 6 Oil field water supply 9 Dewatering 12 Other (Specify below) 2 Irrigation 4 Industrial 7 Lawn and garden only 10 Monitoring well Was a chemical/bacteriological sample submitted to Department? Yes.....No <input checked="" type="checkbox"/> ; If yes, mo/day/yr sample was submitted Water Well Disinfected? Yes No <input checked="" type="checkbox"/>
--	---

5 TYPE OF BLANK CASING USED: 1 Steel 3 RMP (SR) 5 Wrought iron 8 Concrete tile 2 PVC 4 ABS 6 Asbestos-Cement 9 Other (specify below) 7 Fiberglass Blank casing diameter 2 in. to 15 ft., Dia in. to ft., Dia in. to ft. Casing height above land surface in., weight lbs./ft. Wall thickness or gauge No. Sch. 40	CASING JOINTS: Glued Clamped Welded Threaded. <input checked="" type="checkbox"/>
TYPE OF SCREEN OR PERFORATION MATERIAL 1 Steel 3 Stainless steel 5 Fiberglass 7 PVC 10 Asbestos-cement 2 Brass 4 Galvanized steel 6 Concrete tile 8 RMP (SR) 11 Other (specify) 12 None used (open hole)	SCREEN OR PERFORATION OPENINGS ARE: 1 Continuous slot 3 Mill slot 5 Gauzed wrapped 8 Saw cut 11 None (open hole) 2 Louvered shutter 4 Key punched 6 Wire wrapped 9 Drilled holes 7 Torch cut 10 Other (specify)
SCREEN-PERFORATED INTERVALS: From 15 ft. to 30 ft., From ft. to ft. From ft. to ft., From ft. to ft.	GRAVEL PACK INTERVALS: From 13 ft. to 30.5 ft., From ft. to ft. From ft. to ft., From ft. to ft.

6 GROUT MATERIAL: 1 Neat cement 2 Cement grout 3 Bentonite 4 Other Concrete	Grout Intervals: From 0 ft. to 2 ft., From 2 ft. to 15 ft., From ft. to ft.
What is the nearest source of possible contamination: 1 Septic tank 4 Lateral lines 7 Pit privy 10 Livestock pens 14 Abandoned water well 2 Sewer lines 5 Cess pool 8 Sewage lagoon 11 Fuel storage 15 Oil well/Gas well 3 Watertight sewer lines 6 Seepage pit 9 Feedyard 12 Fertilizer storage 16 Other (specify below) 13 Insecticide storage	Direction from well? How many feet?

FROM	TO	LITHOLOGIC LOG	FROM	TO	PLUGGING INTERVALS
0	0.25	Grass,			
0.25	1	Silt, coal dust, and fragments, Black			
1	5.5	Clay, some silt, Dark Yellowish Brown			
5.5	8.5	Clay, tr. to some silt, Dark Gray			
8.5	11	Silt, tr. to some sand and clay, Brown			
11	14	Silt, tr. to some sand,			
14	20	Silt, some sand, tr. clay, Brown			
20	24.5	Sand (f), Lt. Olive Brown			
24.5	30.5	Sand (f-c), Lt. Olive Brown			
					MW15, Flushmount
					Project Name: BM - Quindaro
					GeoCore # 1472 , #

7 CONTRACTOR'S OR LANDOWNER'S CERTIFICATION: This water well was (1) constructed, (2) reconstructed, or (3) plugged under my jurisdiction and was completed on (mo/day/year) 6/18/2008 and this record is true to the best of my knowledge and belief. Kansas Water Well Contractor's License No. 527 This Water Well Record was completed on (mo/day/yr) 7/10/08 under the business name of GeoCore, Inc. by (signature) <i>Dale Paul</i>

OFFICE USE ONLY
T
R
EW
SEC.