


1 LOCATION OF WATER WELL: Fraction NE 1/4 NE 1/4 SW 1/4 Section Number 34 Township Number T 10 S Range Number R 25 EW

Distance and direction from nearest town or city street address of well if located within city? 39 Stanley Rd., Kansas City

2 WATER WELL OWNER: Magellan Pipeline Company, LP
RR#, St. Address, Box #: One Williams Center
City, State, ZIP Code: Tulsa, OK 74172
Board of Agriculture, Division of Water Resources
Application Number:

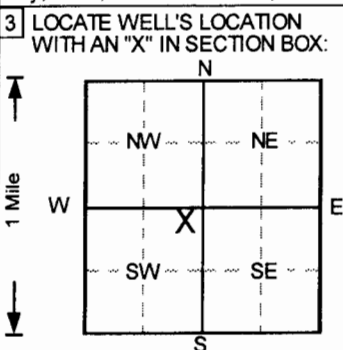

3 LOCATE WELL'S LOCATION WITH AN 'X' IN SECTION BOX:
4 DEPTH OF COMPLETED WELL . . . 26.47 . . . ft. ELEVATION:
Depth(s) Groundwater Encountered 1. . . . ft. 2. . . . ft. 3. . . . ft.
WELL'S STATIC WATER LEVEL . . . . ft. below land surface measured on mo/day/yr
Pump test data: Well water was . . . NA . . . ft. after . . . . hours pumping . . . . gpm
Est. Yield . . NA . . gpm: Well water was . . . . ft. after . . . . hours pumping . . . . gpm
Bore Hole Diameter . . 9.25 . . in. to . . 26.96 . . ft., and . . . . in. to . . . . ft.
WELL WATER TO BE USED AS: 5 Public water supply 8 Air conditioning 11 Injection well
1 Domestic 3 Feedlot 6 Oil field water supply 9 Dewatering 12 Other (Specify below)
2 Irrigation 4 Industrial 7 Lawn and garden only 10 Monitoring well . . . . Observation well . . .
Was a chemical/bacteriological sample submitted to Department? Yes.....No✓; If yes, mo/day/yr sample was submitted
Water Well Disinfected? Yes No✓

5 TYPE OF BLANK CASING USED: 1 Steel 2 PVC 3 RMP (SR) 4 ABS 5 Wrought iron 6 Asbestos-Cement 7 Fiberglass 8 Concrete tile 9 Other (specify below) CASING JOINTS: Glued . . . . Clamped . . . . Welded . . . . Threaded. ✓
Blank casing diameter . . . 2 . . . in. to . . 11.27 . . ft, Dia . . 2 . . in. to . . 26.47 . . ft, Dia . . . . in. to . . . . ft
Casing height above land surface . . . 0 . . . in., weight . . . . lbs./ft. Wall thickness or gauge No. . . Sch. 40
TYPE OF SCREEN OR PERFORATION MATERIAL 1 Steel 2 Brass 3 Stainless steel 4 Galvanized steel 5 Fiberglass 6 Concrete tile 7 PVC 8 RMP (SR) 9 ABS 10 Asbestos-cement 11 Other (specify) 12 None used (open hole)
SCREEN OR PERFORATION OPENINGS ARE: 1 Continuous slot 2 Louvered shutter 3 Mill slot 4 Key punched 5 Gauzed wrapped 6 Wire wrapped 7 Torch cut 8 Saw cut 9 Drilled holes 10 Other (specify) 11 None (open hole)
SCREEN-PERFORATED INTERVALS: From . . . 11.27 . . ft to . . 26.27 . . ft, From . . . . ft to . . . . ft
GRAVEL PACK INTERVALS: From . . . 11 . . ft to . . 26.96 . . ft, From . . . . ft to . . . . ft

6 GROUT MATERIAL: 1 Neat cement 2 Cement grout 3 Bentonite 4 Other
Grout Intervals: From . . . 0 . . ft to . . 2 . . ft, From . . 2 . . ft to . . 11 . . ft, From . . . . ft to . . . . ft
What is the nearest source of possible contamination:
1 Septic tank 2 Sewer lines 3 Watertight sewer lines 4 Lateral lines 5 Cess pool 6 Seepage pit 7 Pit privy 8 Sewage lagoon 9 Feedyard 10 Livestock pens 11 Fuel storage 12 Fertilizer storage 13 Insecticide storage 14 Abandoned water well 15 Oil well/Gas well 16 Other (specify below)
Direction from well? How many feet?

Table with 6 columns: FROM, TO, LITHOLOGIC LOG, FROM, TO, PLUGGING INTERVALS. Contains entries for Excavation (0-8 ft), Fill Sand and Gravel (8-16.5 ft), and Sand (16.5-26.96 ft). Includes 'DPVE-3, Flushmount' at the bottom.

7 CONTRACTOR'S OR LANDOWNER'S CERTIFICATION: This water well was (1) constructed, (2) reconstructed, or (3) plugged under my jurisdiction and was completed on (mo/day/year) 3/10/2010 and this record is true to the best of my knowledge and belief.
Kansas Water Well Contractor's License No. 527 This Water Well Record was completed on (mo/day/yr) 4/11/2010 under the business name of GeoCore, Inc. by (signature) Dan Holt

OFFICE USE ONLY

T

R

EM

SEC.

1/4

1/4

1/4