

WATER WELL PLUGGING RECORD Form WWC-5P

KSA 82a-1212

ID NO.

75P

1 LOCATION OF WATER WELL: County: Wyandotte	Fraction NW 1/4 NE 1/4 SE 1/4 NW 1/4	Section Number 26	Township Number T 10 S	Range Number 25 ☒ E ☐ W
--	---	----------------------	---------------------------	---

Street/Rural Address of Well Location; if unknown, distance & direction from nearest town or intersection: If at owner's address, check here ☒

Global Positioning Systems (GPS) information:

Latitude: 39.15335 (in decimal degrees)

Longitude: -94.5956 (in decimal degrees)

Elevation: 752.82


Datum: ☐ WGS84, ☒ NAD83, ☐ NAD27

Collection Method:

☒ GPS unit (Make/Model: Trimble GeoXT 2008 Series)☐ Digital Map/Photo, ☐ Topographic Map, ☐ Land SurveyEst. Accuracy: ☒ < 3 m, ☐ 3-5 m, ☐ 5-15 m, ☐ > 15 m

2 WATER WELL OWNER: Fairfax Drainage District
RR#, St. Address, Box #: 1620 Fairfax Trafficway
City, State ZIP Code: Kansas City, KS 66115

3 MARK WELL'S LOCATION WITH AN "X" IN SECTION BOX:

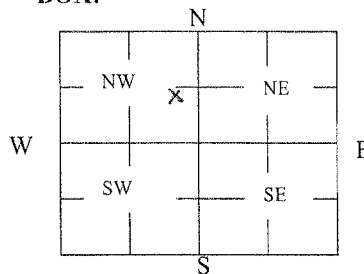

4 DEPTH OF WELL 101.48 ft.

WELL'S STATIC WATER LEVEL 32.5 ft

WELL WAS USED AS:

☐ Domestic
☐ Irrigation
☐ Feedlot
☐ Industrial

☐ Public Water Supply
☐ Oil Field Water Supply
☐ Domestic (Lawn & Garden)
☐ Air Conditioning

☐ Dewatering
☐ Monitoring
☒ Injection Well
☒ Other Relief Well
Was a chemical/bacteriological sample submitted to Department? Yes ☐ No ☒

5 TYPE OF BLANK CASING USED:

☒ Steel ☐ RMP (SR) ☐ Wrought ☐ Fiberglass ☐ Other (Specify below)
☐ PVC ☐ ABS ☐ Asbestos-Cement ☐ Concrete Tile

Blank casing diameter _____ in. Was casing pulled? Yes ☐ No ☒ If yes, how much _____
 Casing height above or below land surface (22.09) in. ft.

6 GROUT PLUG MATERIAL: ☐ Neat cement ☒ Cement grout ☐ Bentonite ☐ Other _____

Grout Plug Intervals: From 22.09 ft. to 45.49 ft., From _____ ft. to _____ ft., From _____ to _____ ft.

What is the nearest source of possible contamination:

☐ Septic tank	☐ Seepage pit	☐ Fuel Storage	☒ Other (specify below) Underground Hydrocarbons from Old Refinery
☐ Sewer lines	☐ Pit privy	☐ Fertilizer storage	
☐ Watertight sewer lines	☐ Sewage lagoon	☐ Insecticide storage	
☐ Lateral lines	☐ Feedyard	☐ Abandoned water well	
☐ Cess pool	☐ Livestock pens	☐ Oil well/Gas well	

Direction from well? Southwest
 How many feet? 8500

FROM	TO	PLUGGING MATERIALS	FROM	TO	PLUGGING MATERIALS
22.09	45.49	Cement Grout			
45.49	101.48	Chlorinated Silica Sand			

7 CONTRACTOR'S OR LANDOWNER'S CERTIFICATION: This water well was plugged under my jurisdiction and was completed on (mo/day/year) 2/15/2011 and this record is true to the best of my knowledge and belief. Kansas Water Well Contractor's License No. _____. This Water Well Record was completed on (mo/day/year) 04/16/2012 under the business name of Fairfax Drainage District by (signature) Stephen P. Daily P.E.

INSTRUCTIONS: Use typewriter or ballpoint pen. Please press firmly and print clearly. Please fill in blanks, underline or circle the correct answers. Send top three copies to Kansas Department of Health and Environment, Bureau of Water, Geology Section, 1000 SW Jackson St., Ste. 420, Topeka, Kansas 66612-1367. Telephone: 785/296-5524. Send one to Water Well Owner and retain one for your records. Visit us at <http://www.kdheks.gov/waterwell/index.html>.

Check one: ☐ White Copy ☐ Blue Copy ☐ Pink Copy