# WATER WELL PLUGGING RECORD Form WWC-5P KSA 82a-1212 ID NO. 96P

**1 LOCATION OF WATER WELL:** County: Wyandotte | Fraction: SW ¼ SE ¼ NW ¼ NW ¼ | Section Number: 26 | Township Number: T 10 S | Range Number: 25 ☑ E ☐ W

Street/Rural Address of Well Location; if unknown, distance & direction from nearest town or intersection: If at owner's address, check here ☑

**Global Positioning Systems (GPS) information:**
Latitude: 39.15457 (in decimal degrees)
Longitude: -94.6003 (in decimal degrees)
Elevation: 752.77
Datum: ☐ WGS84, ☑ NAD83, ☐ NAD27
Collection Method:
☑ GPS unit (Make/Model: Trimble GeoXT 2008 Series
☐ Digital Map/Photo, ☐ Topographic Map, ☐ Land Survey
Est. Accuracy: ☑ < 3 m, ☐ 3-5 m, ☐ 5-15 m, ☐ > 15 m

**2 WATER WELL OWNER:** Fairfax Drainage District
RR#, St. Address, Box #: 1620 Fairfax Trafficway
City, State ZIP Code: Kansas City, KS 66115

**3 MARK WELL'S LOCATION WITH AN "X" IN SECTION BOX:**

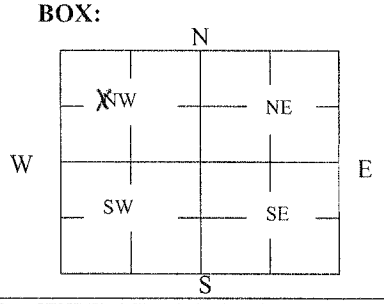


**4 DEPTH OF WELL** 100.90 ft.
WELL'S STATIC WATER LEVEL 29.3 ft
WELL WAS USED AS:

| | | |
|---|---|---|
| ☐ Domestic | ☐ Public Water Supply | ☐ Dewatering |
| ☐ Irrigation | ☐ Oil Field Water Supply | ☐ Monitoring |
| ☐ Feedlot | ☐ Domestic (Lawn & Garden) | ☐ Injection Well |
| ☐ Industrial | ☐ Air Conditioning | ☑ Other Relief Well |

Was a chemical/bacteriological sample submitted to Department? Yes ☐ No ☑

**5 TYPE OF BLANK CASING USED:**

☑ Steel ☐ PVC ☐ RMP (SR) ☐ ABS ☐ Wrought ☐ Asbestos-Cement ☐ Fiberglass ☐ Concrete Tile ☐ Other (Specify below) _____

Blank casing diameter _____ in. Was casing pulled? Yes ☐ No ☑ If yes, how much _____
Casing height above or below land surface (20.65) ~~in.~~ ft.

**6 GROUT PLUG MATERIAL:** ☐ Neat cement ☑ Cement grout ☐ Bentonite ☐ Other _____

Grout Plug Intervals: From 20.65 ft. to 42.65 ft., From _____ ft. to _____ ft., From _____ to _____ ft.

What is the nearest source of possible contamination:

| | | | |
|---|---|---|---|
| ☐ Septic tank | ☐ Seepage pit | ☐ Fuel Storage | ☑ Other (specify below) |
| ☐ Sewer lines | ☐ Pit privy | ☐ Fertilizer storage | Underground Hydrocarbons from Old Refinery |
| ☐ Watertight sewer lines | ☐ Sewage lagoon | ☐ Insecticide storage | |
| ☐ Lateral lines | ☐ Feedyard | ☐ Abandoned water well | Direction from well? South |
| ☐ Cess pool | ☐ Livestock pens | ☐ Oil well/Gas well | How many feet? 8700 |

| FROM | TO | PLUGGING MATERIALS | FROM | TO | PLUGGING MATERIALS |
|---|---|---|---|---|---|
| 20.65 | 42.65 | Cement Grout | | | |
| 42.65 | 100.90 | Chlorinated Silica Sand | | | |
| | | | | | |
| | | | | | |
| | | | | | |
| | | | | | |
| | | | | | |

**7 CONTRACTOR'S OR LANDOWNER'S CERTIFICATION:** This water well was plugged under my jurisdiction and was completed on (mo/day/year) 2/17/2011 and this record is true to the best of my knowledge and belief. Kansas Water Well Contractor's License No. _____. This Water Well Record was completed on (mo/day/year) 04/16/2012 under the business name of Fairfax Drainage District by (signature) Stephen P. Dailey P.E.

**INSTRUCTIONS:** Use typewriter or ballpoint pen. Please press firmly and print clearly. Please fill in blanks, underline or circle the correct answers. Send top three copies to Kansas Department of Health and Environment, Bureau of Water, Geology Section, 1000 SW Jackson St., Ste. 420, Topeka, Kansas 66612-1367. Telephone: 785/296-5524. Send one to Water Well Owner and retain one for your records. Visit us at http://www.kdheks.gov/waterwell/index.html.

Check one: ☐ White Copy ☐ Blue Copy ☐ Pink Copy