

MW 401 S

WATER WELL RECORD


Form WWC-5

Division of Water Resources App. No.

1 LOCATION OF WATER WELL: County: Wyandotte Fraction 1/4 NE 1/4 SW 1/4 SW 1/4 Section Number 15 Township No. T 10 S Range Number R 25 [X]E [ ]W

Street/Rural Address of Well Location: if unknown, distance & direction from nearest town or intersection: If at owner's address, check here [X]. Global Positioning System (GPS) information: Latitude: 39.1372 Longitude: 94.5950

2 WATER WELL OWNER: Maqellan RR#, Street Address, Box #: 401 E. Donovan Rd. City, State, ZIP Code : Kansas City, KS 66215

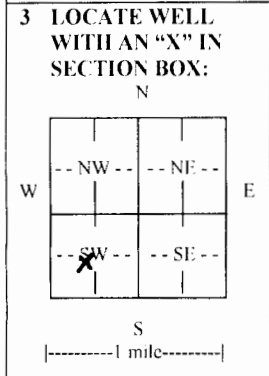

4 DEPTH OF COMPLETED WELL: Depth(s) Groundwater Encountered (1) 19 ft. (2) 19 ft. (3) 19 ft. WELL'S STATIC WATER LEVEL 19 ft. below land surface measured on mo/day/yr. 4/17/12

5 TYPE OF CASING USED: [ ] Steel [X] PVC [ ] Other CASING JOINTS: [ ] Glued [ ] Clamped [ ] Welded [X] Threaded

TYPE OF SCREEN OR PERFORATION MATERIAL: [ ] Steel [ ] Stainless Steel [X] PVC [ ] Other (Specify) [ ] Brass [ ] Galvanized Steel [ ] None used (open hole)

6 GROUT MATERIAL: [ ] Neat cement [ ] Cement grout [X] Bentonite [ ] Other Grout Intervals: From 22 ft. to 2 ft.

Table with columns: FROM, TO, LITHOLOGIC LOG, FROM, TO, LITHO. LOG (cont.) or PLUGGING INTERVALS. Row 1: 0 to 8 Silty Clay. Row 2: 8 to 37 Sand.

7 CONTRACTOR'S OR LANDOWNER'S CERTIFICATION: This water well was [X] constructed, [ ] reconstructed, or [ ] plugged under my jurisdiction and was completed on (mo/day/year) 4/17/12

INSTRUCTIONS: Use typewriter or ball point pen. PLEASE PRESS FIRMLY and PRINT clearly. Please fill in blanks and check the correct answers. Send three copies (white, blue, pink) to Kansas Department of Health and Environment, Bureau of Water, Geology Section, 1000 SW Jackson St., Suite 420, Topeka, Kansas 66612-1367.